
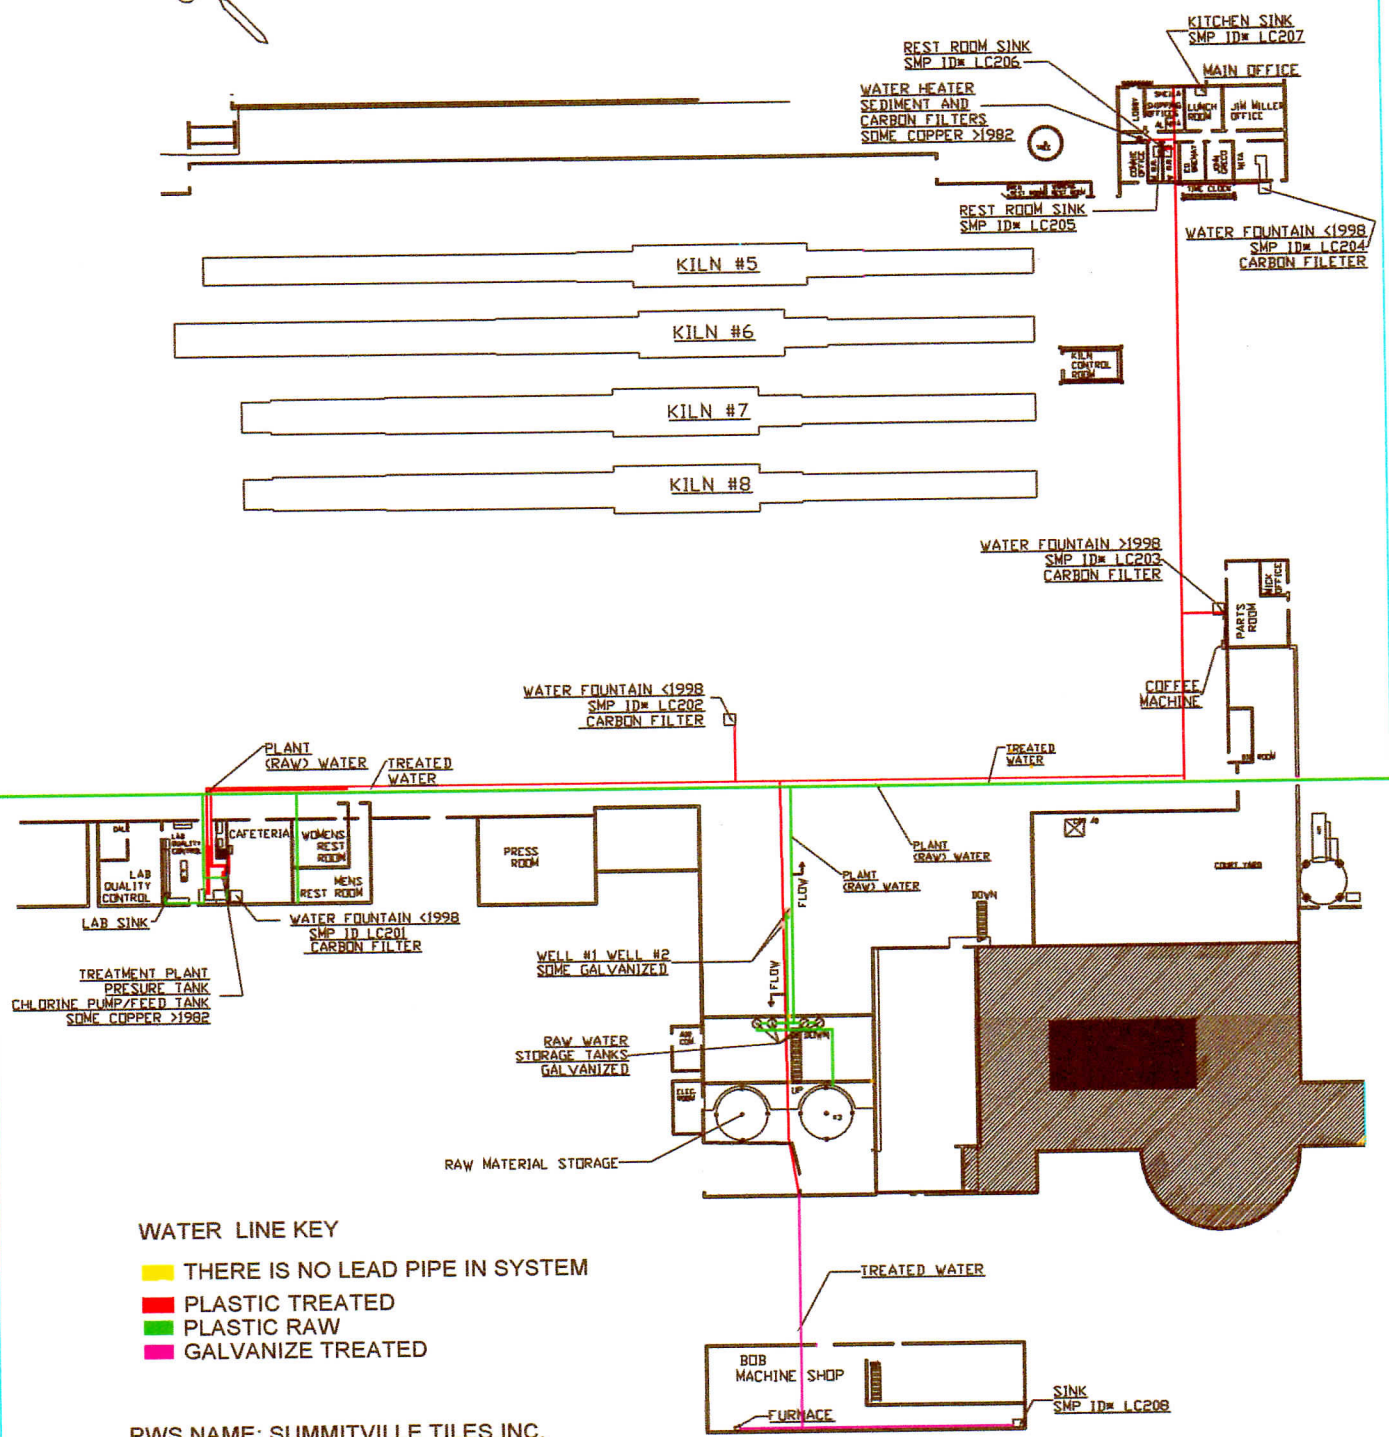


SUMMITVILLE TILES, INC.
LEAD MAPPING IN DISTRIBUTION SYSTEMS
FOR BUILDINGS WITH LEAD PIPING, SOLDER OR FIXTURES

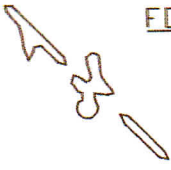

- WATER LINE KEY**
- THERE IS NO LEAD PIPE IN SYSTEM
 - PLASTIC TREATED
 - PLASTIC RAW
 - GALVANIZE TREATED

PWS NAME: SUMMITVILLE TILES, INC.
1310 ALLIANCE ROAD NW
MINERVA OHIO 44657

PWS ID. : 1039112
STU ID. : 1053128

JIM MILLER 3-03-17 330-868-6771
CONTACT DATE PHONE

*sent to Beth Madis 3-3-17
via e-mail jmm*