

**SUNDAY CREEK VALLEY WATER DISTRICT  
15945 SECOND STREET  
MILLFIELD, OHIO 45761  
(740)797-2566**

2017 MAR -6 AM 11:10

March 3, 2017

To: OHIO EPA-Division of Drinking and Ground Waters

From: Sunday Creek Valley Water District

PWS ID 501503

To whom it may concern:

Sunday Creek Valley Water District has no lead water pipes and no lead service lines.

Also at this time there are no known customer lead pipes.

Sincerely,



Charles Patton, Jr., President  
Sunday Creek Valley Water District

scvwd123@hotmail.com

Google Maps



Imagery ©2017 Google, Map data ©2017 Google 50 ft



LC201



Glouster, OH 45732

2017 MAR -5 AM 11:10

Google Maps



Imagery ©2017 Google, Map data ©2017 Google 50 ft



LC202



Glouster, OH 45732

2017 MAR -6 AM 11:10

Google Maps



Google

Imagery ©2017 Google, Map data ©2017 Google 50 ft



LC203



Glouster, OH 45732

2017 MAR - 6 AM 11:10

Google Maps



Imagery ©2017 Google, Map data ©2017 Google 50 ft



LC204



Millfield, OH 45761

2017 MAR -6 AM 11:10

Google Maps



Imagery ©2017 Google, Map data ©2017 Google 50 ft



LC205



Glouster, OH 45732

2017 MAR -5 AM 11:10

Google Maps



Imagery ©2017 Google, Map data ©2017 Google 50 ft



LC 206



Millfield, OH 45761

2017 MAR -6 AM 11:18

LC 206

Google Maps



Imagery ©2017 Google, Map data ©2017 Google 100 ft



LC207



Millfield, OH 45761

2017 MAR -5 AM 11:10

7 PM



Google Maps



Imagery ©2017 Google, Map data ©2017 Google 50 ft



LC 208



Millfield, OH 45761

At this location

2017 MAR - 6 AM 11: 10

Google Maps



Imagery ©2017 Google, Map data ©2017 Google 50 ft



LC209

Millfield, OH 45761

2017 MAR -6 AM 11:10

Google Maps



Imagery ©2017 Google, Map data ©2017 Google 50 ft



LC 210



Millfield, OH 45761

2017 MAR -5 AM 11:10

Google Maps



Imagery ©2017 Google, Map data ©2017 Google 50 ft



LC211



Millfield, OH 45761

2017 MAR -5 AM 11:10

Google Maps



Imagery ©2017 Google, Map data ©2017 Google 50 ft



LC 212



Millfield, OH 45761

2017 MAR -6 AM 11:10


Google Maps



Imagery ©2017 Google, Map data ©2017 Google 50 ft



LC 213

 

Millfield, OH 45761

2017 MAR -6 AM 11:10

Google Maps



Imagery ©2017 Google, Map data ©2017 Google 50 ft



LC214

2017 MAR -6 AM 11:11

S 11:11



Millfield, OH 45761

Google Maps



Imagery ©2017 Google, Map data ©2017 Google 50 ft



LC 215



2017 MAR - 6 AM 11:11



Google Maps



Imagery ©2017 Google, Map data ©2017 Google 50 ft



LC 216

2017 MAR -5 AM 11:11



Athens, OH 45701

Google Maps



Imagery ©2017 Google, Map data ©2017 Google 50 ft



Athens, OH 45701

LC217


2017 MAR - 6 AM 11: 11

5 10 15

Google Maps



Imagery ©2017 Google, Map data ©2017 Google 100 ft

 

Athens, OH 45701

LC 218

2017 MAR -6 AM 11: 11

5/20/17

Google Maps



Google

Imagery ©2017 Google, Map data ©2017 Google 50 ft



LC 219



Athens, OH 45701

2017 MAR -6 AM 11:11

5 PM 0


Google Maps



Imagery ©2017 Google, Map data ©2017 Google 50 ft



LC220

 


Millfield, OH 45761

2017 MAR - 5 AM 11:11

5070  
7270

TRIMBLE TWP.

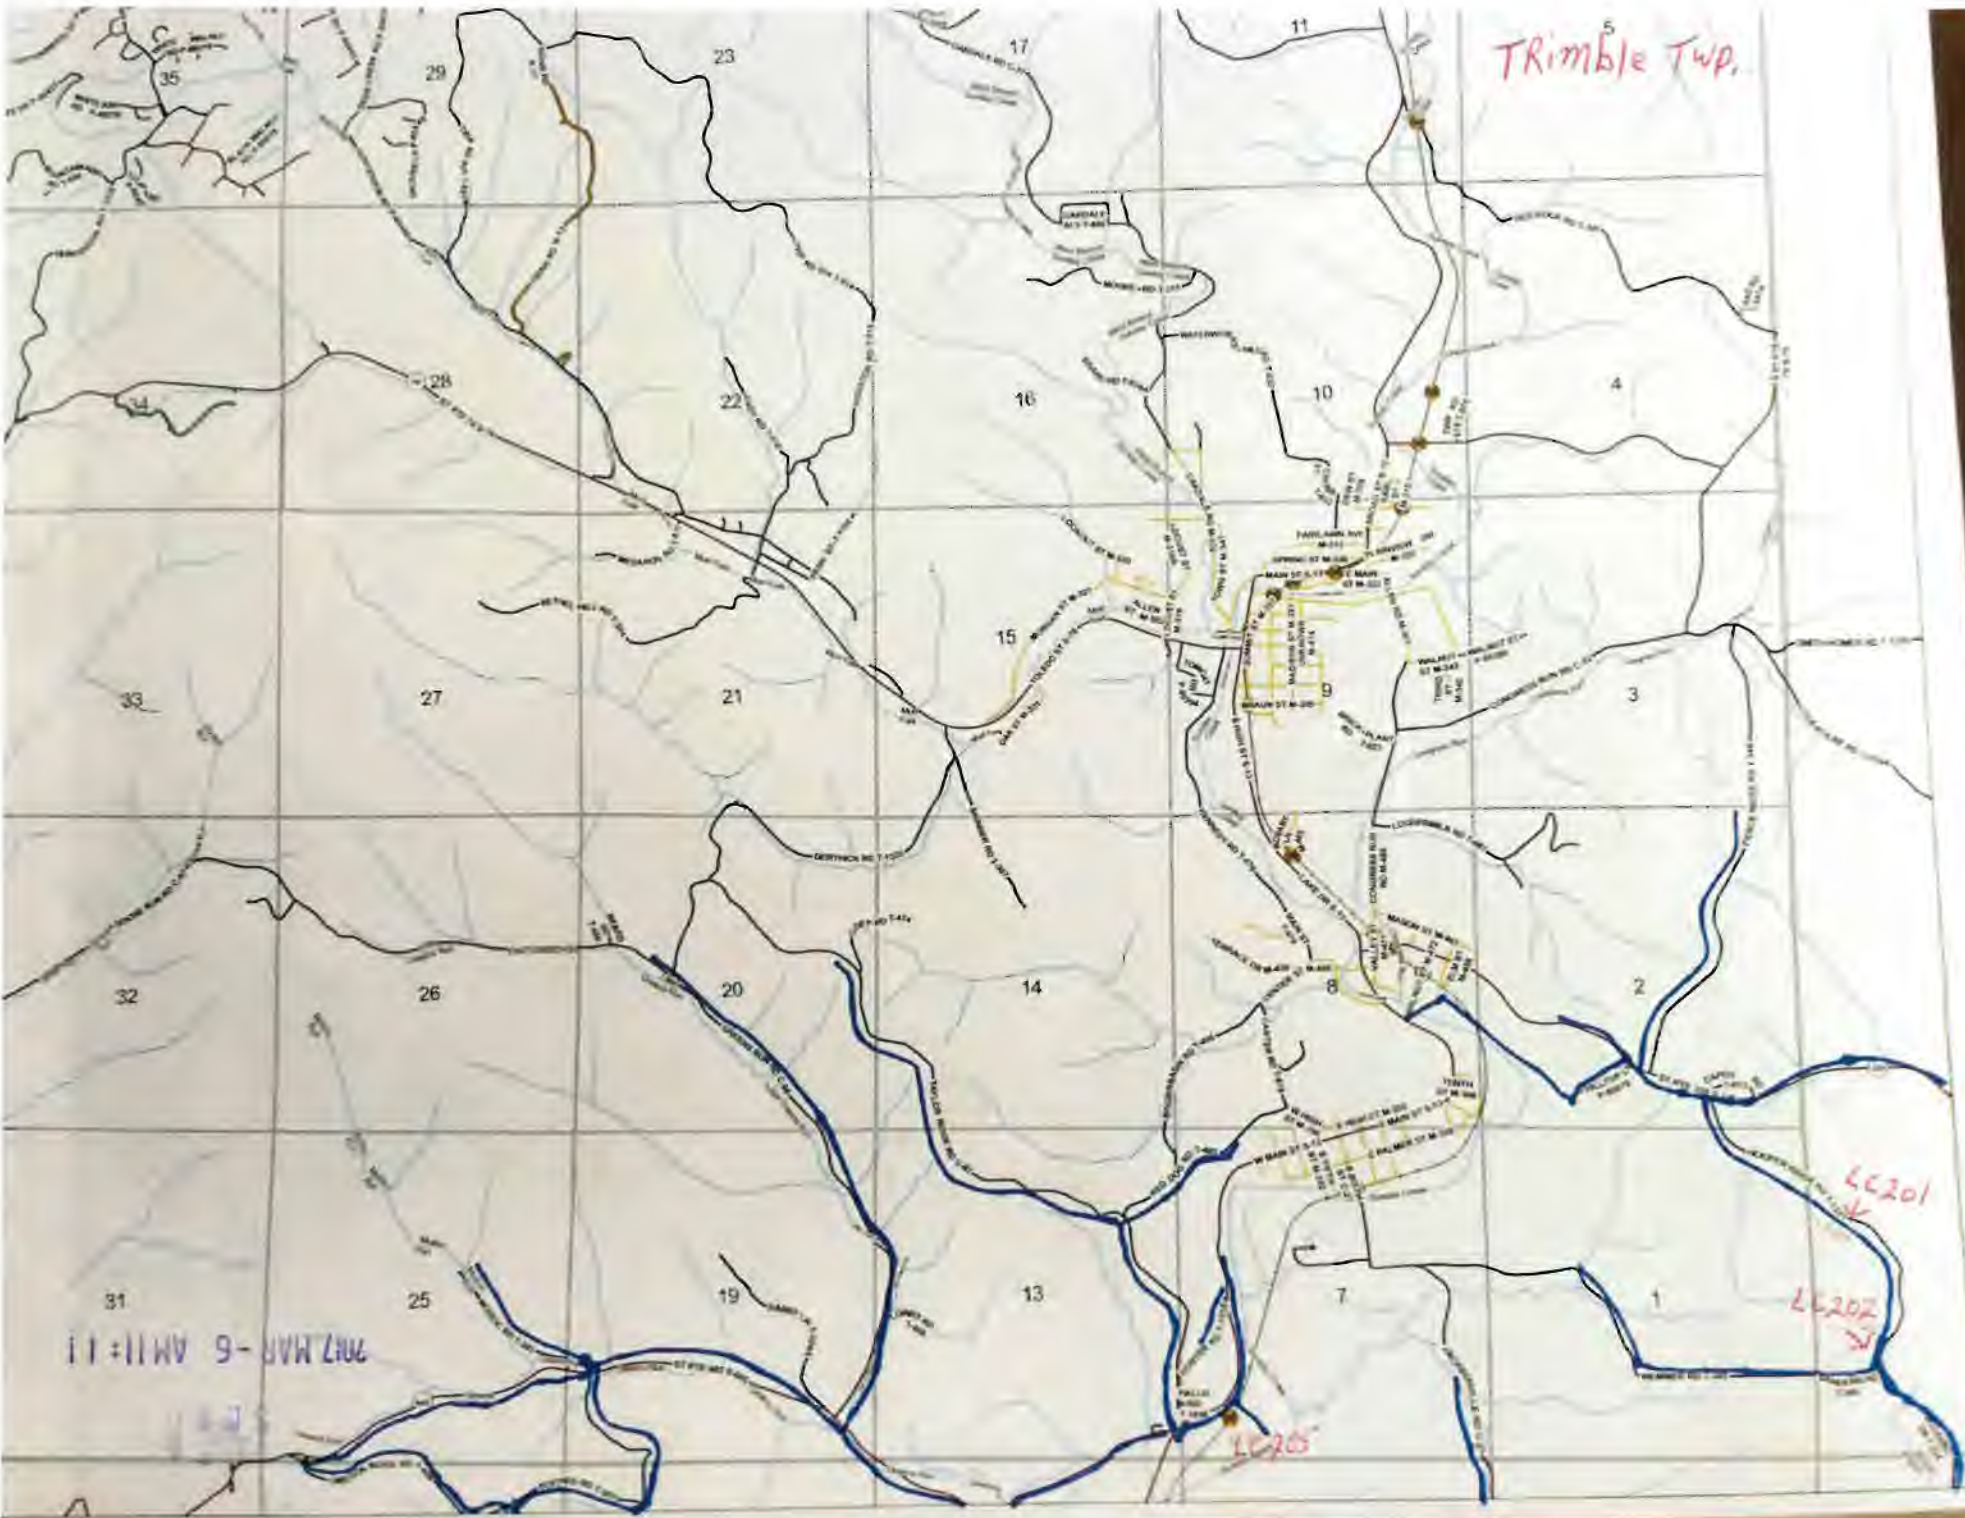


2017 MAR -6 AM 11:11

LC201  
LC202

LC205



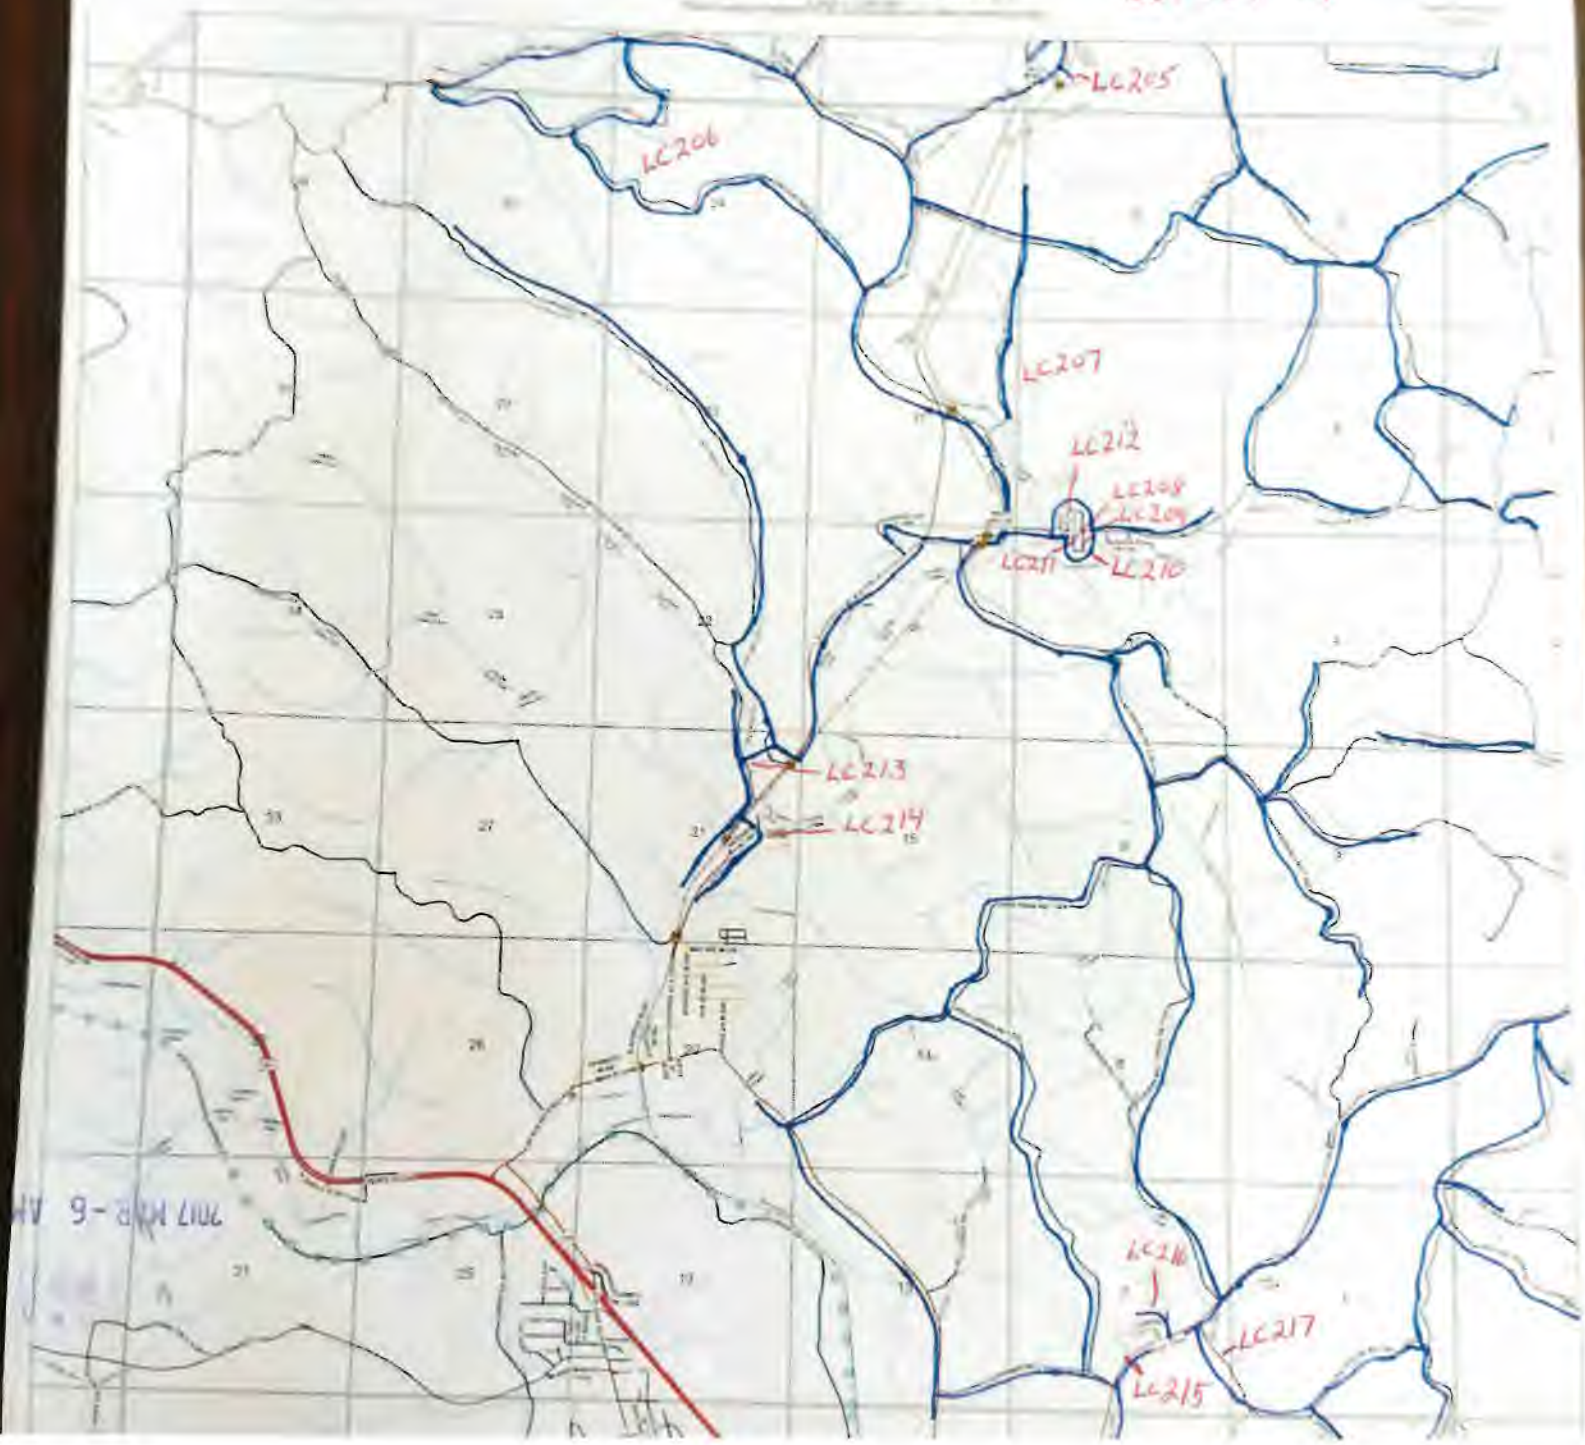


2017 M.B. - 6



ATHENS COUNTY AUDITOR TAX PLAT  
7/24/11 10:41 AM  
These tracts are subject to the 2011 tax rate and are to show owner's property.

Cannon Twp

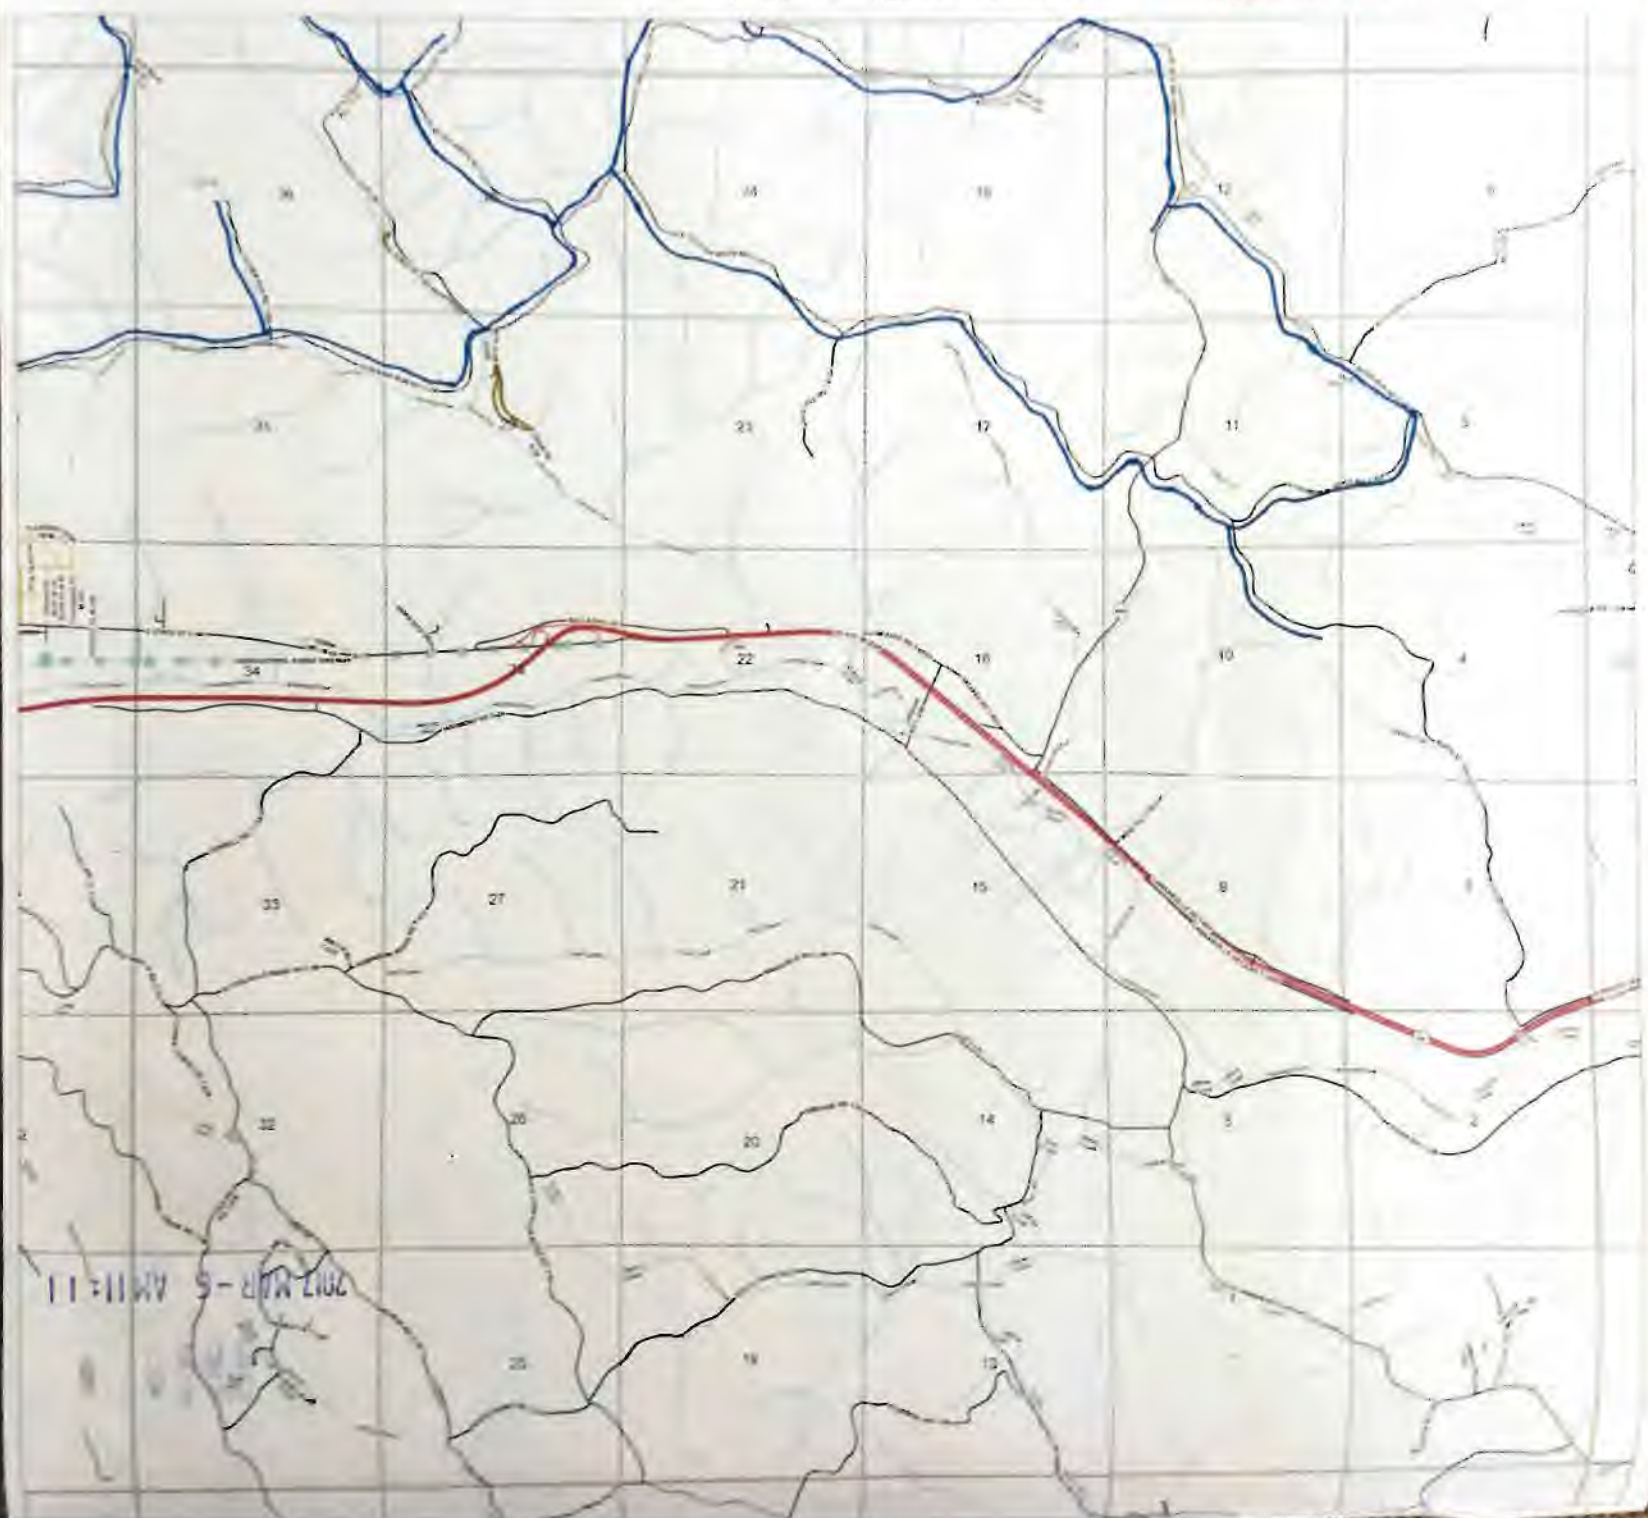

2012 MAR - 5 AM 11:11

# ATHENS COUNTY AUDITOR TAX PLAT

1 inch = 1,500 feet

These maps are believed to be correct and are to show ownership only.

Athens T9-

