




New Automobile Dealership for :  
SARCHIONE CHEVROLET

State Route 44

Randolph, OH

PJS 046765812

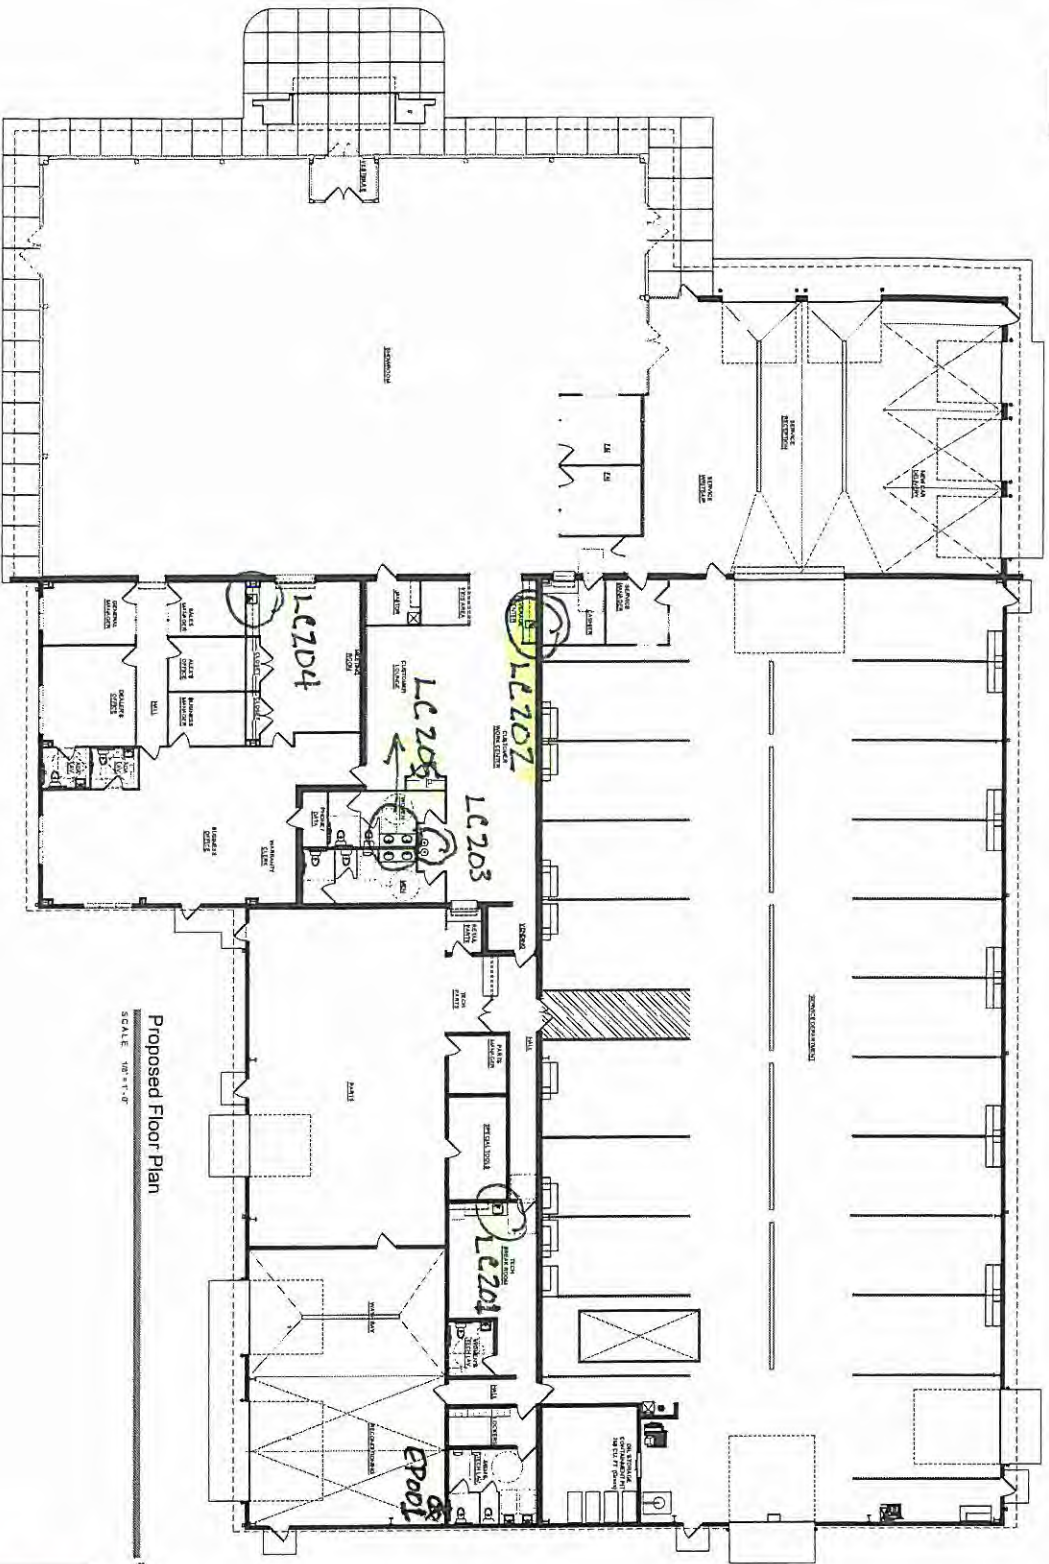

Proposed Floor Plan  
SCALE: 1/8" = 1'-0"



**Baker  
Bednar  
Snyder  
& ASSOCIATES, INC.**  
ARCHITECTURE ENGINEERING INTERIOR DESIGN