


New Automobile Dealership for :  
SARCHIONE FORD

State Route 44 Randolph, OH

P115 046760212

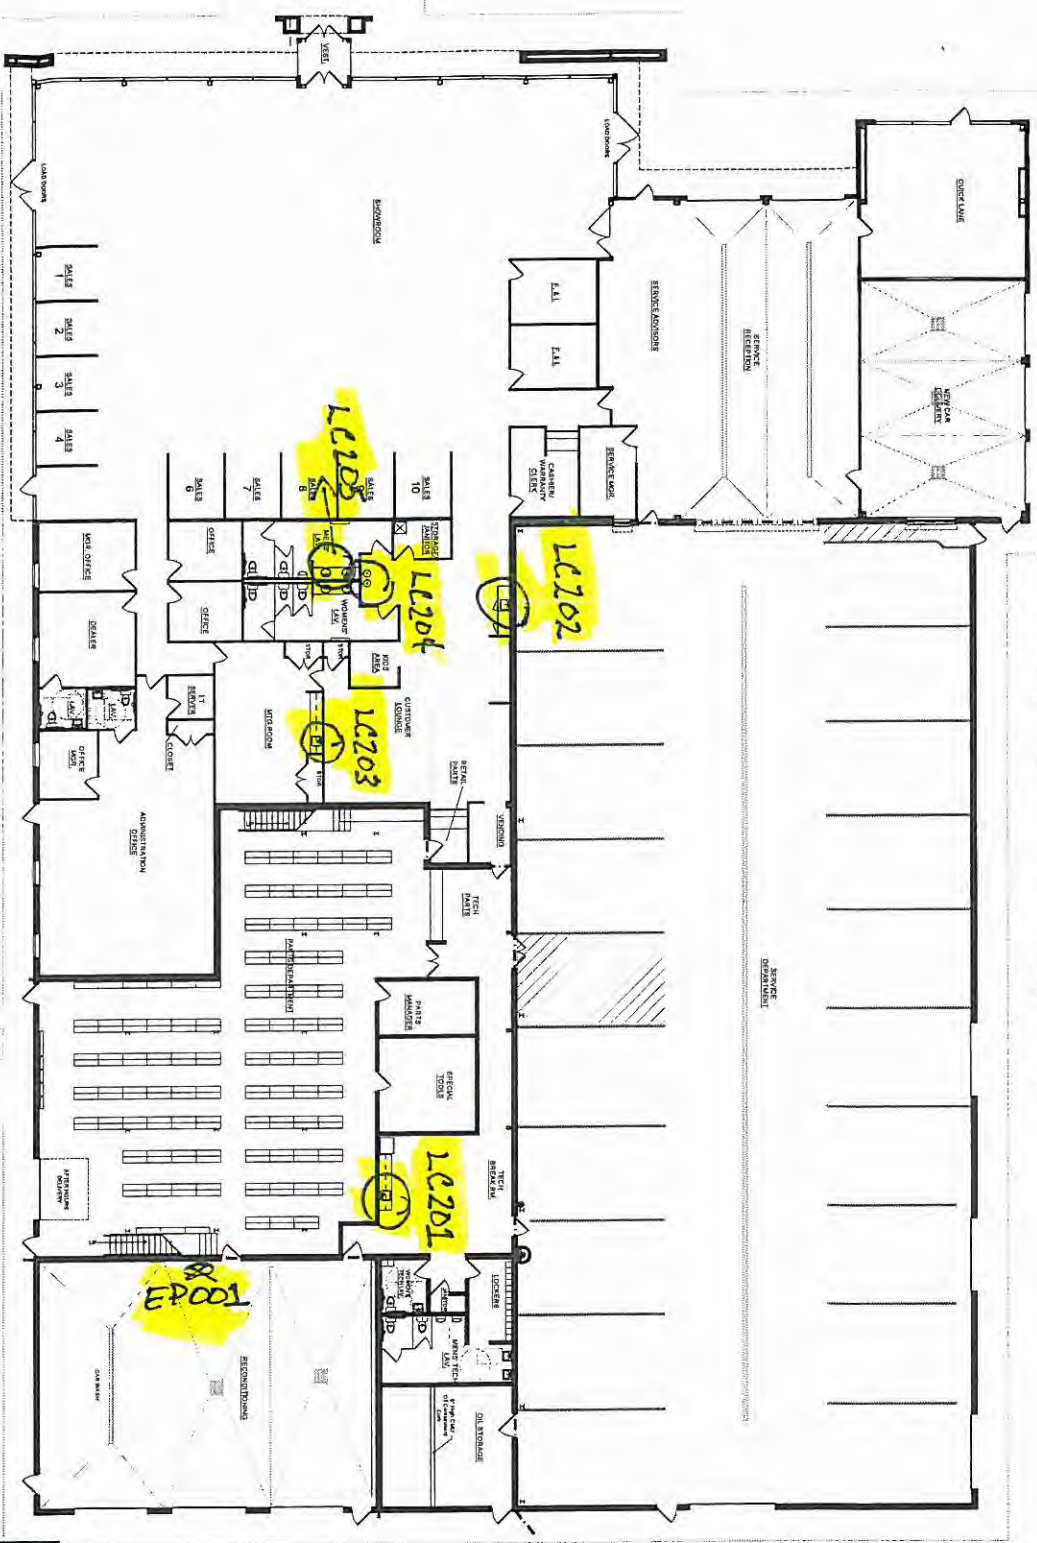

Floor Plan



**Baker  
Bednar  
Snyder  
& ASSOCIATES INC**  
ARCHITECTURE ENGINEERING INTERIOR DESIGN