RECEIVED
FEB 10 2017
OHIO EPA NEDO
OH 7835312

OEPA
LEAD AND COPPER MAPPING

BRISTOL LOCAL SCHOOLS
1845 GREENVILLE ROAD
BRISTOLVILLE, OHIO 44402

1. Elementary building built in 2000 includes kitchen
plumbing copper/plastic/galvinized
2. Two wells feed water room galvinized/plastic service lines to bldg.
3. All mains feeding cold and hot water copper
4. All water fountains and sinks new 2000

1 Middle school area has no water including all three floors in 1970's anex area

1. High school old section has a number of additions orginal 1917 through the 1970's
all water fountains and most plumbing updated 2001
2. High school restrooms updated 1980's
3. High school gym area waterfountains and plumbing updated 2001 (copper /plastic)
4. Old high school only has two water fountains 2001 thru present

No lead lines throughout complex most sodier 2000 through present

Entity: Bristol Local Schools
Doc Type: Report
Doc Subtype:
Program: DDAGW
County: Trumbull
Secondary ID: OH 7835312
eDOC in Color

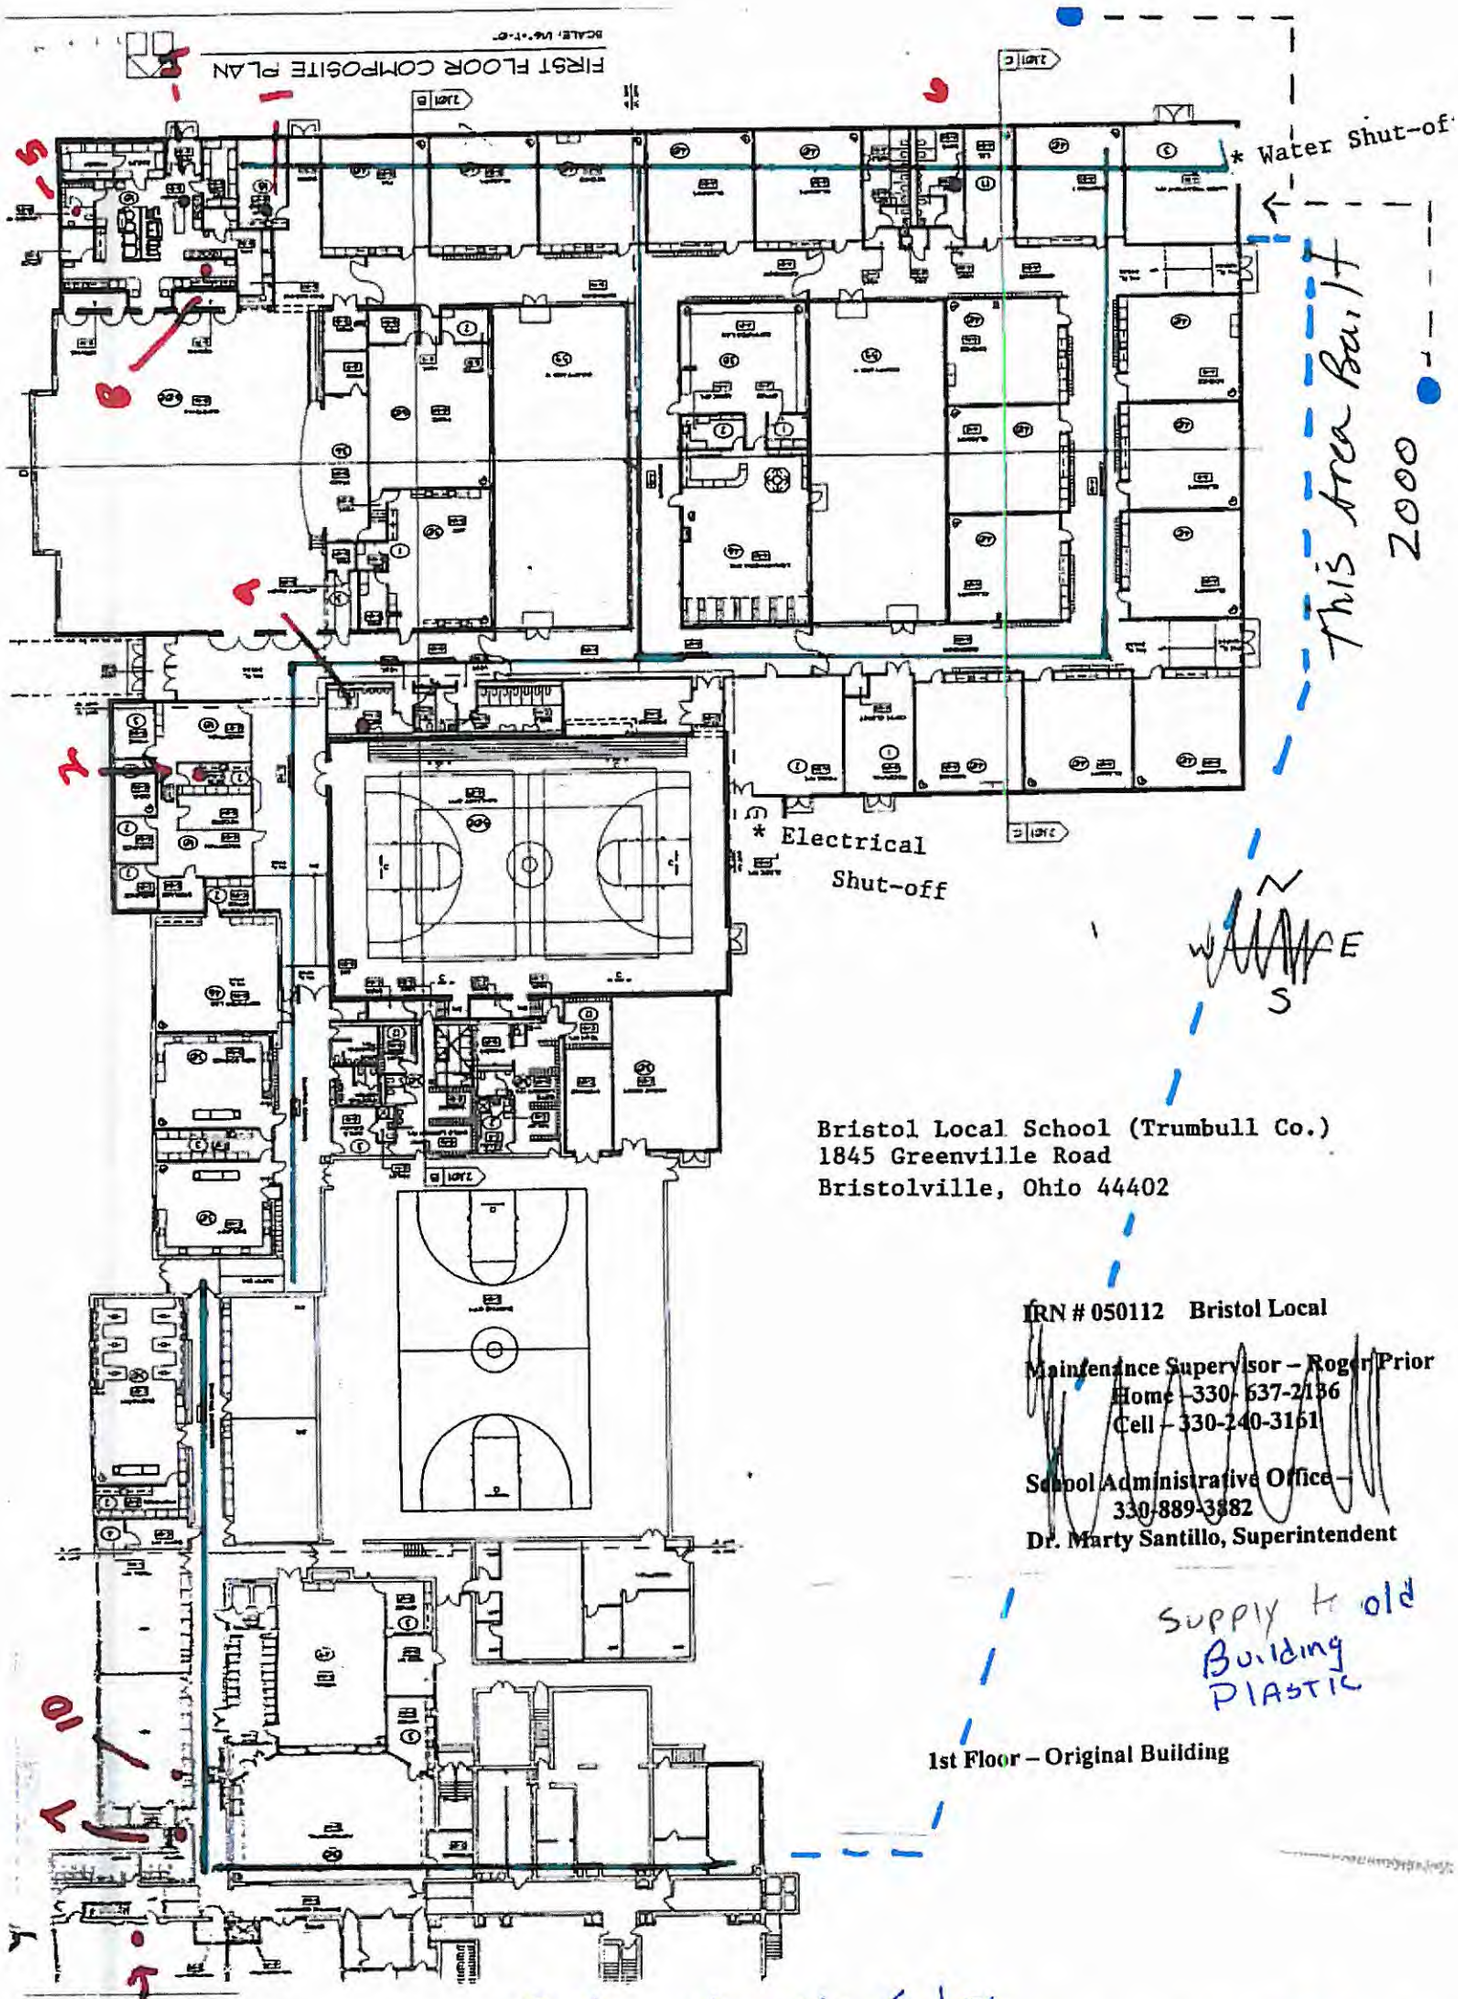

Pb Cu Sample Sites

1 STAFF Lunch Room
2 Elem office
3 HS office
4 Kitchen pot
5 Kitchen Hand
6 Boys 1ST Grade
7 Boys 1ST Floor HS
8 Kitchen Tripple Sink
9. Boys RR 4th Grade
10 mens STAFF HS

3RD Floor – Original Building

BRISTOL SCHOOL
FLOOR PLAN

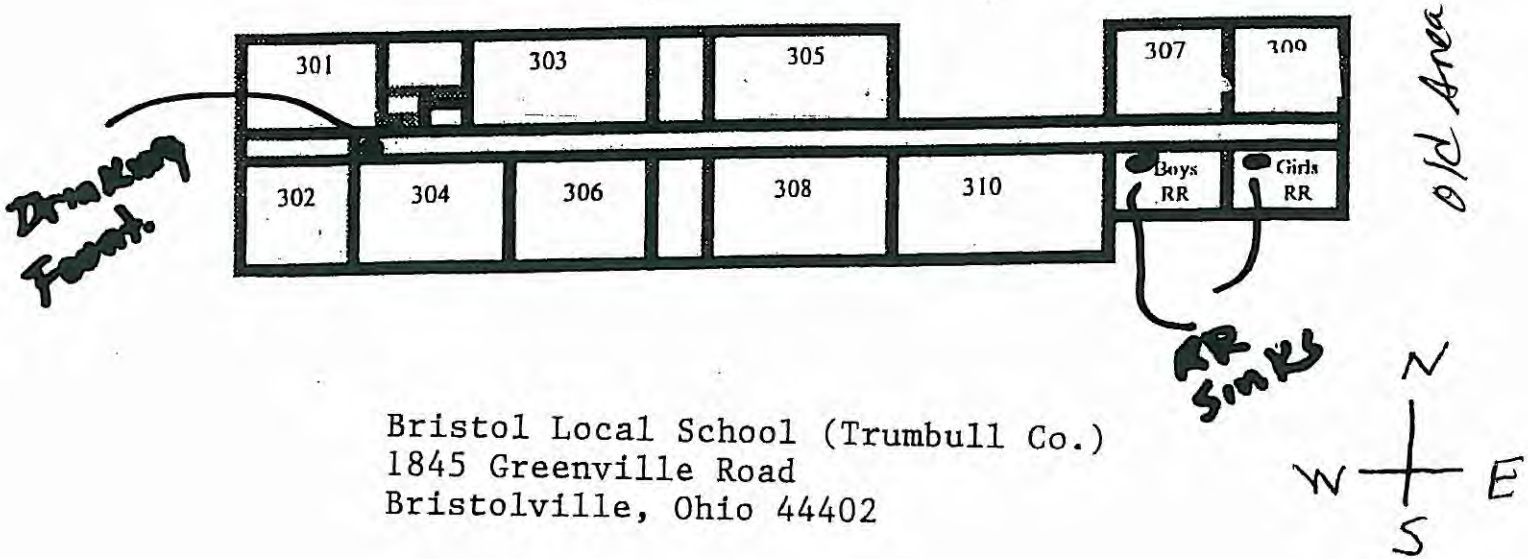

Bristol Local School (Trumbull Co.)
1845 Greenville Road
Bristolville, Ohio 44402

IRN # 050112 Bristol Local

Maintenance Supervisor – Roger Prior
Home – [redacted]
Cell – 330-240-3161

School Administrative Office –
330-889-3882
Dr. Marty Santillo, Superintendent

2nd Floor – Original Building

BRISTOL SCHOOL
FLOOR PLAN

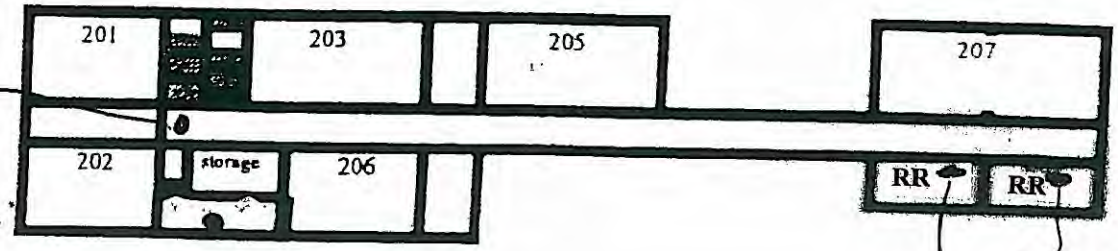

Drinking Fount.

Restroom Sinks

Old Area

Bristol Local School (Trumbull Co.)
1845 Greenville Road
Bristolville, Ohio 44402

N
W
E
S

IRN # 050112 Bristol Local

Maintenance Supervisor – Roger Prior
Home –330-[redacted]
Cell – 330-240-3161

School Administrative Office –
330-889-3882
Dr. Marty Santillo, Superintendent