ADDITION OF SANCTUARY & OFFICE 1978
NO WATER LINES

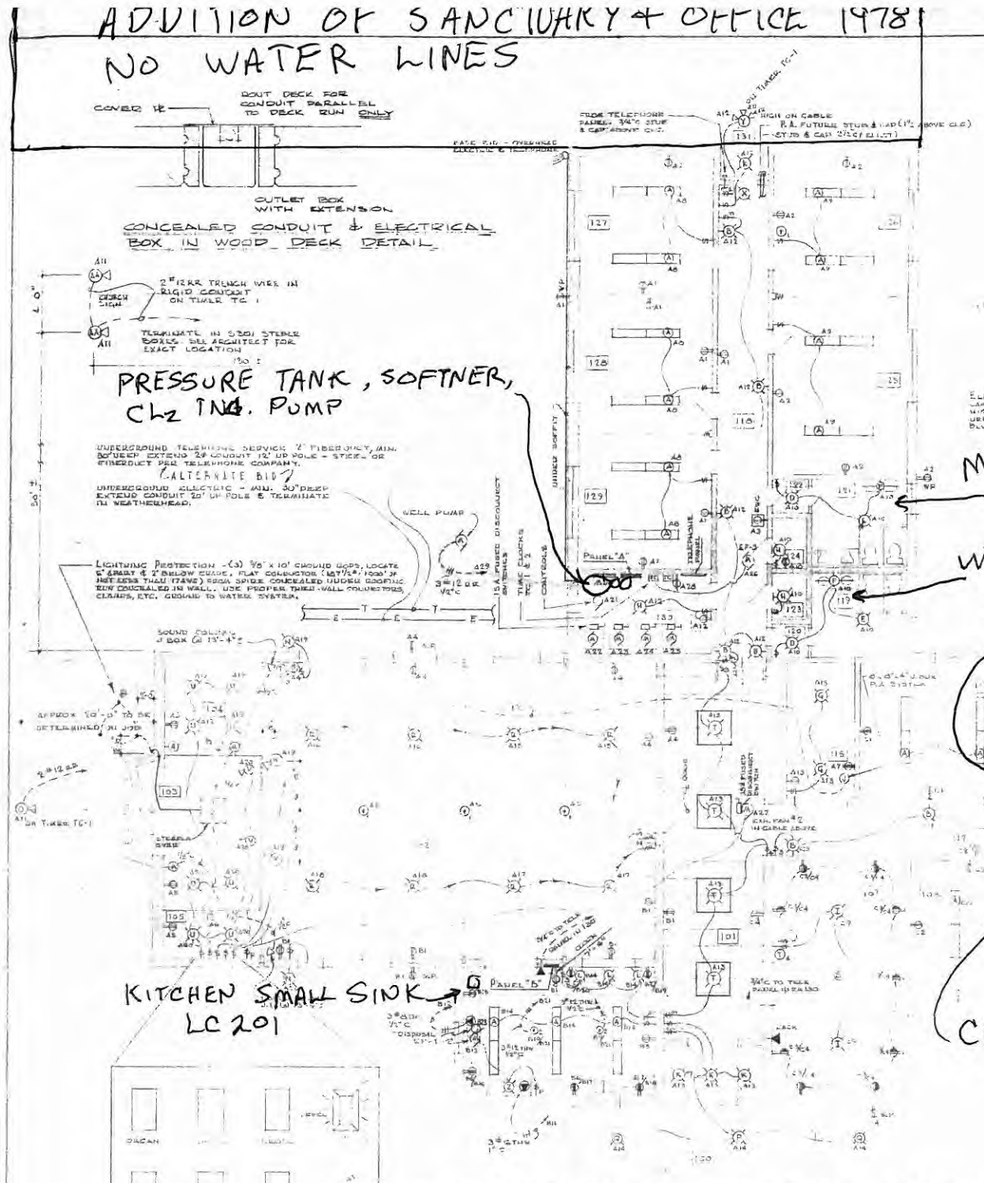

LEGEND

SYMBOL	DESCRIPTION
$	SIERRA, 5011C, 15A, SINGLE POLE QUIET SWITCH
$3	SIERRA, 5013C, 15A, THREE WAY QUIET SWITCH
$P	SIERRA, 5011C 15A SINGLE POLE, PILOT LIGHT SWITCH
$Elec	SIERRA 6699SI 15, SINGLE POLE, 2000W DIMMER SWITCH
$SSP	TWO SPEED SWITCH FURNISHED BY OTHERS - INSTALLED BY THIS CONTRACTOR
	SIERRA, 1801C, 15A, DUPLEX 3 WIRE GROUNDED
	SIERRA, 1861G, 20A DUPLEX 3 WIRE GROUNDED TWIN OUTLET 180 V
WC	SIERRA, 1821C, 20A, DUPLEX, 3 WIRE GROUNDED ELECTRIC WATER COOLER
GFI	SIERRA, 1402 WD, WEATHER PROOF 15A DUPLEX GROUNDED RECEPTACLE & COVER PLATES
	SIERRA, 1801C - TOP HALF ON SWITCH
	COMBINATION RECEPTACLE & SWITCH
	SIERRA 2123, 15A 3 WAY, SINGLE GROUNDED CLOCK HANGER & STAINLESS STEEL PLATE
A	WIRE OUTLET
	FLOOD LIGHT
T	THERMOSTAT
TC	TIME CLOCK
	HUBBELL 2303 DF, 20A, 250V WATERTIGHT FLOOR DUPLEX COMP. W/20A DUPLEX GRND RECEPT
S	CEILING SPEAKER LOCATION — SEE SPECS & DETAILS
N	WALL SPEAKER — P.A.
◀	TELEPHONE OUTLET
	220 V. OUTLET - DESIGNATED ON PLAN
	INCANDESCENT LIGHT FIXTURE
	FLUORESCENT LIGHT FIXTURE
M	MOTOR
J	JUNCTION BOX - STANDARD UNLESS DESIGNATED
D	DISCONNECT SWITCH
PDB	POWER DISTRIBUTION POWER BOARD
	LIGHTING PANELBOARD
	CONCEALED WIRING - CEILING
	CONCEALED WIRING - UNDER FLR OR GROUND
	HUBBELL FSCO 283 DUPLEX WATERTIGHT FLOOR BOX WITH QUE 20A 110 VOLT FLUSH RECEPTACLE AND QUE 20A, 250V 2 POLE, 3 WIRE GROUNDED, RECEPTACLE
$4	SIERRA 5014C FOUR WAY QUIET SWITCH

FIXTURE SCHEDULE

MARK	CAT. NO.	DESCRIPTION	MTD	LAMP
A	DA-2100-088	SILVER "FINISH" 2 BLACK CHANNEL & BASE CAP	SURF	(4) F40T12 RS
B	5-189	PRESCOLITE, ATC HGT 9'-6" BRUSHED NICKEL	WALL	100 W
C	WB2 - 15/3	PRESCOLITE ATC HGT 2'-0"	WALL	20 W
D	7808-508	PRESCOLITE	SURF	60W
E	7810-580	PRESCOLITE	SURF	(2) 26W
F	245 HC	ALKCO ATC HGT 2'-6"	WALL	(1) F40T12ES
G	7810	PRESCOLITE	SURF	(2) 60W
H	—	PORCELAIN LAMPHOLDER	SURF WALL	100 W
I	9062	PISTOL	SURF	(4) 75W
K	4842 3/4	OMEGA	RECESS	75 A-19
L	4842	OMEGA	RECESS	75 R 30
N	8220	PRESCOLITE EXTERIOR ATC HGT. 9'-0"	WALL	100 W
O	7300G	PRESCOLITE PANORAMA FLOOD	COND.	300 W R-3 SOFT GLASS TUNGSTEN HALOGEN
P	B-1052 3)AC	PRESCOLITE - SPECIAL FLAT CANOPY FOR EXTERIOR, VARY CORD LENGTHS SO FIXTURES HANG 9' ABOVE FLOOR (TO BE ADJUSTED IN JOB) 2 AC" SHADES SHADE SUPPLY & INSTALLED		
		NICKEL (INNER) PROVIDE PIANO WIRE GUYS	CORD	3-150 PAR
Q	1125	PRESCOLITE 5115 HANG STRAIGHT 5" FLAT (BLACK BLACK CANOPY AND METAL STEM	STEM	150 PAR 38
R	B103(3)1500	PRESCOLITE SPECIAL 24" STEM, SHEARING		
		PROVIDE EXTRA CORD TO HANG FIXTURE TO 10' ABOVE FLOOR (TO BE ADJUSTED) ON JOB.	CORD	(3) 100 CLEAR
T	1808	PRESCOLITE - HANG TO 7'-4" ABOVE FLOOR, 2'-0" OVERALL FIXTURE DIMEN. ONE DEP. W/5 ON GREEN DEVICE	CORD	(1) 150 CLEAR
U	H827LP	OMEGA 14" OVERALL METAL SHADE - STRAIGHT	PEND ANT	150 PAR 46 FL
V	D473	OMEGA	SURF	150 E40HSD
W	D6971	OMEGA 5112 HANG STRAIGHT	PEND ANT	150 PAR 38 COOL BEAM
X	71231	PRESCOLITE WHT LIGHT	CLG	22W
Y	3-358/36-3306	STEBEL	WALL	(3) 150 PAR 38
Z	AC-1060	MILLER - VAPOR PROOF GASKET SHIELD	SURF	100 W
AA	5-333/30H	STEBEL	CONC	150 PAR 38

PANEL "A"

208Y/120V 3Ø 4W, M.L.O. 100A SURFACE 200W 113, CCT 17

CCT	LOAD	BKR	REMARKS
1	1050 R	20A, 1P	
2	700 R	"	
3	1200 L	"	ELECTRIC WATER COOLER
4	900 R	"	
5	900 R	"	
6	1200 R	"	ORGAN
7	1200 R	"	P.A. AMPLIFIER - ROOM 113
8	1200 L	"	
9	800 L	"	
10	740 L	"	
11	1300 L	"	FLOOD IN TIMBER TC-1 & SIGN
12	1150 LER	"	
13	700 L	"	
14	750 L	"	
15	600 L	"	
16	600 L	"	
17	600 L	"	
18	600 L	"	
19	1000 L	"	
20	1000 L	"	
21	300 A	"	HEATING CONTROLS
22	850 R	"	FURNACE
23	850 R	"	FURNACE
24	850 R	"	FURNACE
25	850 R	"	FURNACE
26	370 A	"	EXHAUST FAN #3 ON TIMER TC-2
27	530 A	"	EXHAUST FAN #2
28	300 E	"	TELEPHONE PANEL
29	1500 A	20A, 2P	WELL PUMP
30	SPARE	20A, 1P	
31	"	"	
32	"	"	
33	SPACE	1P	
34	"	"	
35	"	"	

L LIGHTS
R RECEPTACLES
M MOTOR
LR LIGHTS & RECEPTACLES
KVA KILOWATTS

PANEL "C"

208Y/120V 3Ø 4W, M.L.O. 100 A SURFACE 200W 113, CCT 17

CCT	LOAD	BKR	REMARKS
1	1050 R	20A, 1P	
2	700 R	"	
3	1900 L	"	SWITCHES
4	1050 R	"	
5	850 R	"	FURNACE
6	3[illegible]	"	"
7	1100 L & R	20A, 1P	"
8	1[illegible] L & R	"	"
9	1100 L	"	
10	SPARE	"	
11	"	"	
12	"	"	
13	SPACE	1P	
14	"	"	
15	"	"	
16	"	"	
17	—	4 3	[illegible]

PANEL "B"

208Y/120V 3Ø 4W, M.L.O. 100A TYPE 1 CSP, 1/2 FULL CAPACITY NEUTRAL SURFACE 200W 108

CCT	LOAD	BKR	REMARKS
1	1050 R	20A, 1P	
2	1050 R	"	
3	1050 R	"	
4	1050 R	"	
5	1050 R	"	
6	1050 R	"	
7	1050 R	"	
8	1050 R	"	
9	1050 R	"	FLOOR RECEPTACLE
10	1050 R	"	FLOOR RECEPTACLE
11	1200 RWC	20A, 2P	COM. RANGE
12	6000 HTR	40A, 2P	BOOSTER HEATER
13	300A	20A, 1P	RANGE EXHAUST FAN
14	625 L	"	
15	1050 R	"	
16	1050 R	"	
17	1050 R	"	
18	1050 R	"	
19	1050 R	"	
20	1050 R	"	
21	900 R	20A, 2P	FLOOR RECEPTACLE
22	900 R	20A, 2P	FLOOR RECEPTACLE
23	1200 M	20A, 1P	DISPOSAL
24	SPARE	"	
25	"	"	
26	SPACE	1P	
27	"	"	
28	"	"	

MAIN DIST. PANEL

SECT	SIZE	FRAME	FOR
1	100 A, 3P	E	PANEL A
2	125 A, 3P	F	PANEL B
3	8[illegible] A, 1P	C	PANEL C
4	200 A, 3P	F	SPACE ONLY
5	100 A, 3P	E	SPACE ONLY
6	30 A, 3P	E	FUTURE AIR CONDITIONING SUBSTATION #1 ONLY
7	"	E	FURNACE #2 ONLY
8	"	E	FURNACE #3 ONLY
9	"	E	FURNACE #4 ONLY
10	"	E	FURNACE #5 ONLY
11	"	E	FURNACE #6 ONLY

DAMASCUS UNITED METHODIST CHURCH
300 VALLEY RD.
BOX 307
DAMASCUS, OH 44619
PHONE 330 537 3031
PWS 1546112

Entity: Damascus United Methodis
Doc Type: Report
Doc Subtype:
Program: DPAGW
County: Columbiana
Secondary ID: OH1546112
EDC in color

THE UNITED METHODIST CHURCH
DAMASCUS OHIO
Architect
No. 2517
DATE 2-6-69
SHEET E1
ELECTRICAL PLAN & SCHEDULES

⚠ REVISED 3/22/69 - PANELS A, B & C