



Buckeye Packaging Co., Inc.  
12223 Marlboro Ave NE  
Alliance, OH 44601-9772

P (330) 935-0301  
F (330) 935-2705

[www.buckeyepackaging.com](http://www.buckeyepackaging.com)

RECEIVED  
JAN 27 2017  
OHIO EPA NEDO

January 19, 2017

RE: Lead Service Line Mapping Project 2017

Buckeye Packaging Company is a single building manufacturing facility constructed in various stages. Water is supplied by an on-site well.

Underground service lines travel from the well and to the Extruding area. The restroom in the Extruding area was plumbed in 1972 using soldered copper piping. All other interior plumbing was installed after 1992 and consists of soldered copper piping as shown on the Service Line Map along with short connecting runs of plastic piping. Four Tier 1 and one Tier 2 sampling sites are shown on the Map.

Questions may be addressed to:

Gordon Fox  
Plant Manager  
Buckeye Packaging Co.  
[gordon.fox@buckeyepackaging.com](mailto:gordon.fox@buckeyepackaging.com)  
Tel: 330-935-0301



Entity: Buckeye Packaging  
Doc Type: Report  
Doc Subtype: \_\_\_\_\_  
Program: DRAGW  
County: Stark  
Secondary ID: ETXCMC01A  
OH7660462

BUCKEYE PACKAGING COMPANY, INC.  
 OH 7660412 Tel: 330-935-0301  
 12223 Marlboro Ave. Alliance, Ohio 44601  
 Lead Service Line and Fixture Map

**Legend**

- LEAD SERVICE LINES – NONE FOUND
- Plastic Service Line  
(from Well to Treatment and from Treatment to Extruding and Converting)
- Copper Plumbing / Fixtures installed before 1986 – no lead limit  
(short length of line to fixture LC 204)
- Copper Plumbing / Fixtures installed 1986-2014; <8% lead  
(all other plumbing and fixtures)

LC201 – Tier 1, Drinking Fountain <8% lead  
 LC202 – Tier 1, Drinking Fountain <8% lead  
 LC203 – Tier 1, Drinking Fountain <8% lead  
 LC204 – Tier 2, RR Sink, no lead limit  
 LC205 – Tier 1, RR Sink <8% lead

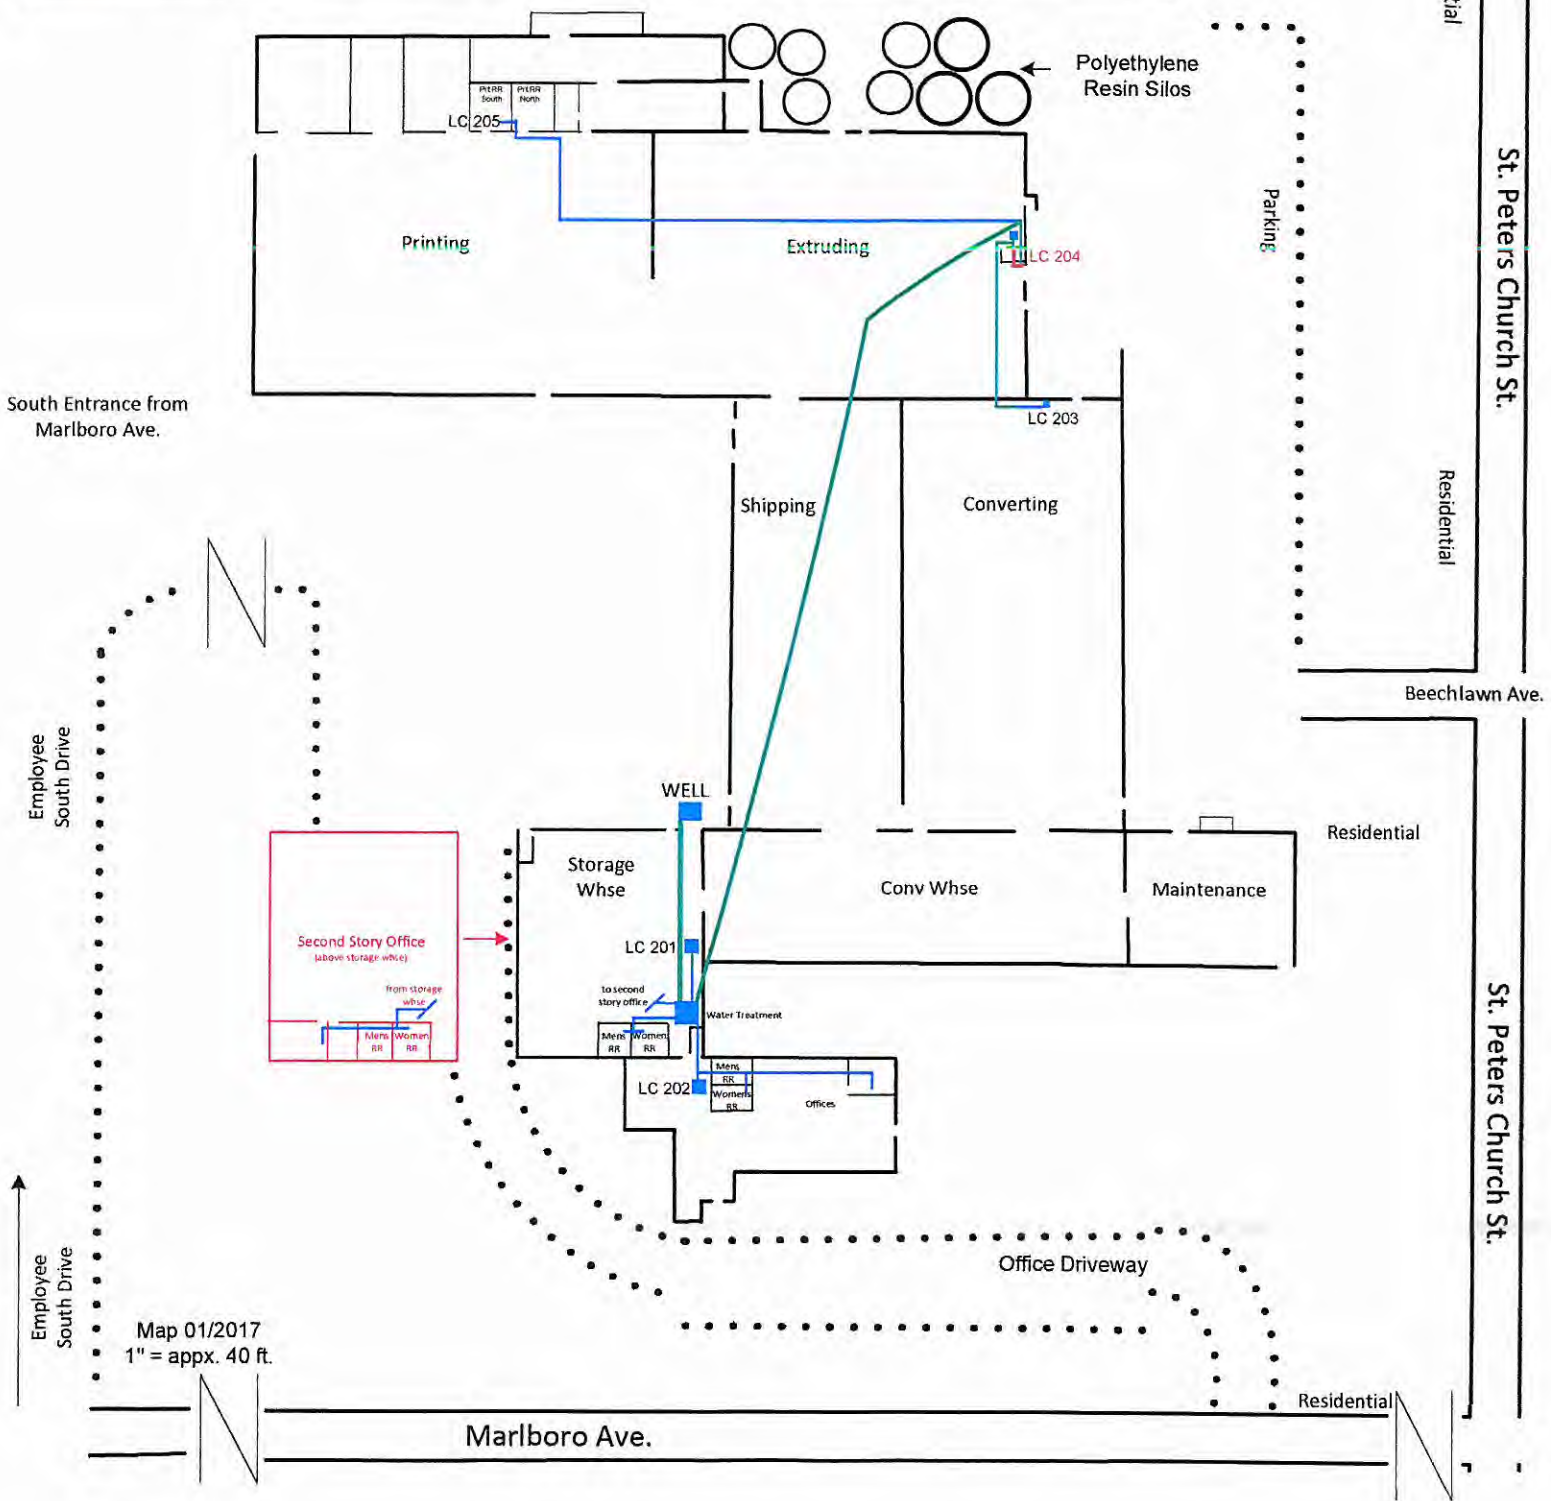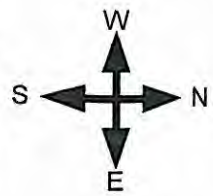

Map 01/2017  
 1" = appx. 40 ft.