

RECEIVED

MAR 01 2017

OHIO EPA NEDO

OEPA Lead Mapping

Joseph Badger Local Schools  
PWS ID OH7854712

This building was built 2004-2005 opened 2006

No lead service lines or other plumbing

No lead samples taken have been above detection levels

Entity: Joseph Badger Local Schools  
Doc Type: Report  
Doc Subtype: \_\_\_\_\_  
Program: DDAAW  
County: Trumbull  
Secondary ID: OH-785-4712

PWSLU OH 7854712

IRN:050179

Joseph Badger School District

7119 State Route 7

Kinsman, OH 44428


Phone Numbers:

Superintendent: 330-876-2810

Badger High: 330-876-2820

Badger Middle: 330-876-2840

Badger Elementary: 330-876-2860

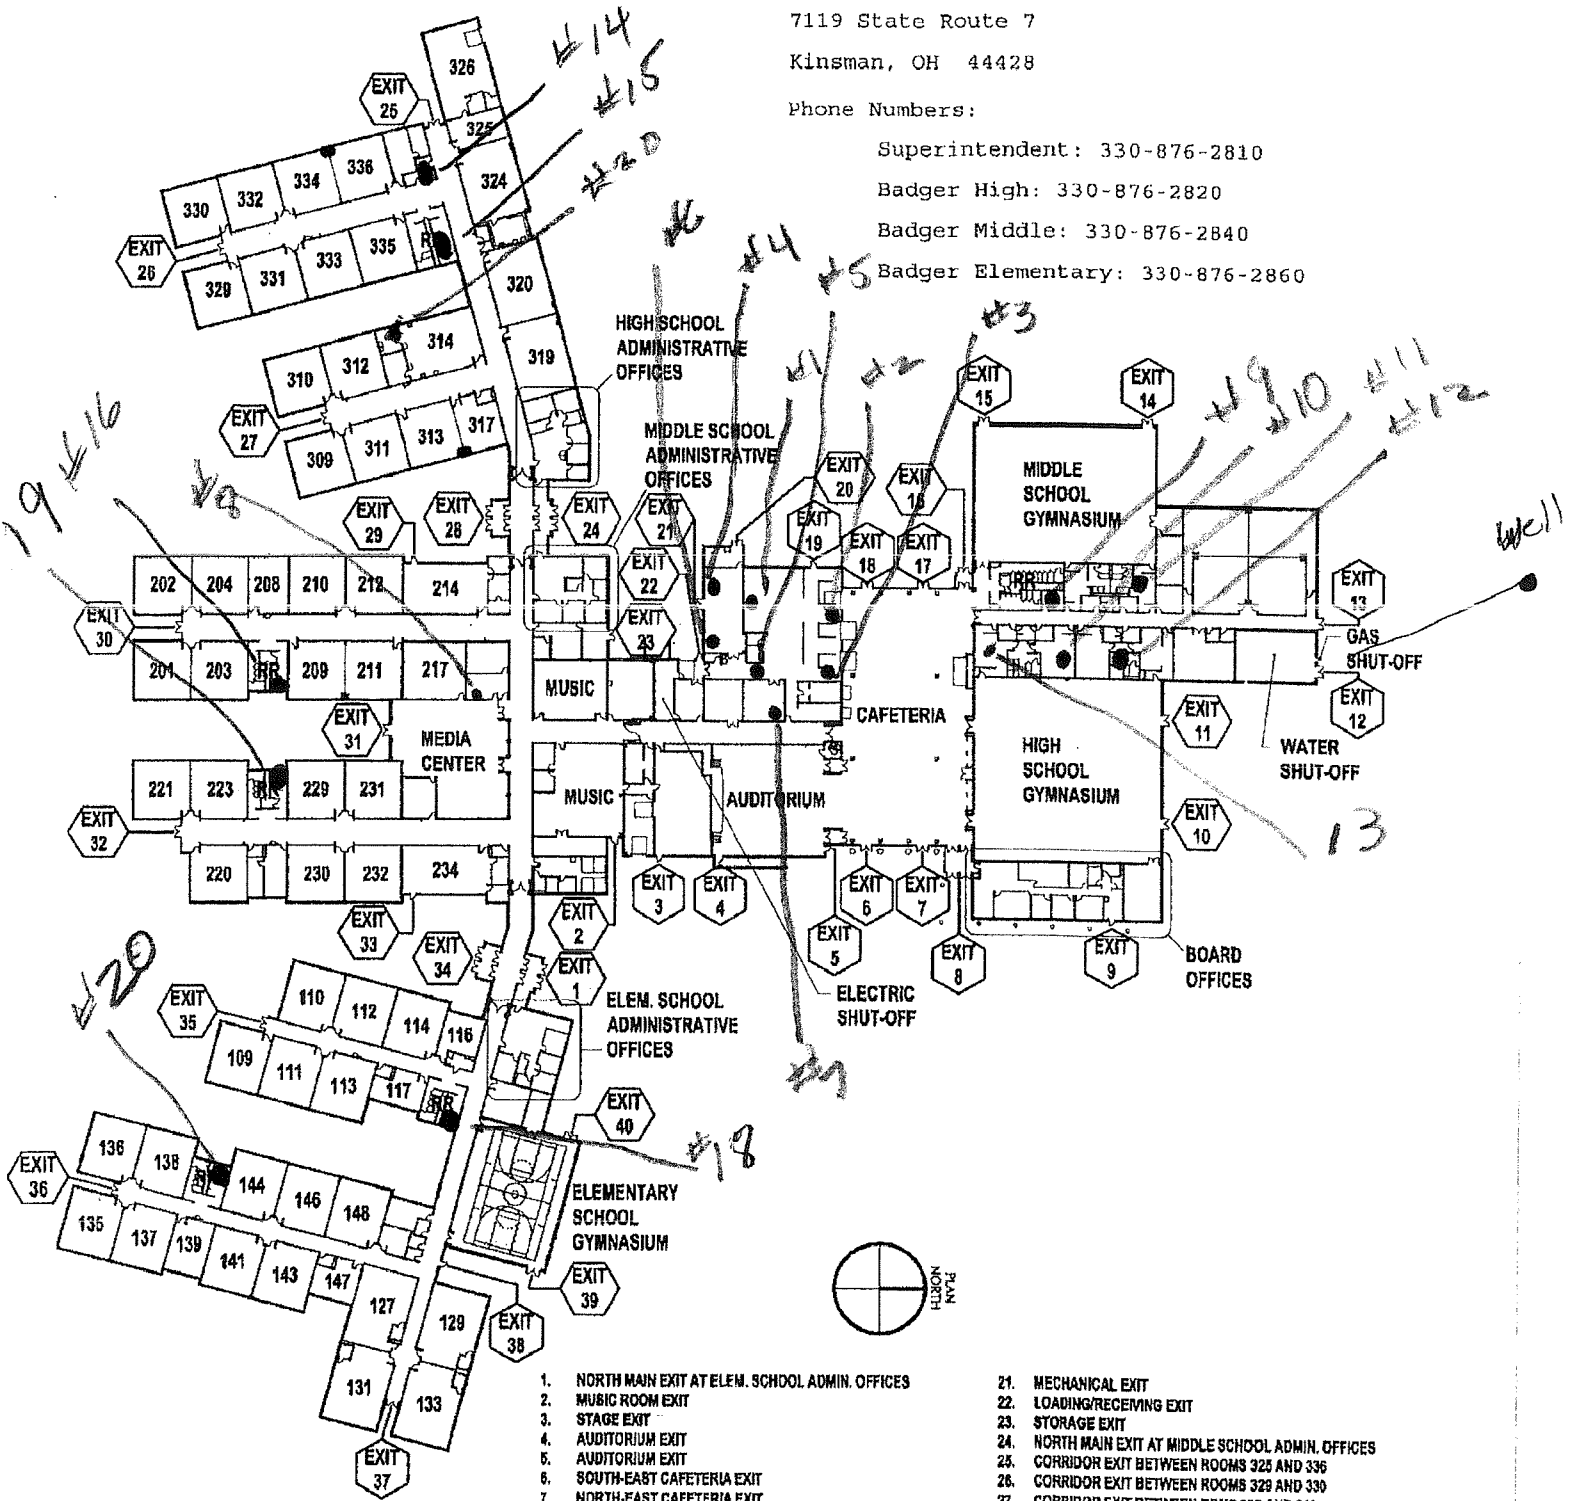

1. NORTH MAIN EXIT AT ELEM. SCHOOL ADMIN. OFFICES
2. MUSIC ROOM EXIT
3. STAGE EXIT
4. AUDITORIUM EXIT
5. AUDITORIUM EXIT
6. SOUTH-EAST CAFETERIA EXIT
7. NORTH-EAST CAFETERIA EXIT
8. NORTH-EAST VESTIBULE EXIT AT CAFETERIA
9. BREAK ROOM EXIT
10. NORTH-EAST HIGH SCHOOL GYM EXIT
11. NORTH-WEST HIGH SCHOOL GYM EXIT
12. WATER PUMP EXIT
13. CORRIDOR EXIT BETWEEN MIDDLE SCH. AND HIGH SCH. GYMS
14. NORTH-WEST MIDDLE SCHOOL GYM EXIT
15. SOUTH-WEST MIDDLE SCHOOL GYM EXIT
16. NORTH-WEST VESTIBULE EXIT AT CAFETERIA
17. NORTH-WEST CAFETERIA EXIT
18. SOUTH-WEST CAFETERIA EXIT
19. KITCHEN EXIT
20. FIRE PUMP EXIT

21. MECHANICAL EXIT
22. LOADING/RECEIVING EXIT
23. STORAGE EXIT
24. NORTH MAIN EXIT AT MIDDLE SCHOOL ADMIN. OFFICES
27. CORRIDOR EXIT BETWEEN ROOMS 309 AND 310
28. SOUTH MAIN EXIT AT MIDDLE SCHOOL ADMIN. OFFICES
29. ART ROOM 214 EXIT
30. CORRIDOR EXIT BETWEEN ROOMS 201 AND 202
31. MEDIA CENTER EXIT
32. CORRIDOR EXIT BETWEEN ROOMS 220 AND 221
33. ART ROOM 234 EXIT
34. SOUTH MAIN EXIT AT ELEM. SCHOOL ADMIN. OFFICES
35. CORRIDOR EXIT BETWEEN ROOMS 109 AND 110
36. CORRIDOR EXIT BETWEEN ROOMS 135 AND 136
37. CORRIDOR EXIT BETWEEN ROOMS 131 AND 133
38. CORRIDOR EXIT BETWEEN ROOM 129 AND ELEM. GYM
39. EAST ELEMENTARY SCHOOL GYM EXIT
40. WEST ELEMENTARY SCHOOL GYM EXIT