
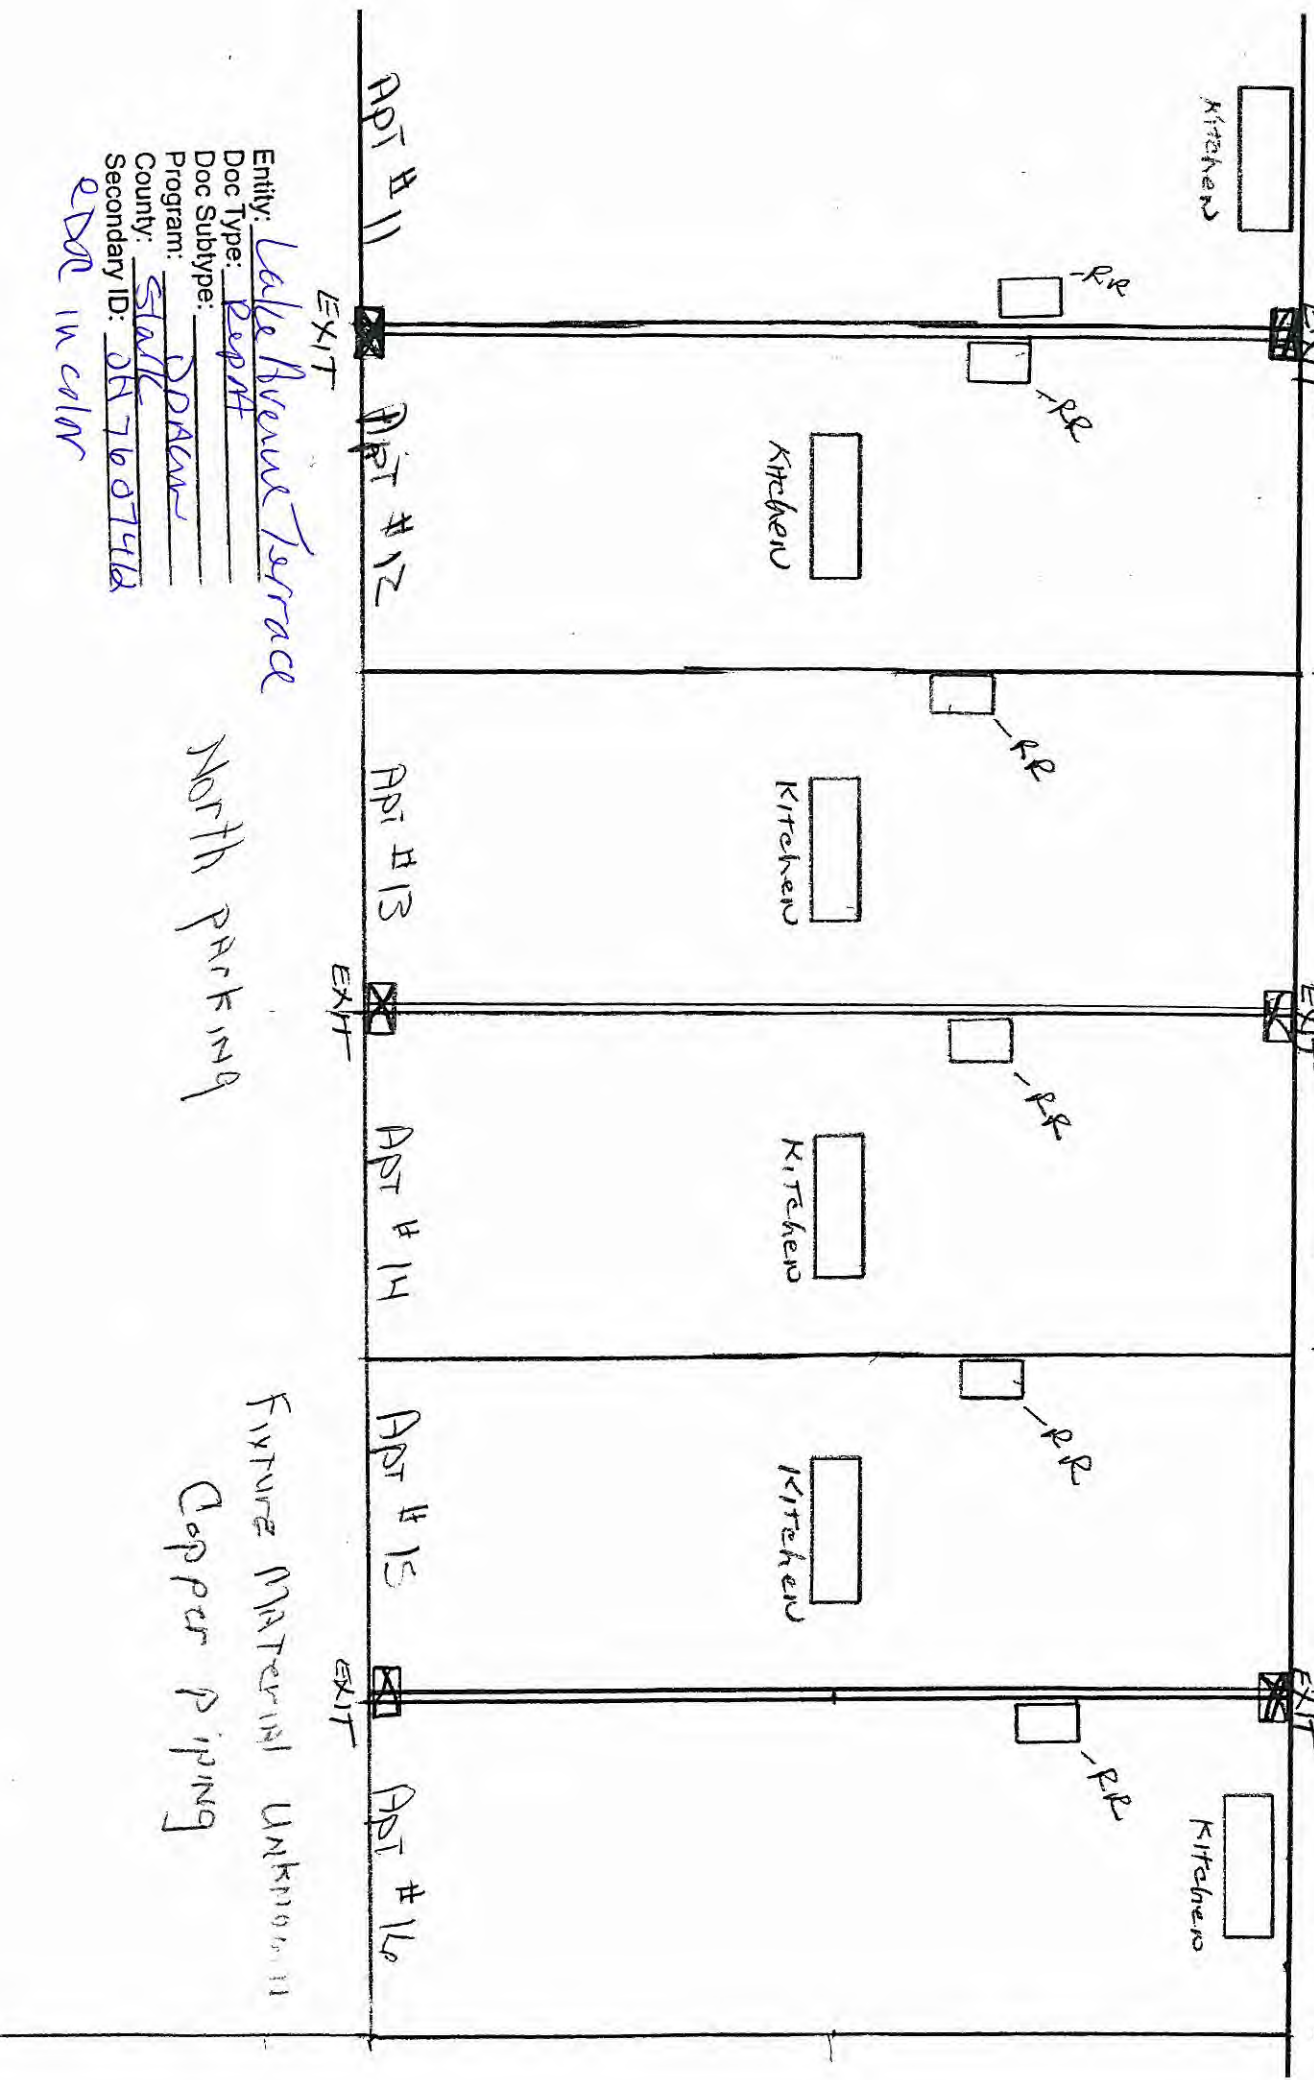


- DONE LEAD
- OTHER
- LEAD

LAKE AVENUE TERRACE  
 239 LAKE AVE.  
 HARTVILLE OHIO 44632  
 330-231-5193  
 OH7607412  
 Mapping Lead Plumbing & Fixtures

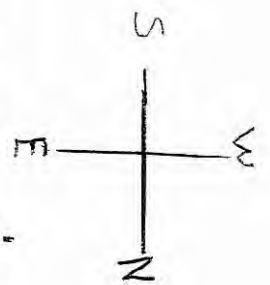

Entity: Lake Avenue Terrace  
 Doc Type: Report  
 Doc Subtype: \_\_\_\_\_  
 Program: DDAW  
 Secondary ID: OH7607412  



North Parking

Future Material Unknown  
 Copper Piping

- Done Lead
- Other
- Lead

Lake Avenue Terrace  
 239 Lake Ave.  
 HARVILLE Ohio 44632  
 330-231-5193

Mapping Lead Plumbing & Fixtures

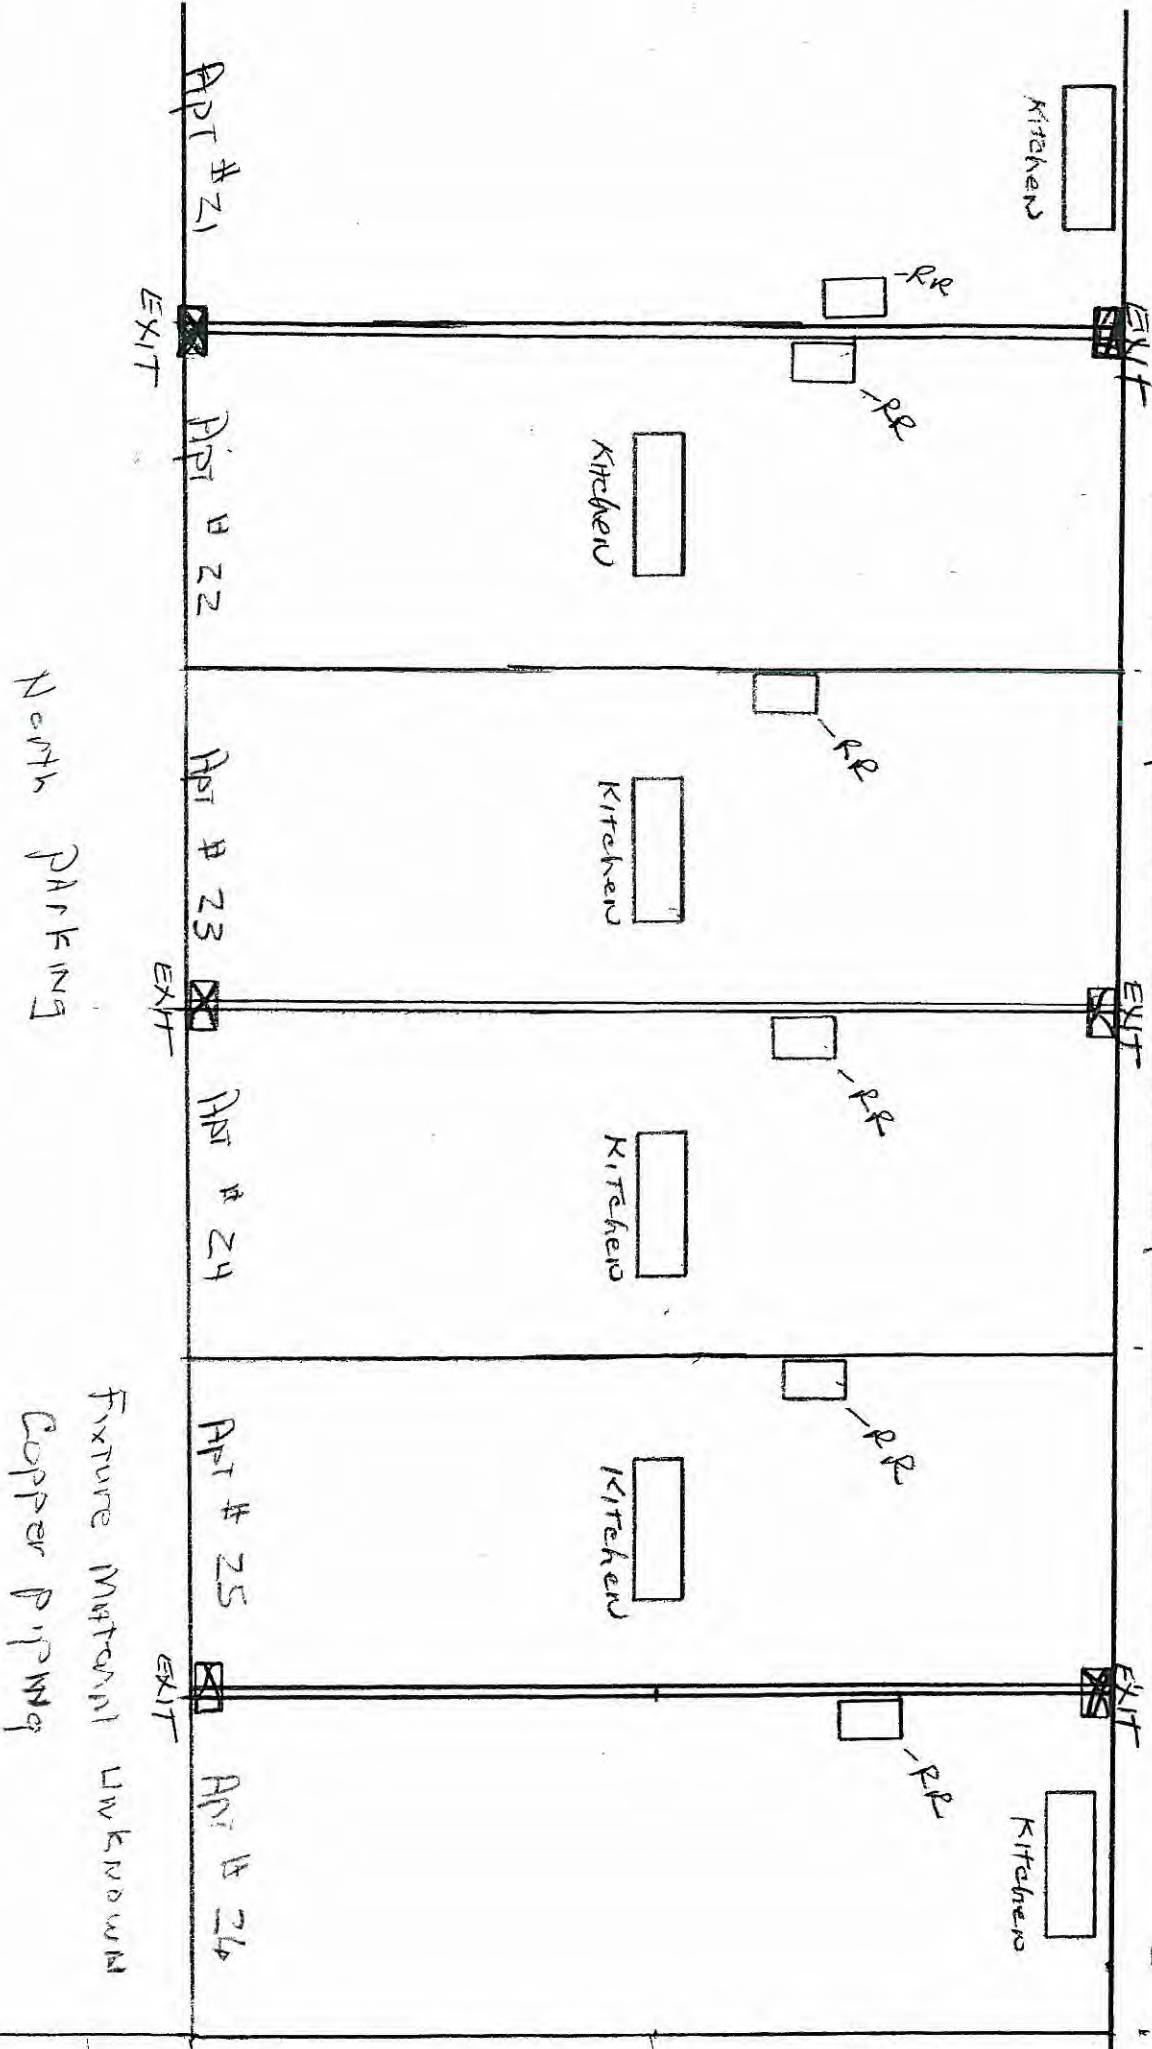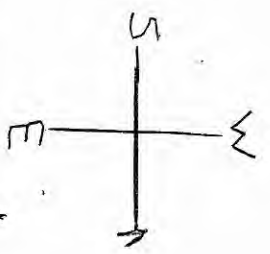



North PARKING

Fixture Material UNKNOWN  
 Copper PIPING

- Material Leads
- Other ---
- Lead.

Lake Avenue Terrace  
 231 Lake Ave.  
 HAROLD, Ohio 44632  
 330-231-5193

MAPPING Lead Plumbing & FIXTURES

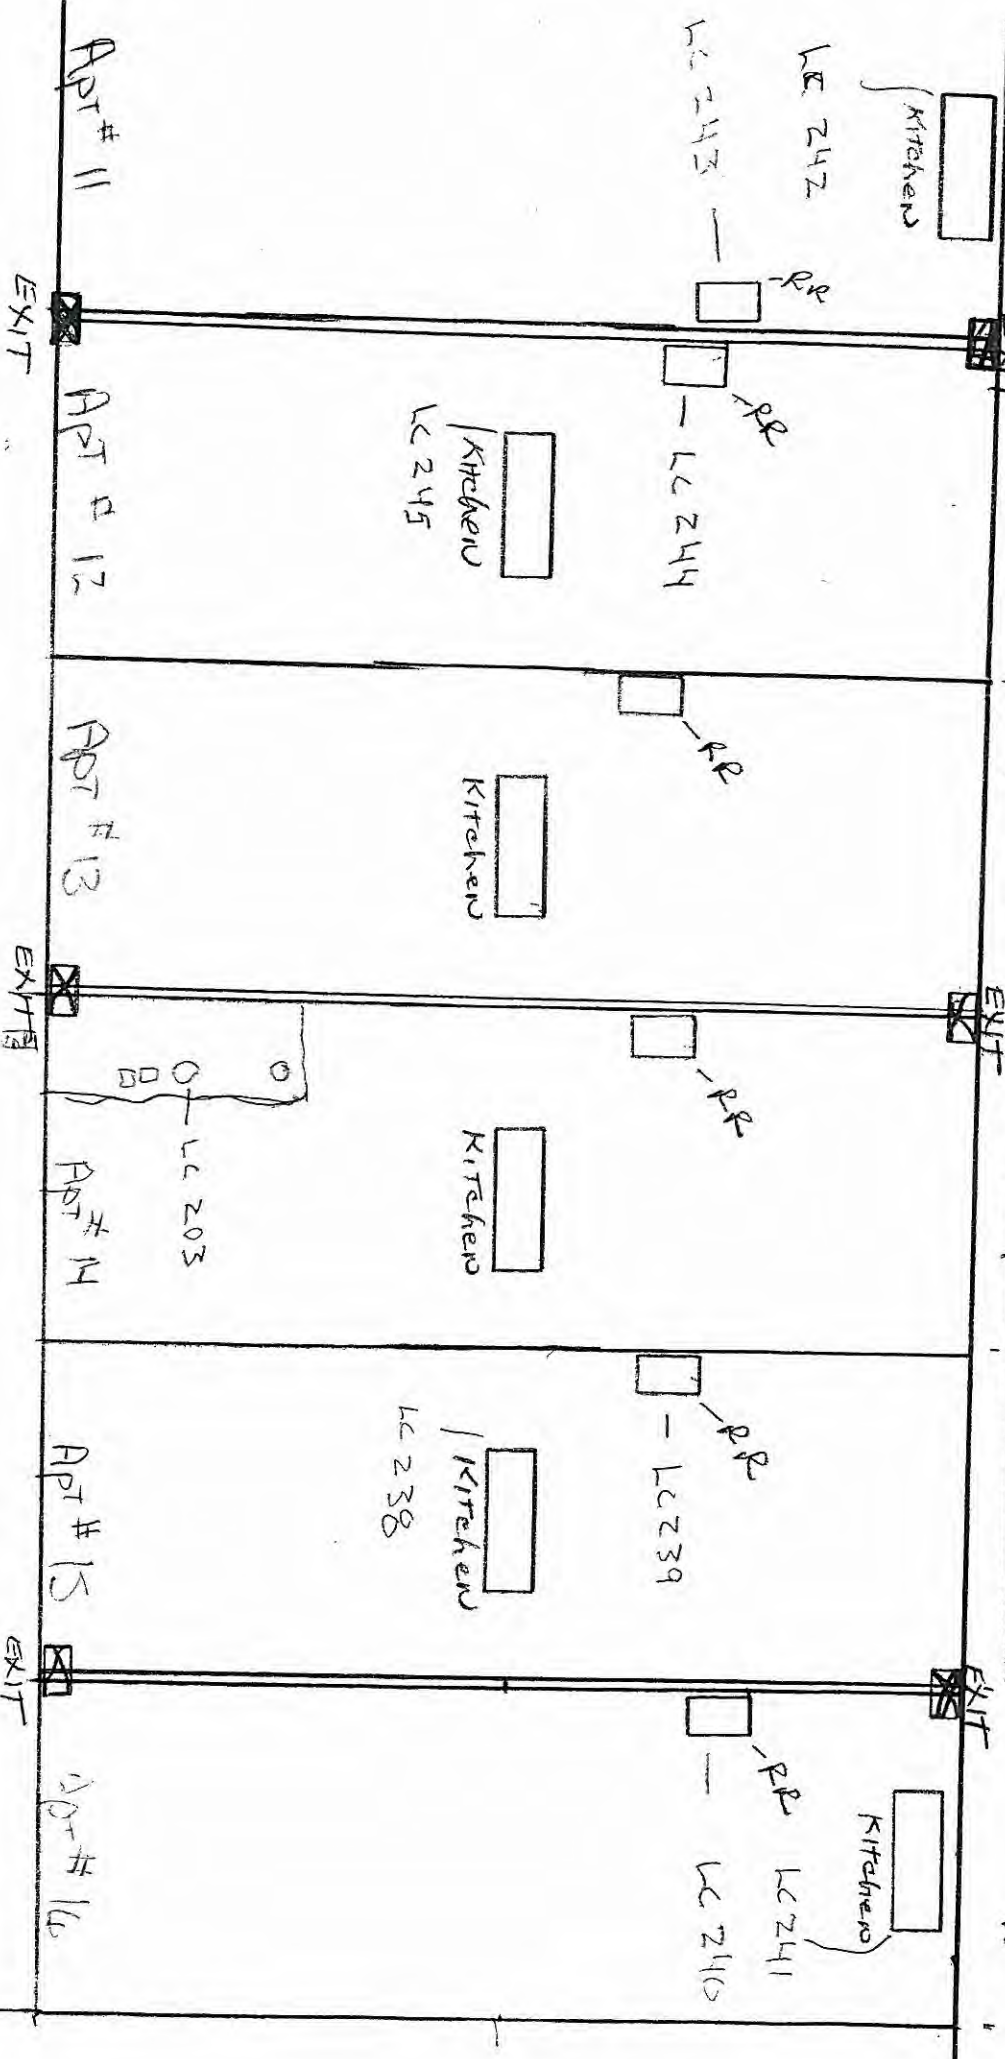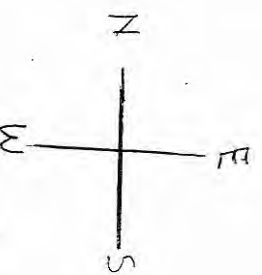



North PARKING

Fixture Material Unknown  
 Copper Piping

- POINT LEAD
- OTHER
- LEAD

Lake Avenue Terrace  
 237 Lake Ave.  
 Hartsville, Ohio 44632  
 330-231-5193

MAPPING LEAD PLUMBING & FIXTURES

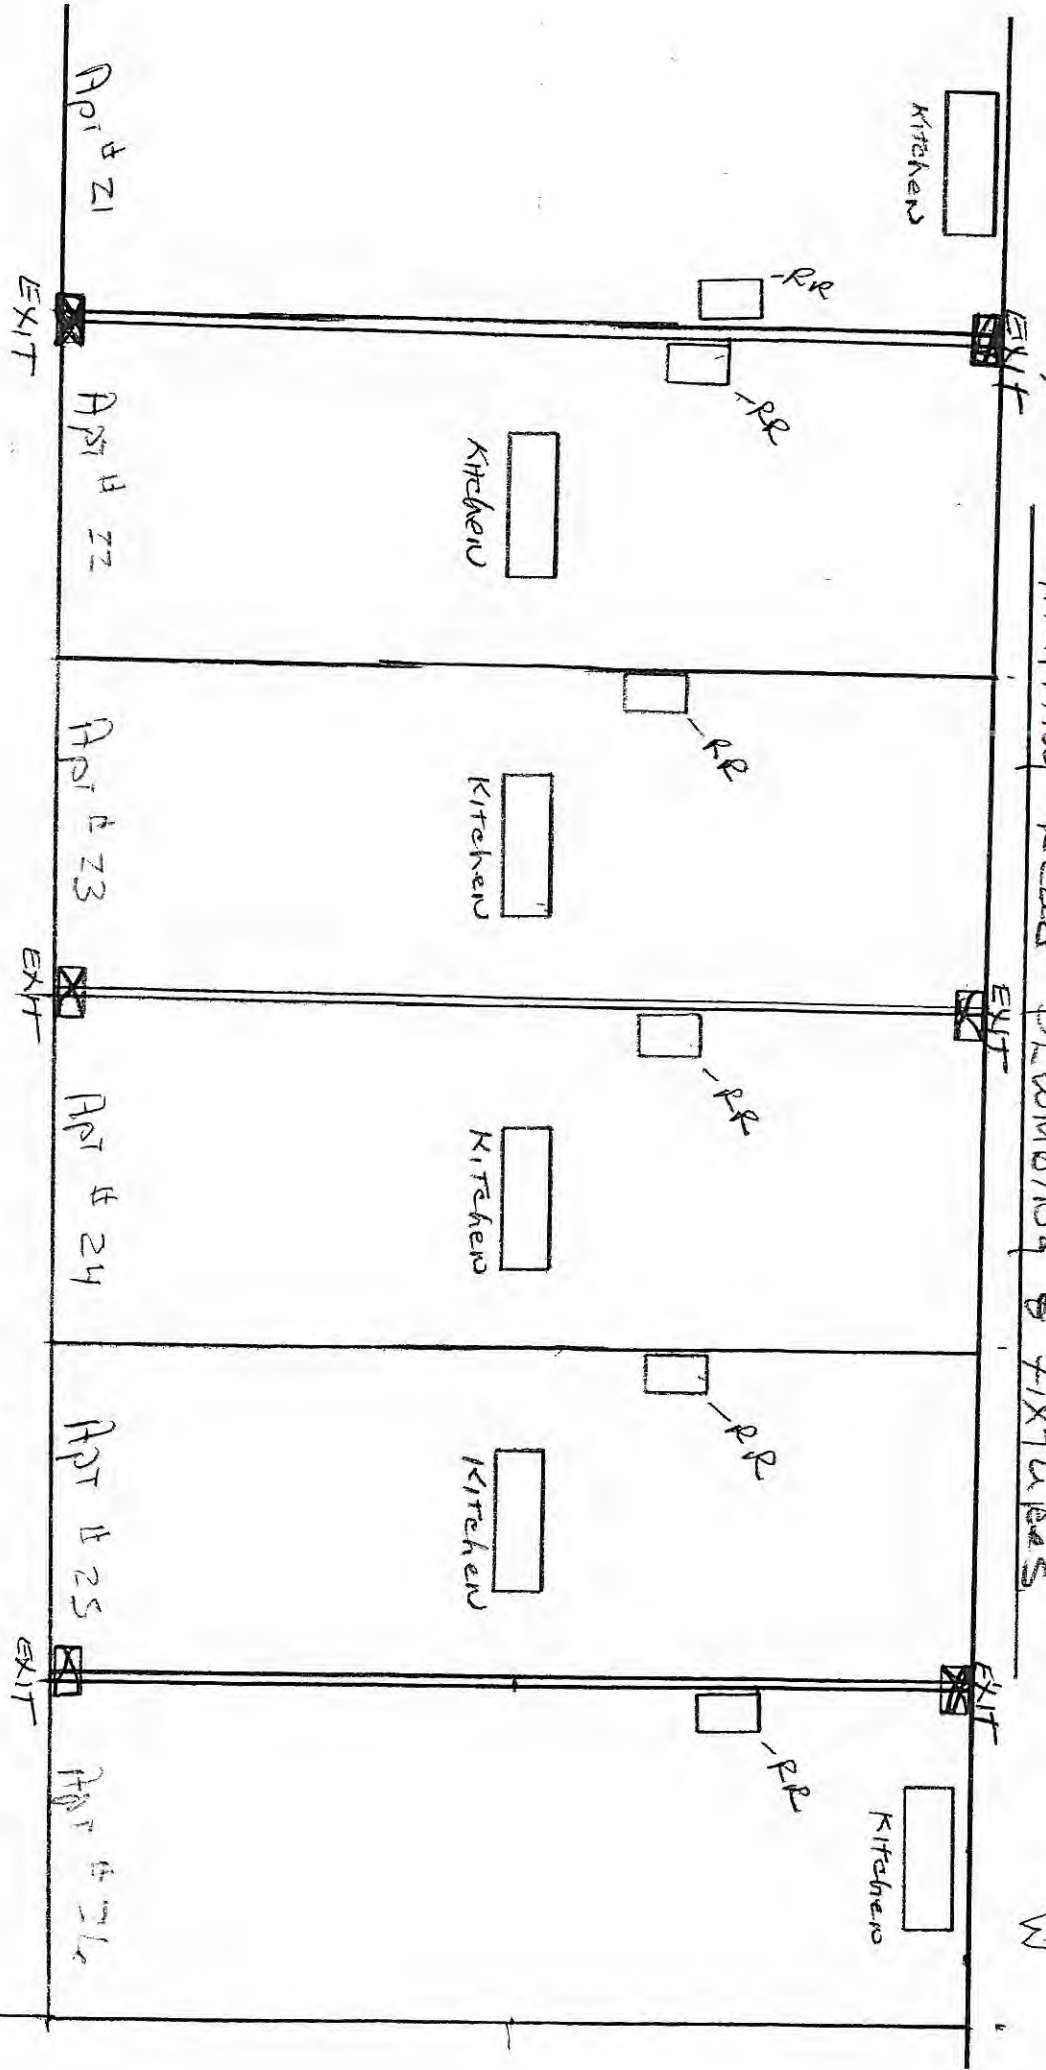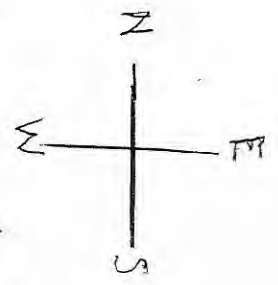



North Parking

Fixture Material Unknown  
 Copper Piping

- POINT LEAD
- OTHER ---
- LEAD

Lake Avenue Terrace  
 237 Lake Ave.  
 Hartsville, Ohio 44632  
 3307 231-5193

MAPPING LEAD PLUMBING & FIXTURES

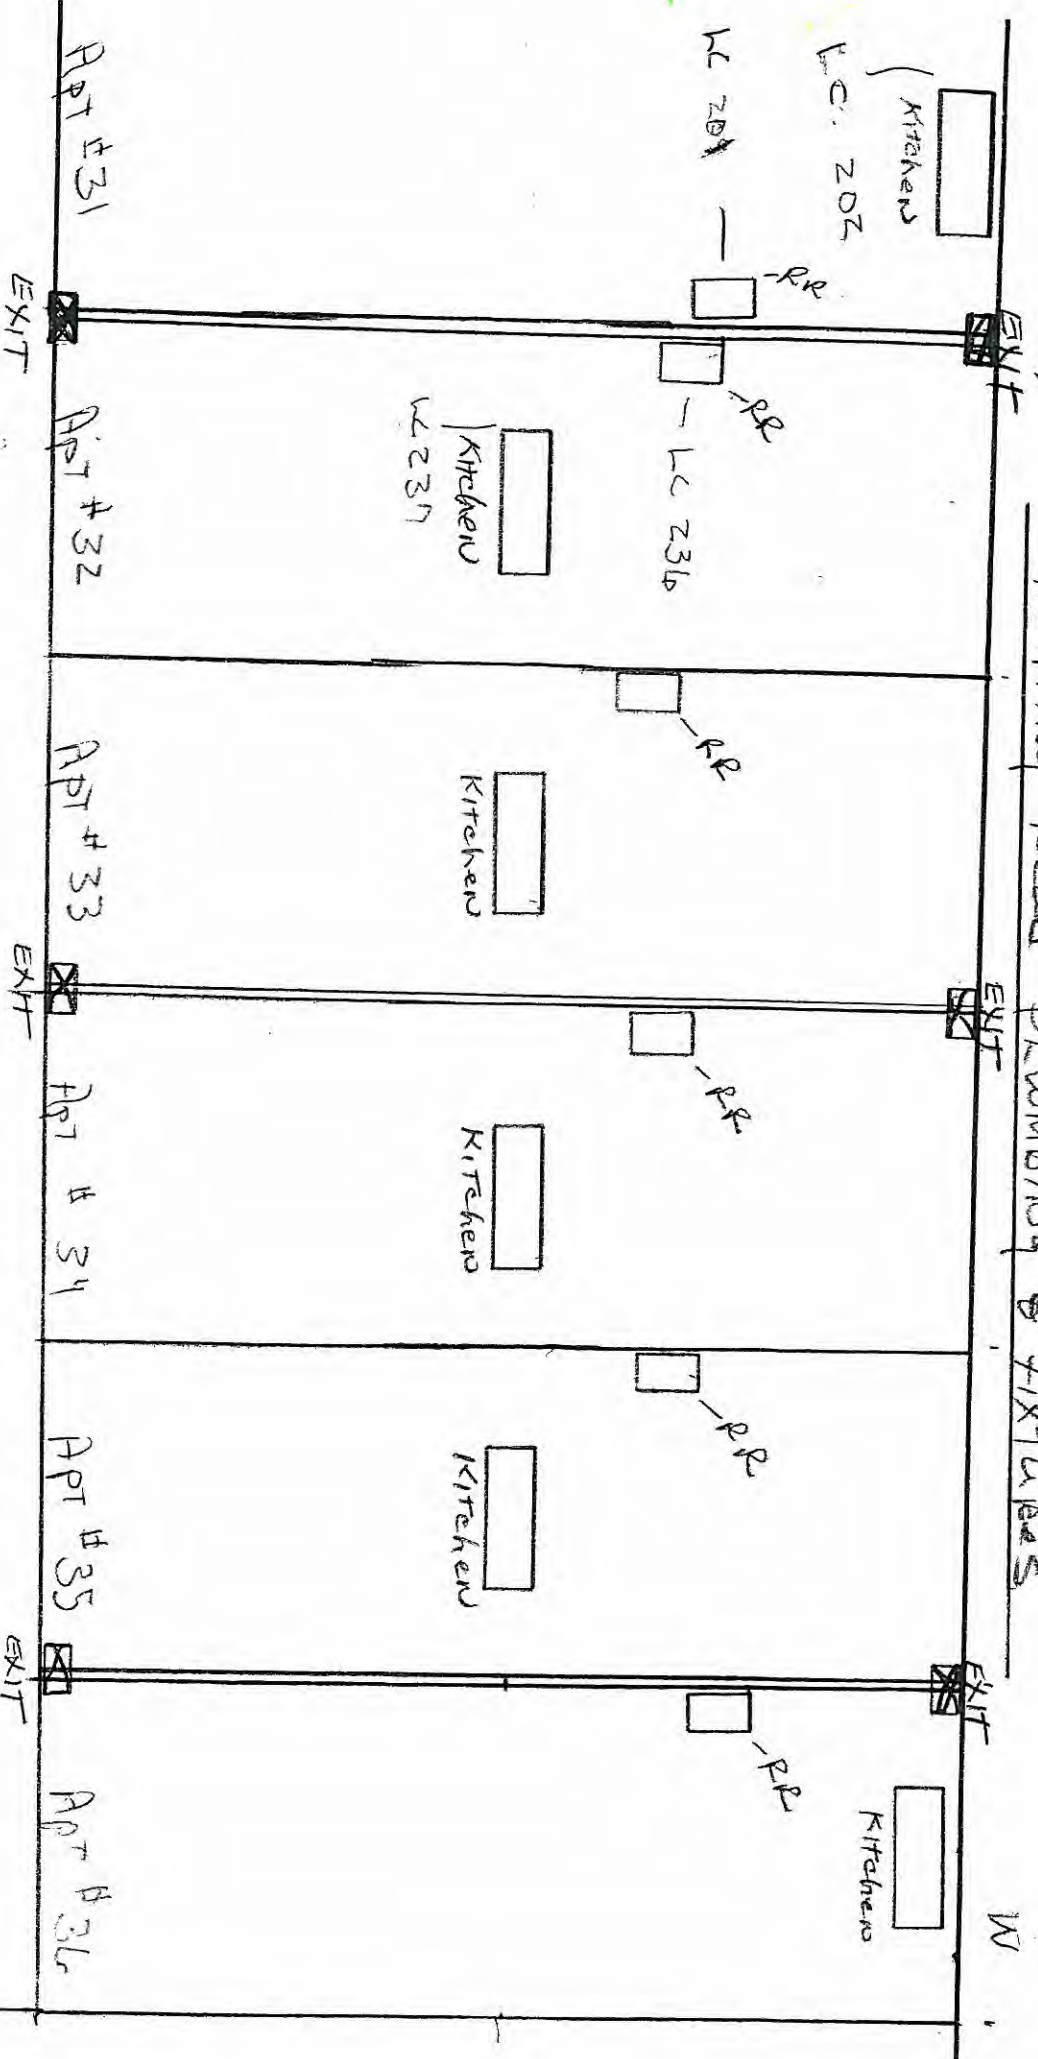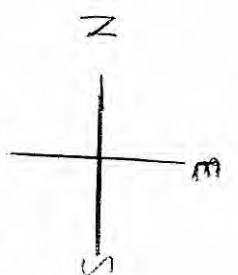



North PARKING

Fixture MATERIAL unknown  
 Copper Piping

- NONE LEAD
- OTHER
- LEAD

Lake Avenue Terrace  
 235 Lake Ave.  
 Hartsville, Ohio 44632  
 330-231-5193

MAPPING LEAD PLUMBING & FIXTURES

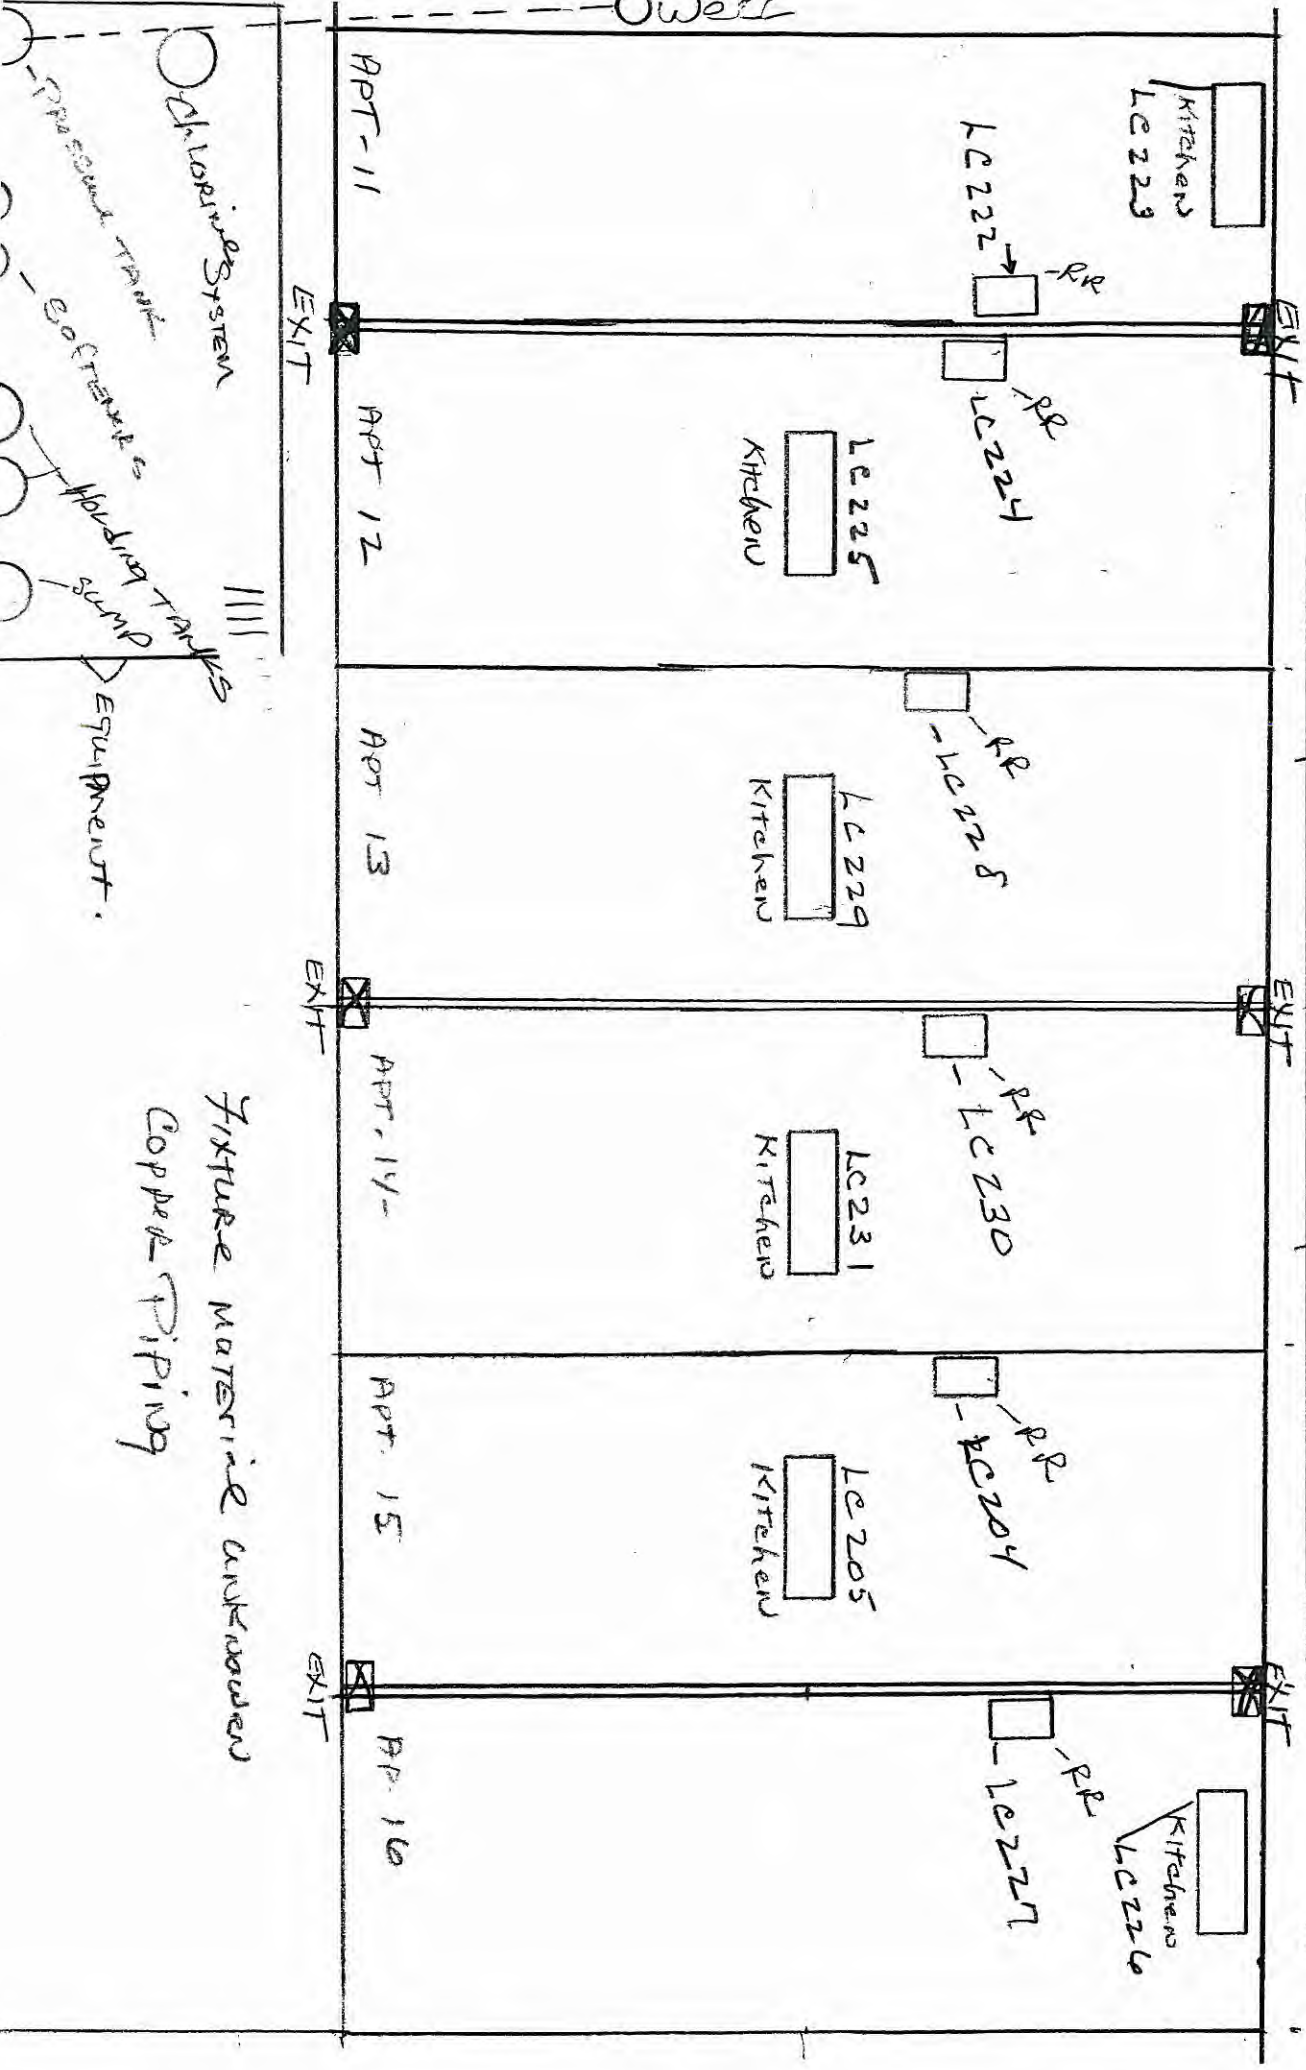
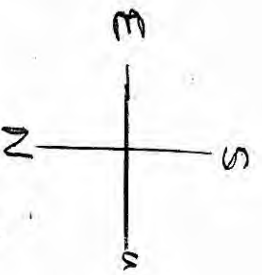


Fixture Material unknown  
 Copper Piping

- - NONE Lead
- - OTHER ---
- - Lead

Lake Avenue Terrace  
 235 Lake Ave.  
 Hartsville, Ohio 44632  
 330-231-5193

MAPPING Lead Plumbing & FIXTURES

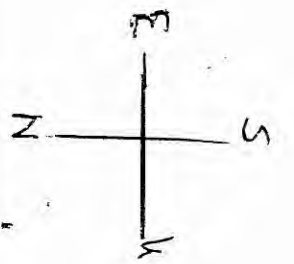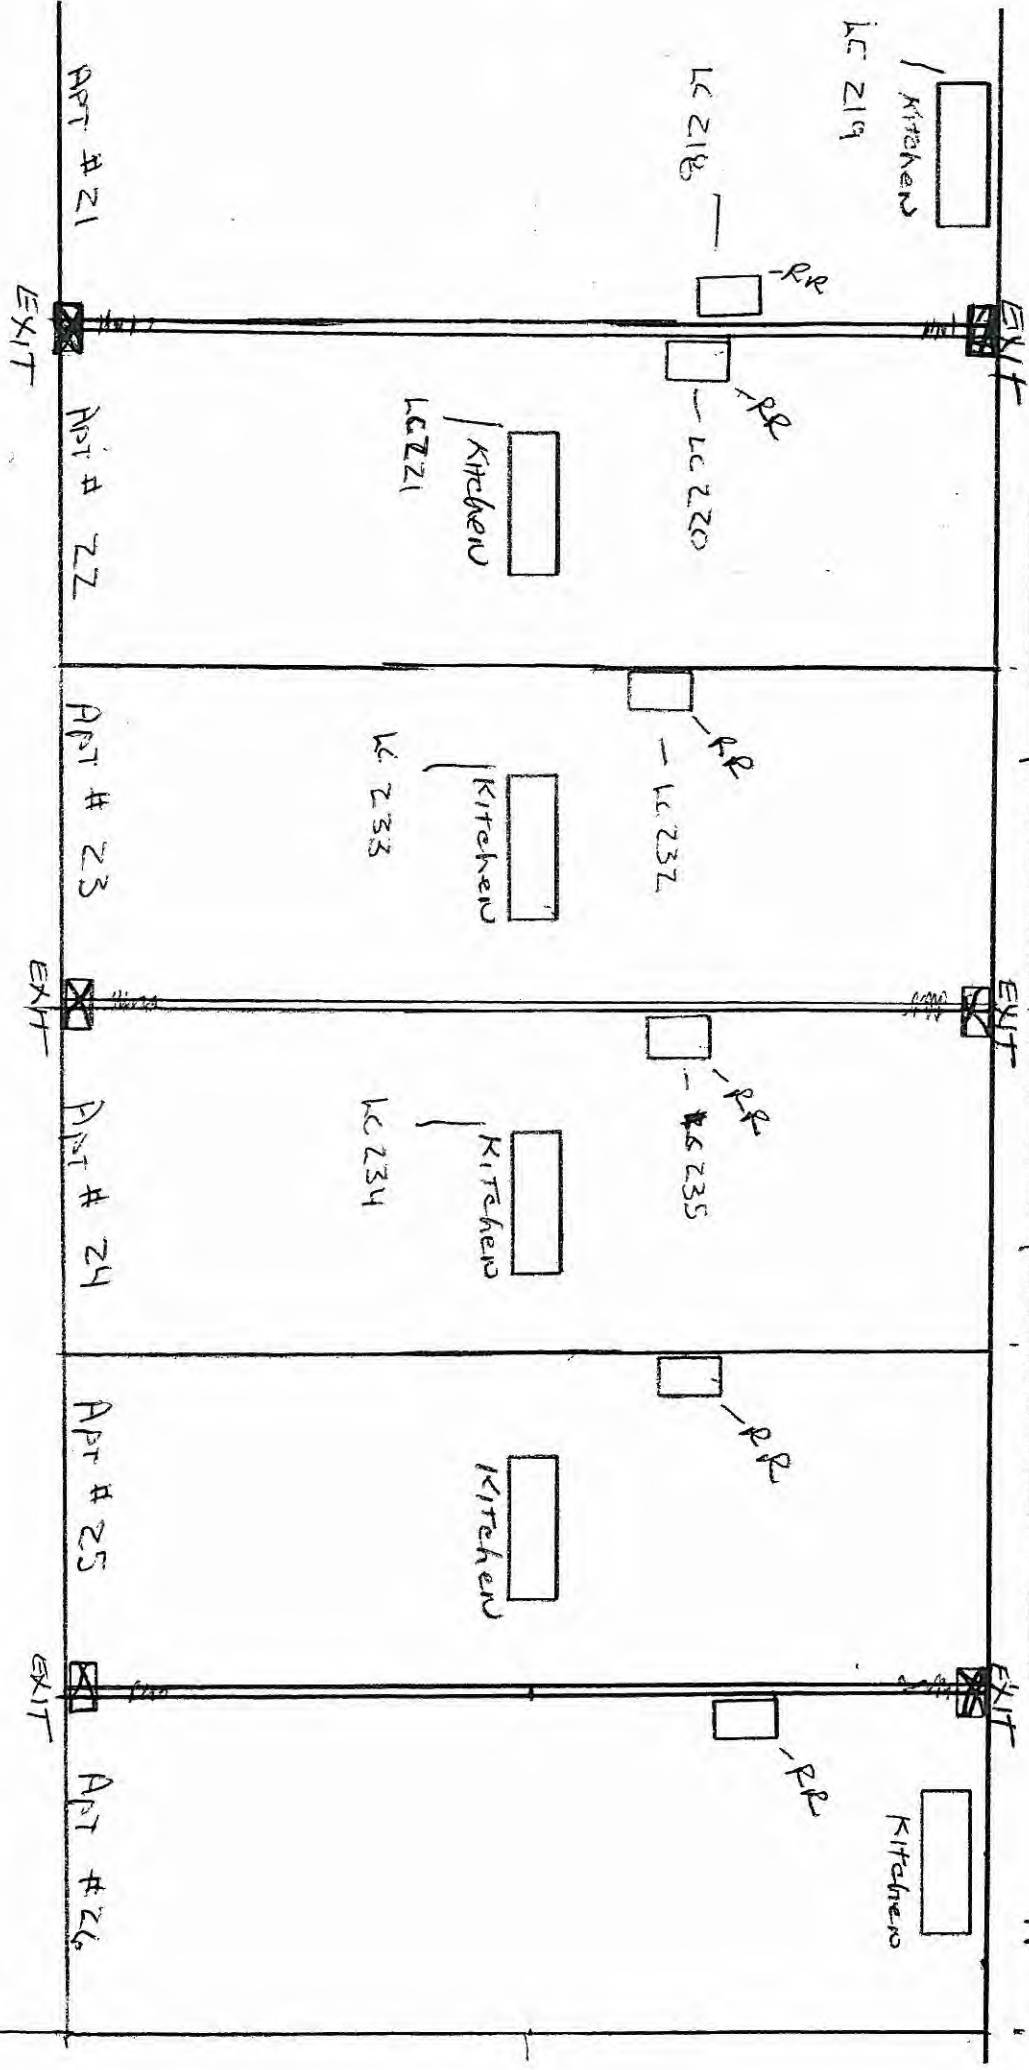



North PARKING

Future material unknown  
 Copper - SP, P, MB

- Done Lead
- Other
- Lead

Lake Avenue Terrace  
 #35 Lake Ave.  
 Hartsville, Ohio 44632  
 330-231-5193

MAPPING LEAD PLUMBING & FIXTURES

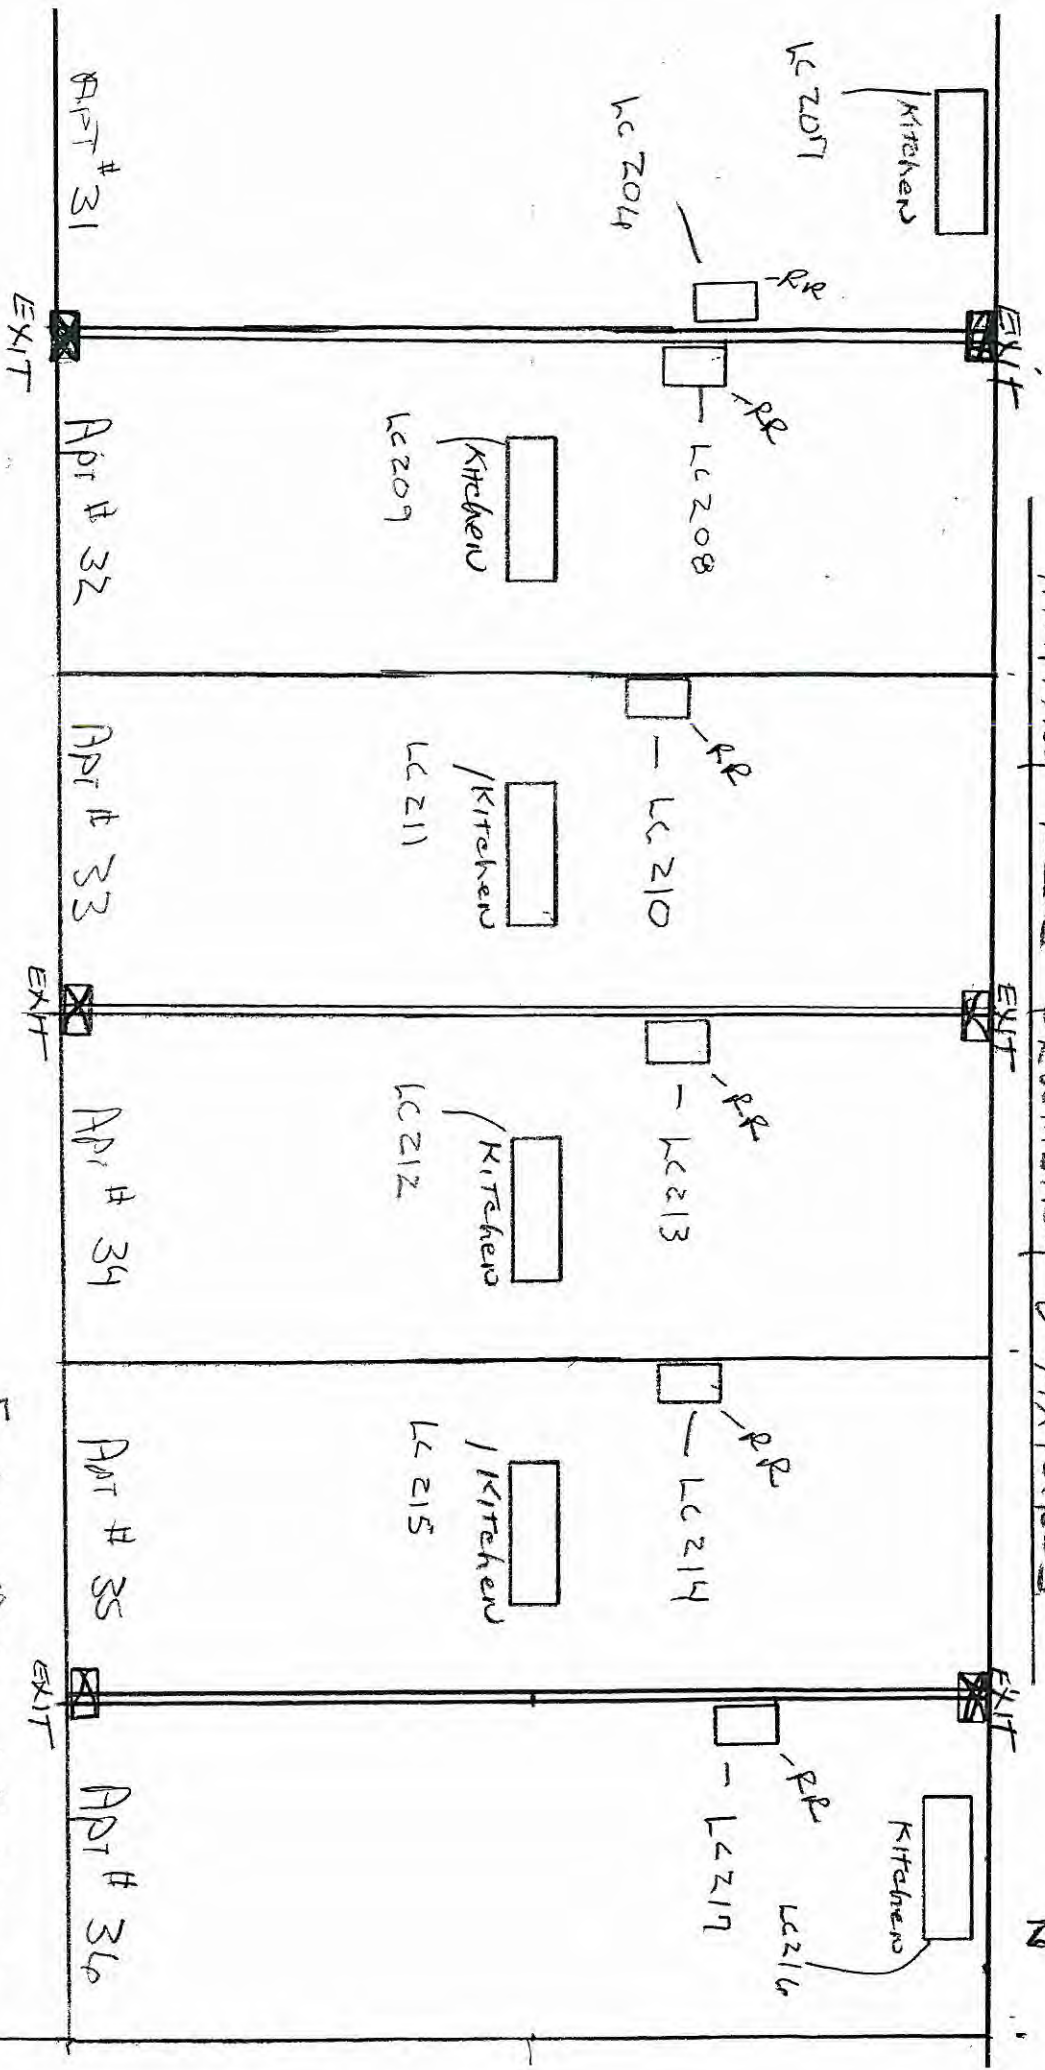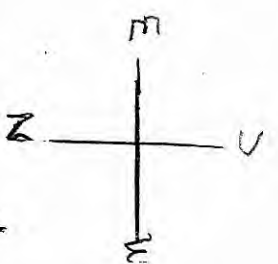

North PARKING

Fixture MATERIAL UNKNOWN  
 Copper PIPING