
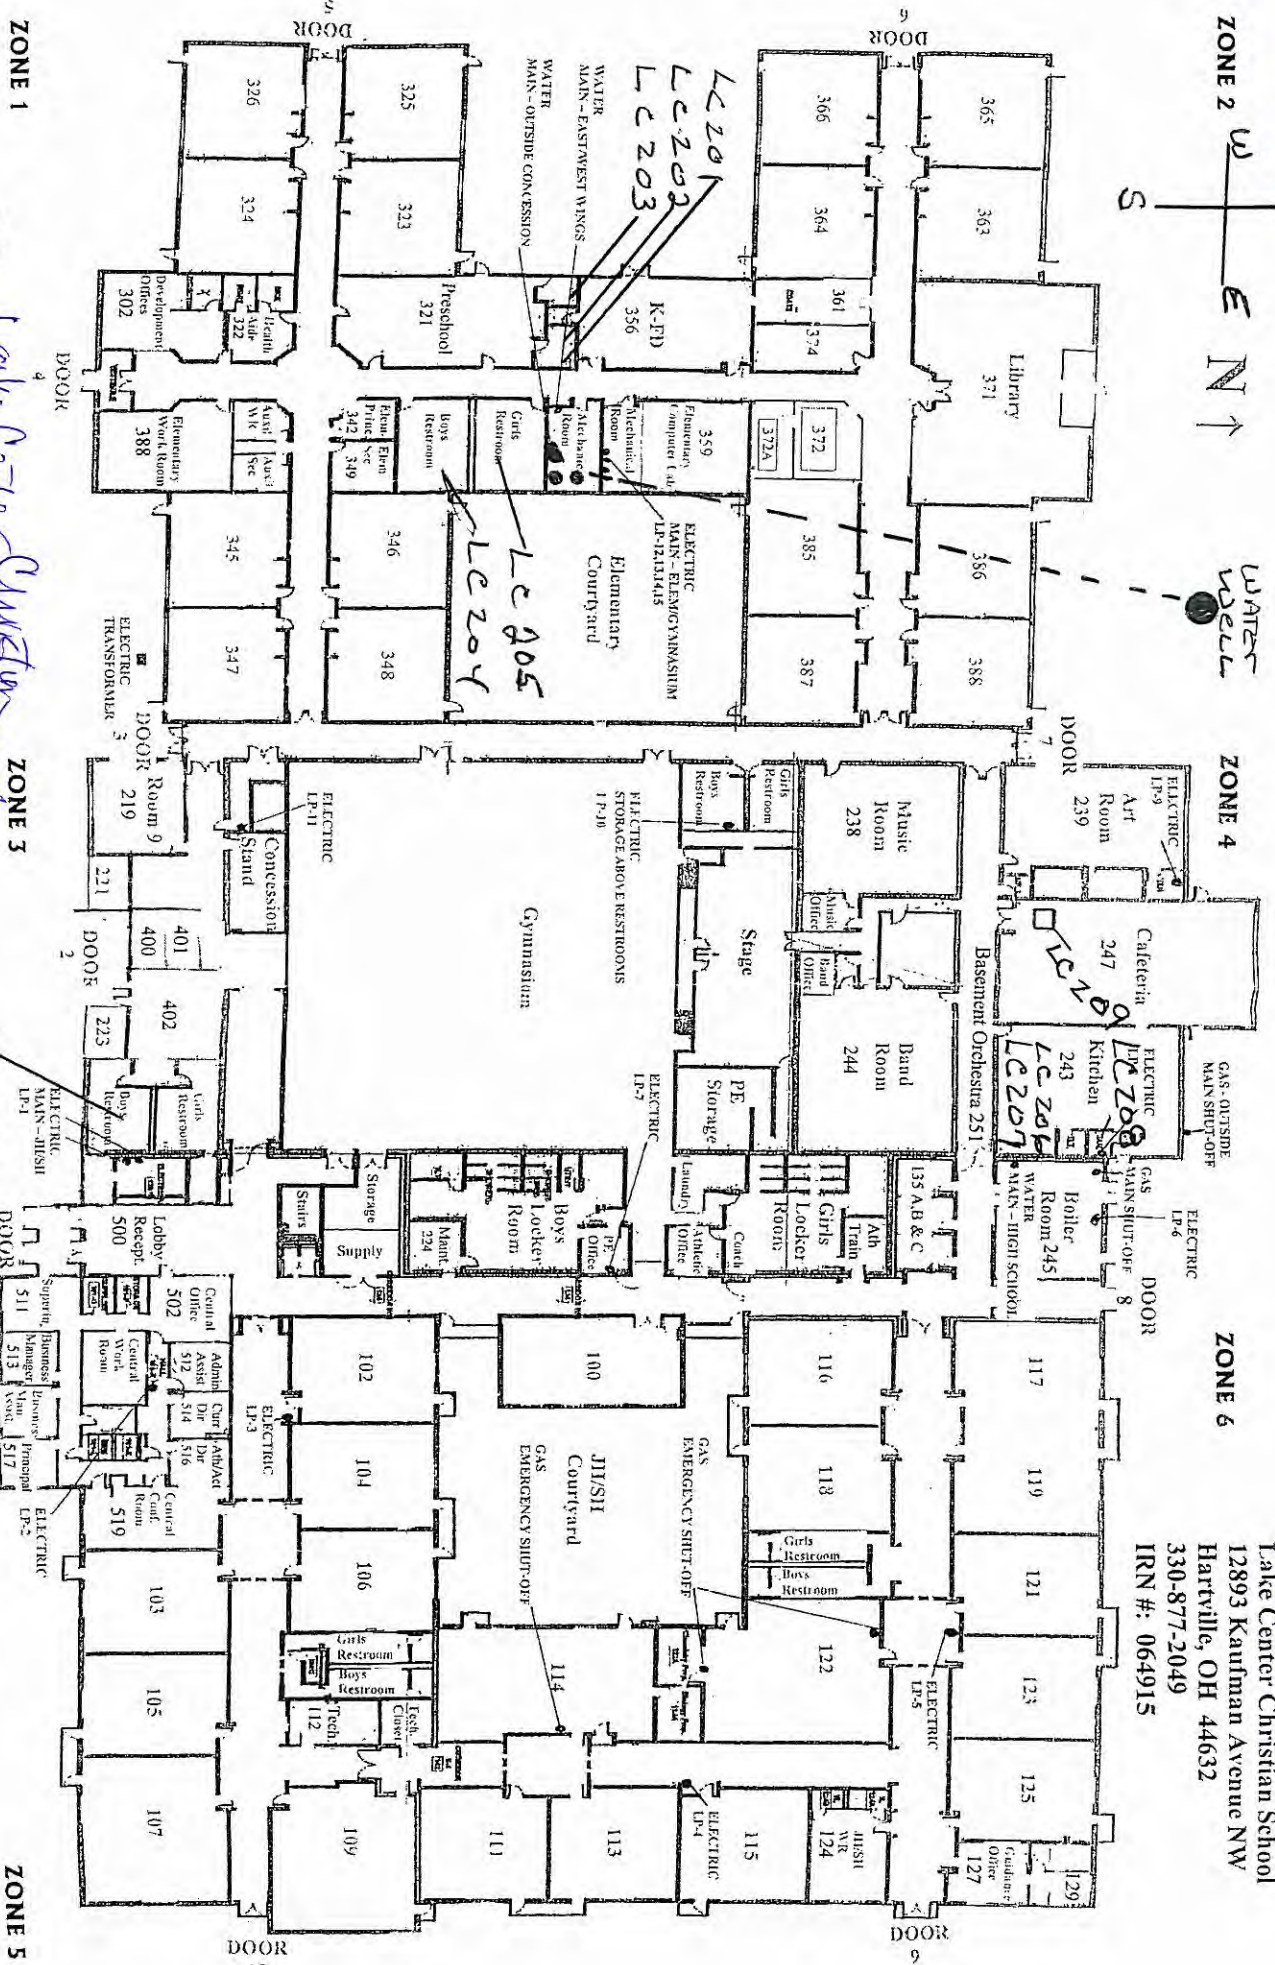


- None Lead
- Other -----
- Lead .N

MAPPING LEAD PLUMBING + FIXTURES

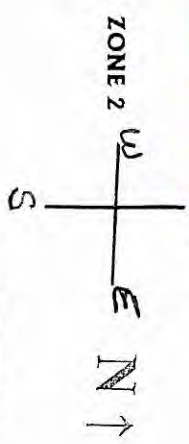

0476 53912
 Lake Center Christian School
 12893 Kautman Avenue NW
 Hartsville, OH 44632
 330-877-2049
 IRN #: 064915

Entity: Lake Center Christian School
 Doc Type: REPORT
 Doc Subtype: DRAGN
 Program: STATE

COPPER PIPING
FIGURE MATERIAL UNKNOWN

ZONE 1

ZONE 2

ZONE 4

ZONE 6

ZONE 3

ZONE 5