


MAPPING Lead PLUMBING + FIXTURES

- None Lead
- Other -----
- LEAD

CHAPEL IN MARLBORO
 8700 EDISON
 LOUISVILLE OHIO 44641
 OH7671212

336-388-2934

ALL COPPER MAPPING
 FIXTURE MATERIAL
 UNKNOWN

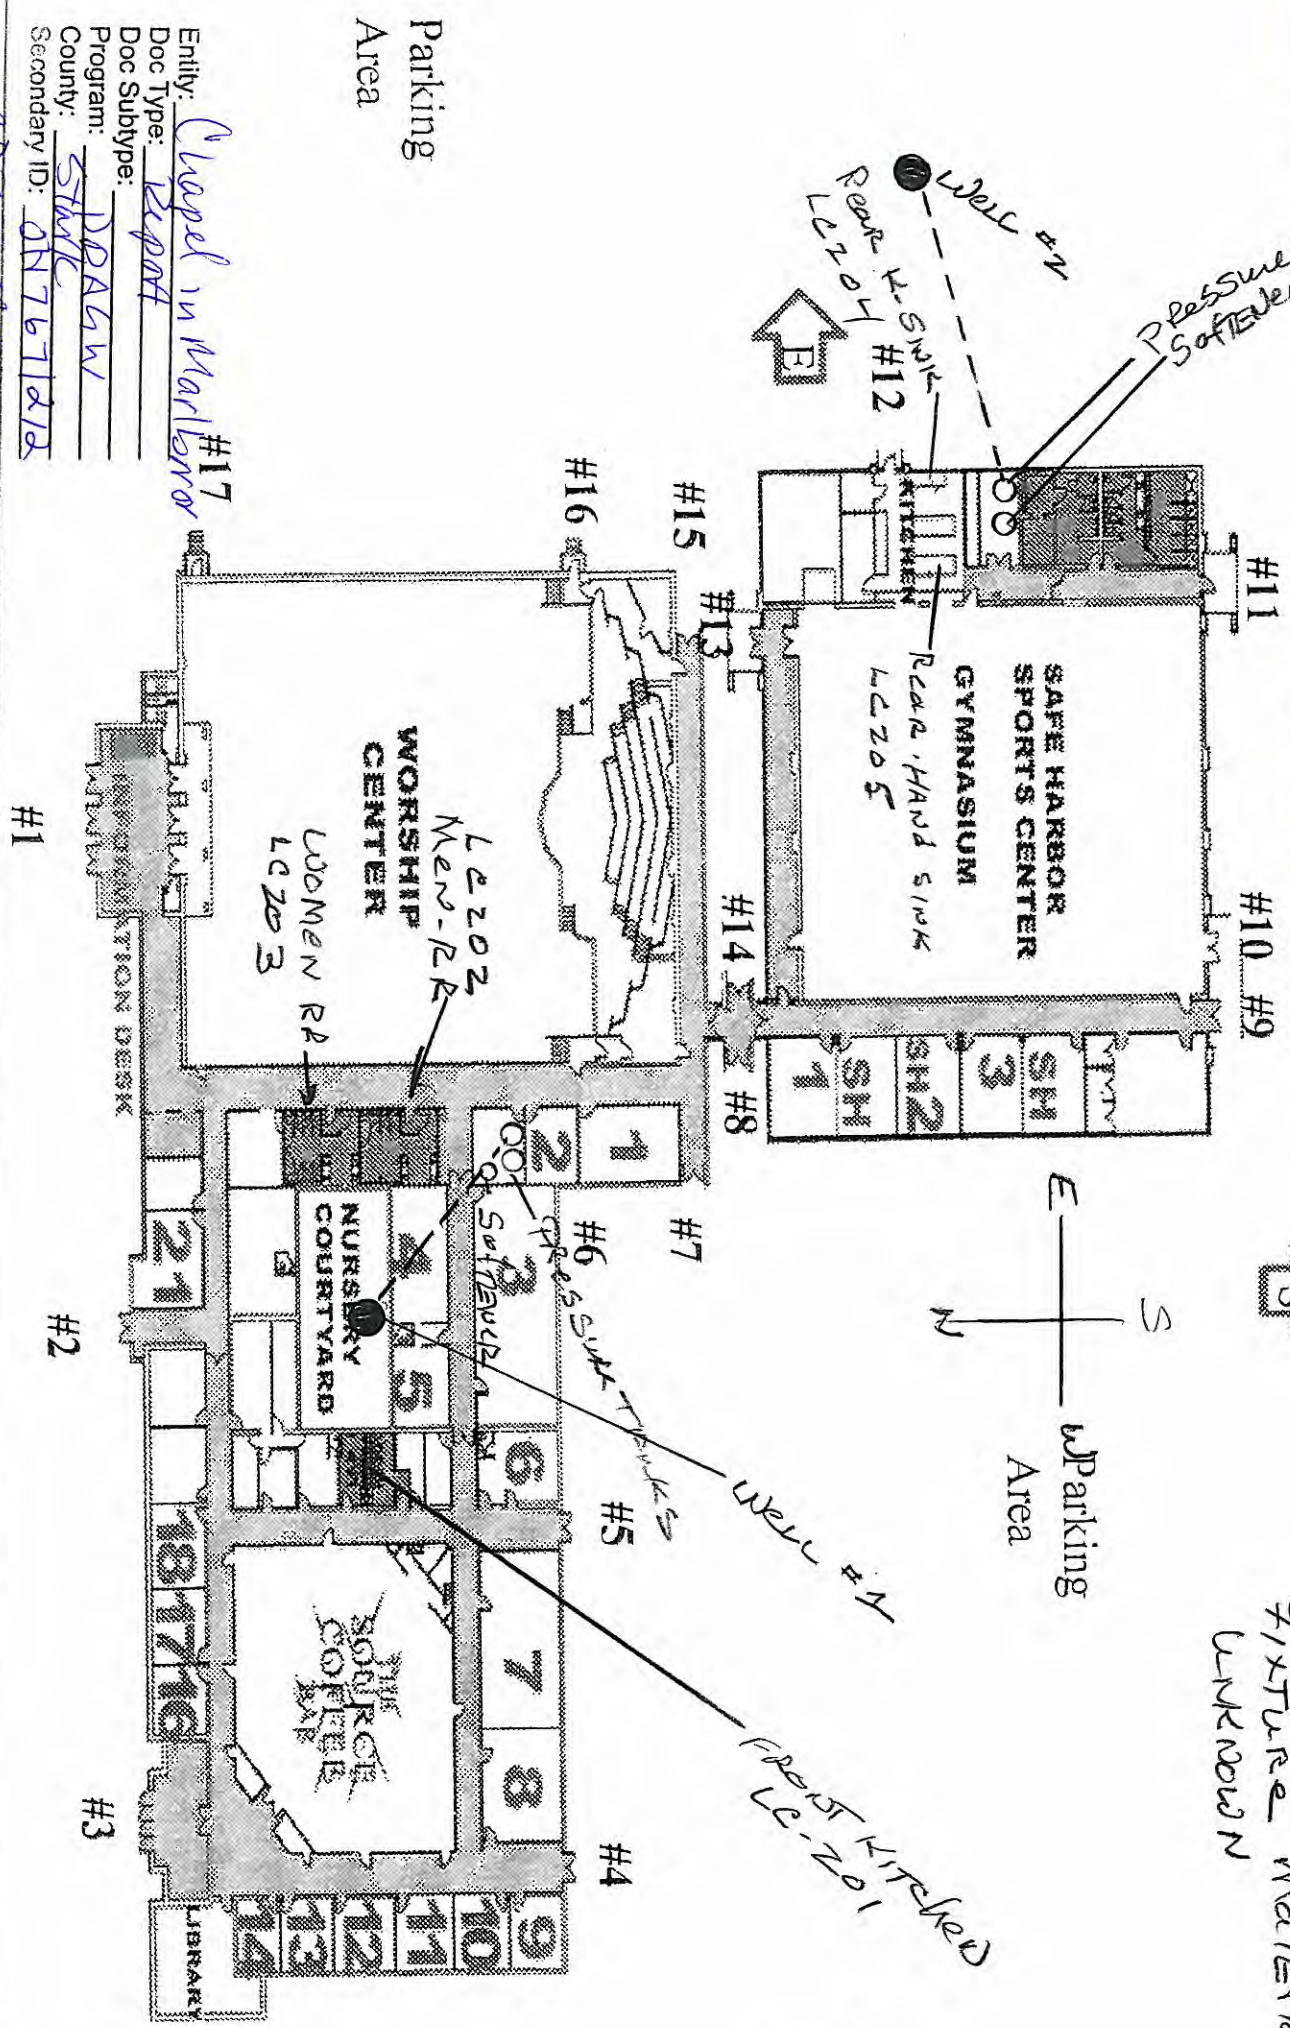

Parking Area

Entity: Chapel in Marlboro #17

Doc Type: Report




Secondary ID: OH7671212

Rt-619 EDISON ST.