

MAPPING Lead Plumbing + Fixtures


KITCHEN SINK

Patio Door Exit


ENERVEST OP. LLC.
125 W. 43
HARTVILLE, OHIO 44632
330-877-6747
0416785a1d

Styler Room

Well Data

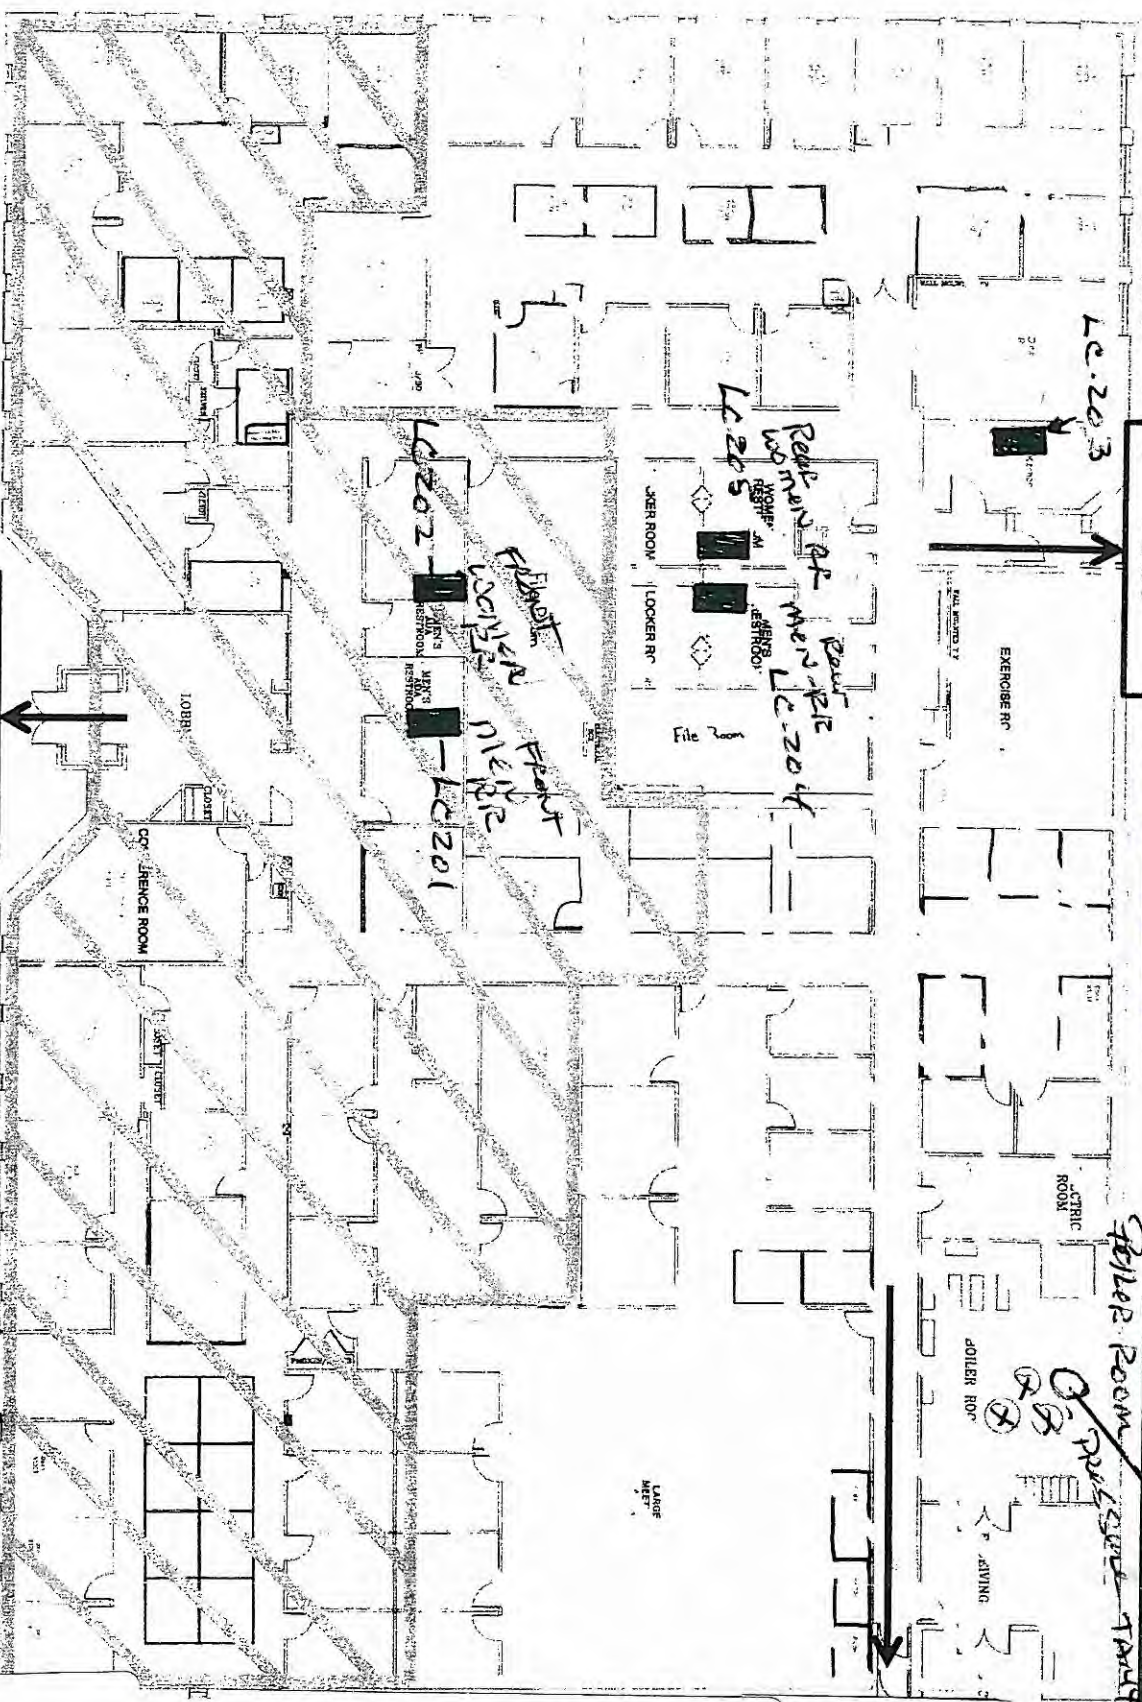

Updated 11/13/2012

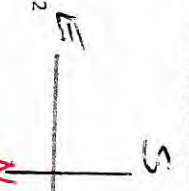

Front Door Exit

FRONT OF BUILDING

Doc Type: Enervest Hartville
Doc Subtype: Report
Program: BDRM
County: Putak
Secondary ID: 0416785a1d
- Sink
- Sink

- None Lead
- Other
- Lead
- ALL
- copper piping
- Fixture Material Legend