

RT-619

PARKING

- Lead
- None Lead
- other ---

ALL COPPER PIPING
 FIXTURE MATERIAL UNKOWN

HARTVILLE MARKET PLACE
 1089 MARKET AVE
 HARTVILLE, OHIO 44632
 330-877-9860
 ON 7673312


PARKING

MAPPING Lead Plumbing & FIXTURES

MAIN ENTRANCE

Main Floor

SARA GAIL

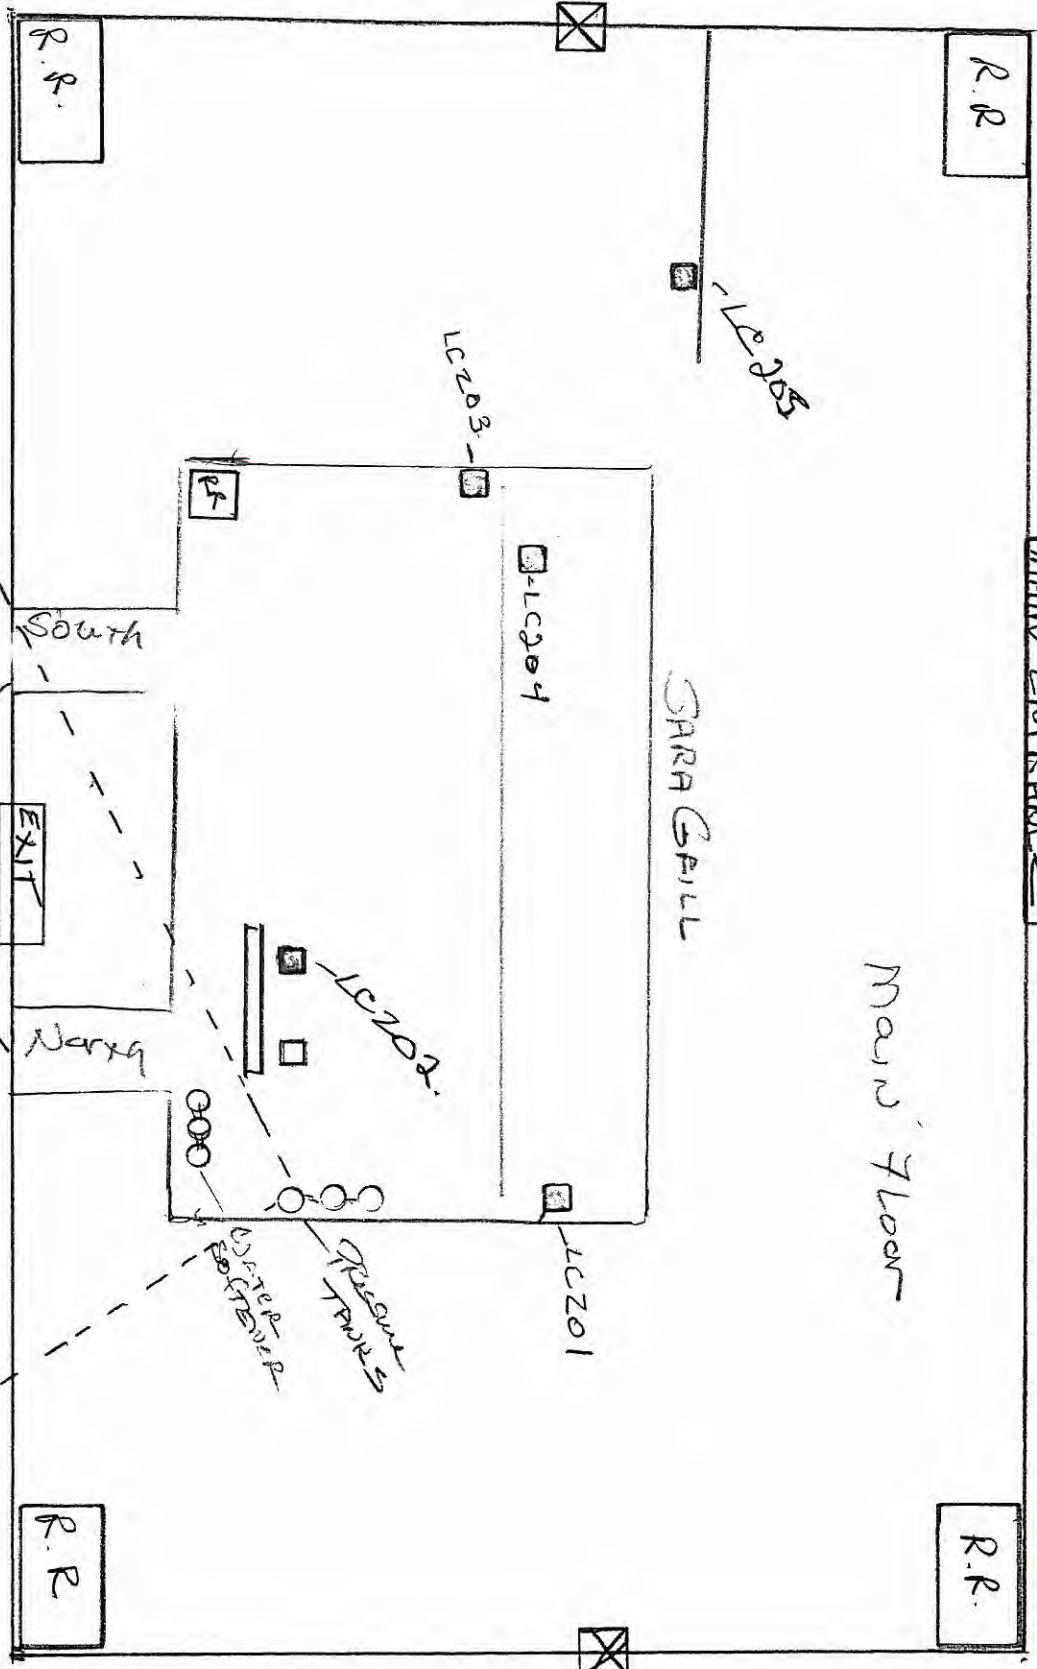

Entity: Hartville Market
 Doc Type: REPORT
 Doc Subtype: DDRAWN
 Program: START
 County: OH 7673312
 Secondary ID: 2 DEC in sin

