


MAPPING Lead Plumblings + Fixtures



- None Lead.
- Other -----
- Lead.

ALL COPPER PIPING
 FIXTURE MATERIAL
 UNKNOWN

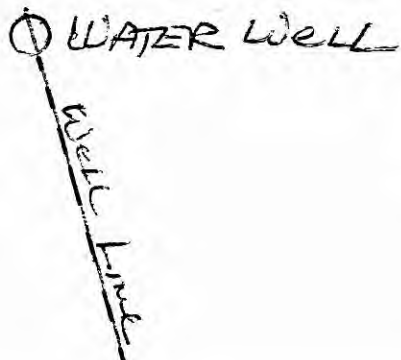

Entity: Quikrete Companies
 Doc Type: Report
 Doc Subtype: BOAW
 Program: Parake
 County: Parake
 Secondary ID: 28678013
 EDOC in color

DRIVE WAY

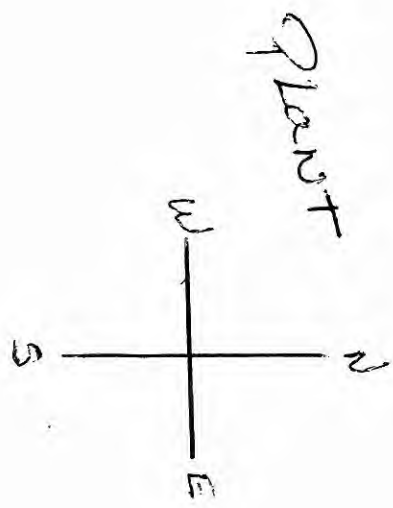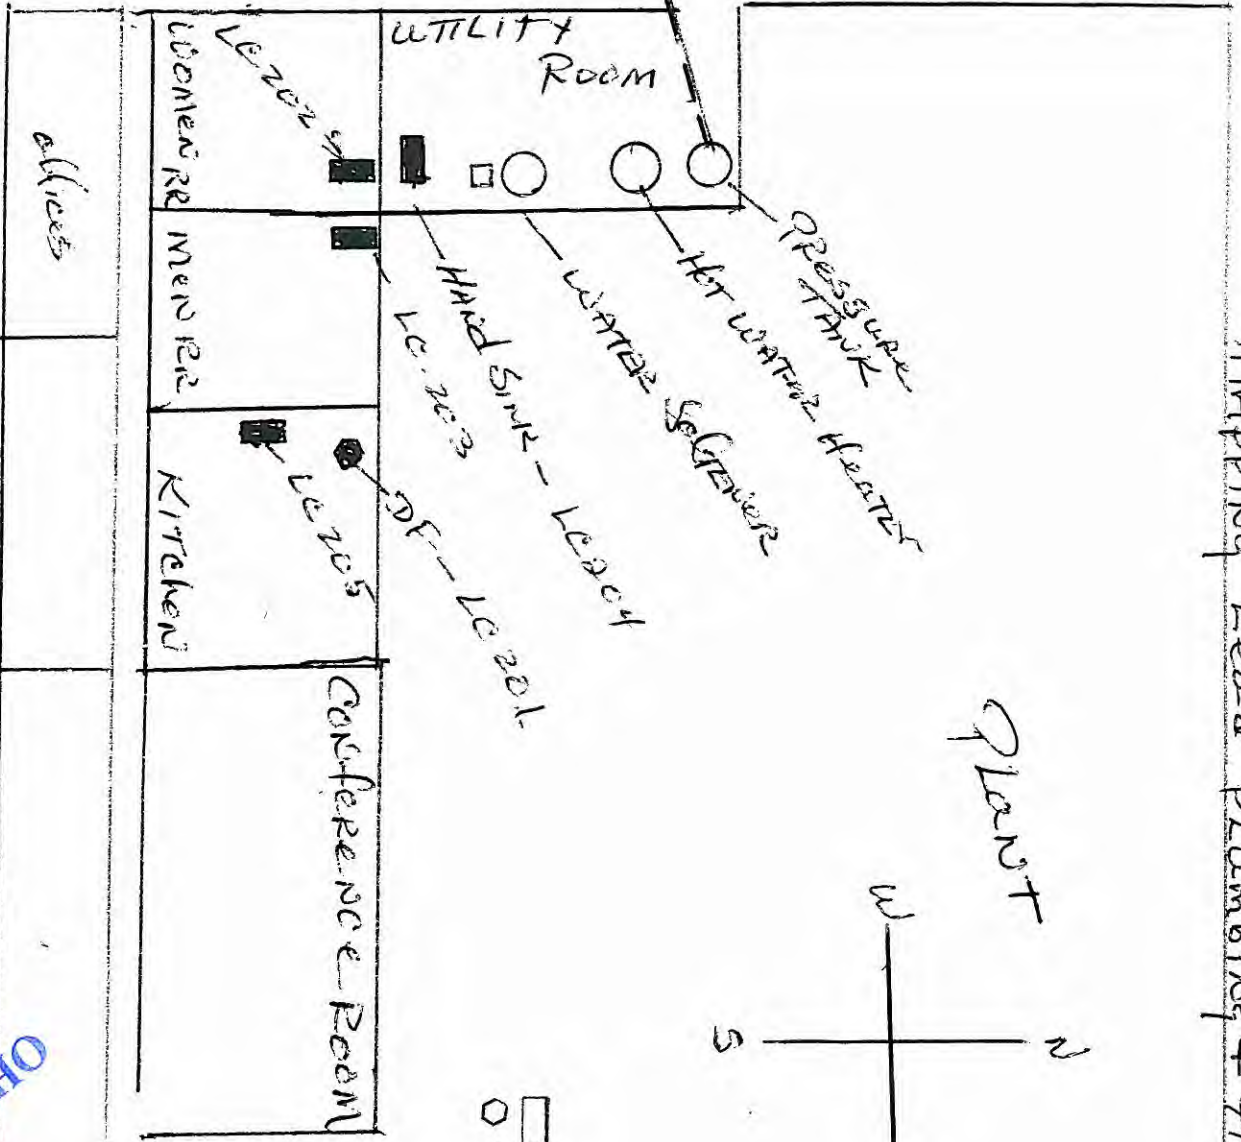

□ - SINK
 ○ - D/F

QUIKRETE COMPANY
 PUS. 046781012
 330.296.6080
 2693 Linda Rockwell Rd Ravenna

RECEIVED
 FEB 24 2017
 OHIO EPA NEDO