



Korda Mfg.
3929 LINCOLN WAY EAST
WOOSTER, OHIO 44691 330-262-1555
OH8546112

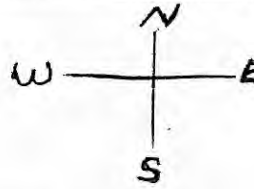

- NONE LEAD
- OTHER ----
- LEAD

ALL COPPER PIPING
FIXTURE MATERIAL UNKNOWN

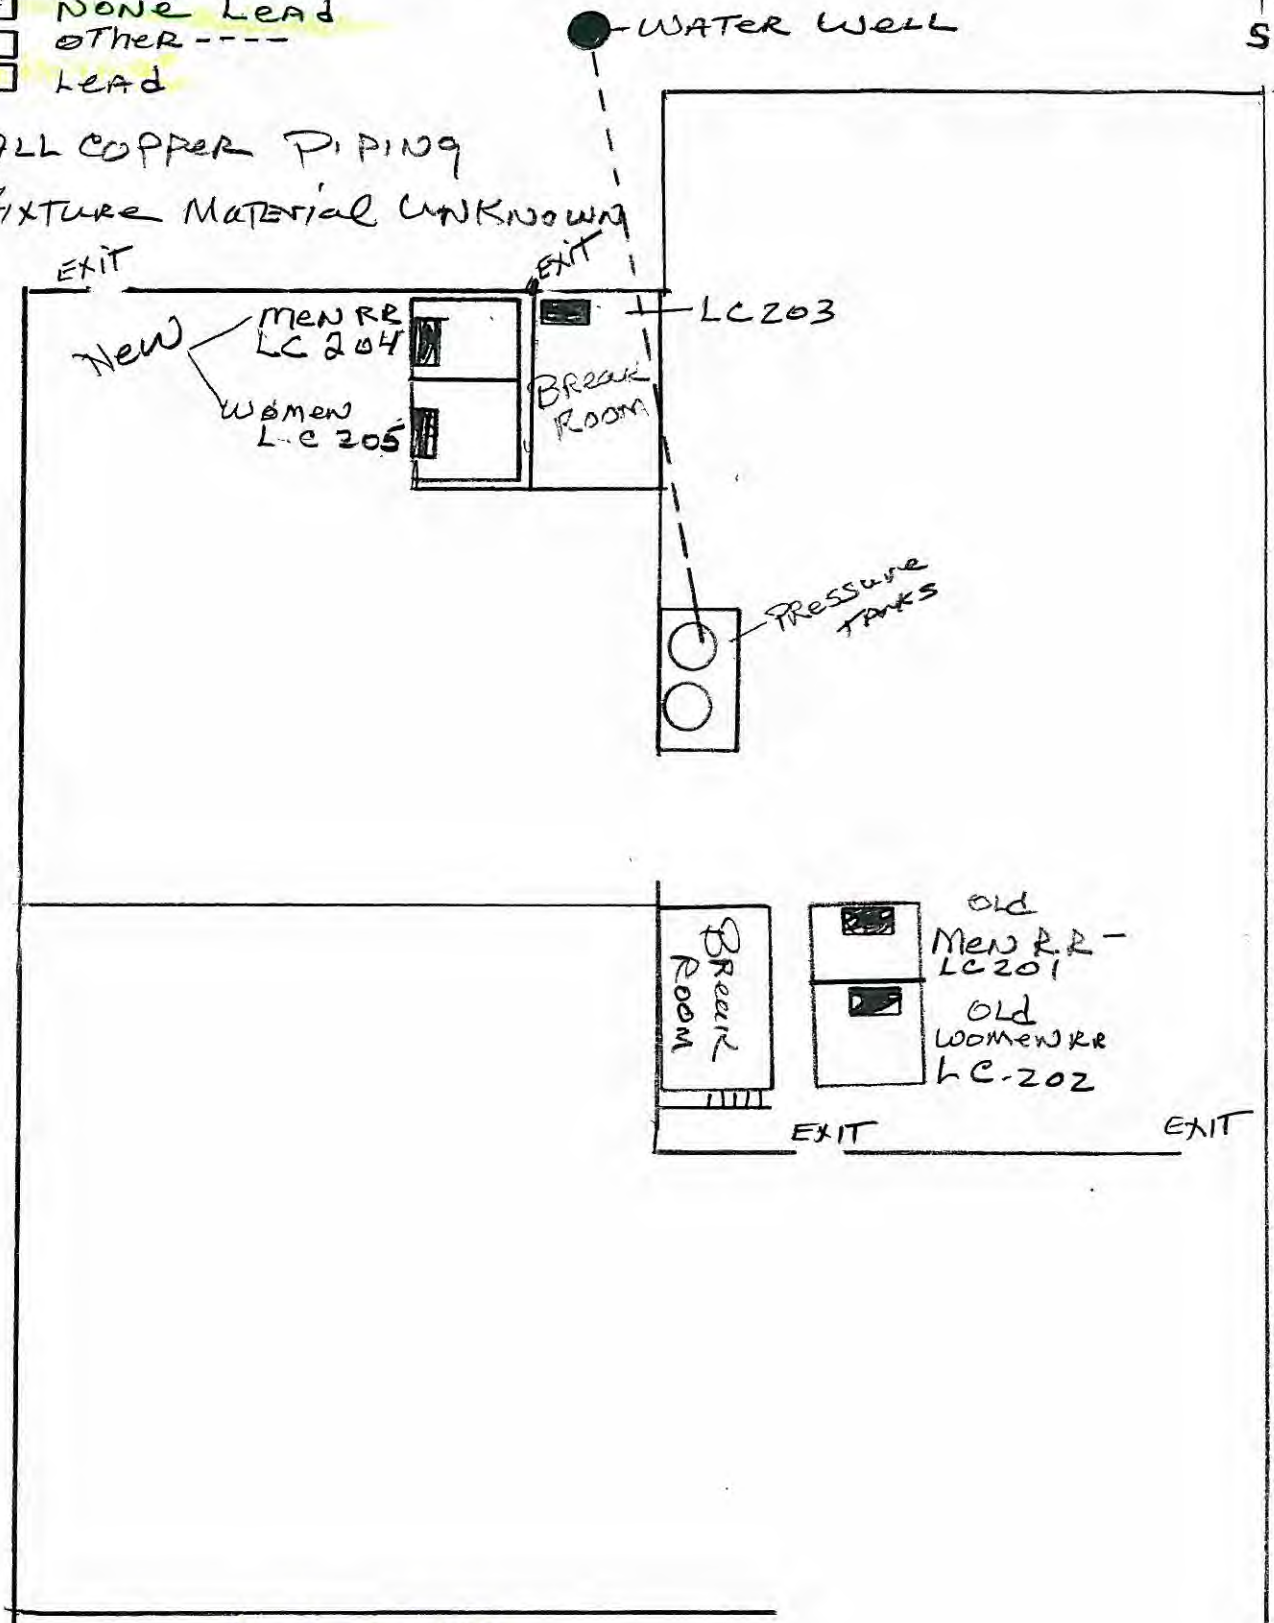

Entity: Korda Manufacturing Bldg 2 Rear
 Doc Type: Report
 Doc Subtype: _____
 Program: DDAGW
 County: Wayne
 Secondary ID: OH8546112
eDc in Color