


WEST MAPLE ST. RT 619

MILAN AVE.

GRAND TRUNK AVE.

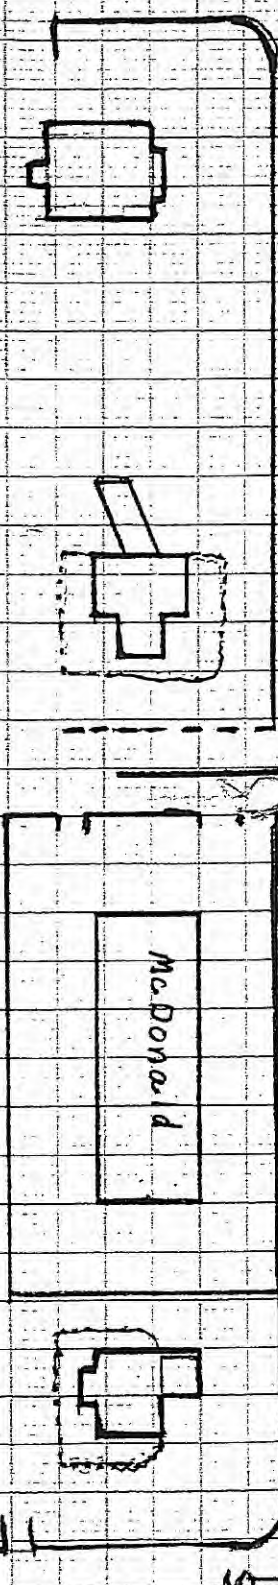

MARCS

Goodwill

Hand Sink
 LC 201
 Men's R
 LE 202
 Women's R
 LE 203

BIG LOTS

Men's R
 LC 204
 Women's R
 LE 205

EDISON PARK PLAZA
 810-854 WEST MAPLE
 HARTVILLE, OH 44632
 216-860-9111

- None Lead
- Other - - - -
- Lead

ALL COPPER PIPING
 FIXTURE MATERIALS
 UNKNOWN

EDISON PARK PLAZA

OH 7669212

SUNNYSIDE ST.

Entity: DPALM
 Doc Type: REPORT
 Doc Subtype: DPALM
 Program: STARS
 County: OH 7669212
 Secondary ID: OH 7669212
2 DOC IN COLOR