

RECEIVED

# OHIO EPA NEDO Manchester United Methodist Church

5625 Manchester Rd.  
Akron, OH 44319  
E-mail: [mumc5625office@att.net](mailto:mumc5625office@att.net)  
Telephone: (330) 882-4818

Senior Pastor Dale R. Gharky  
Sandra McCausland, Secretary  
Robert Chu, Organist  
Robert Putt, Music Director

2017 JAN 30 AM 8:01  
RECEIVED  
DDAGH

## FAX COVER SHEET

TO:

Name: PATRICIA VANAH

Company/Dept.: OHIO EPA NORTHEAST DIST.

Entity: Manchester UMC

Doc Type: Report

FAX#: 614-644-2909

Doc Subtype:

Program: DDAGH

County: SUMMIT

Secondary ID: DN7762816

FROM: ROBERT PUTT

DATE: 1-29-17

NUMBER OF PAGES INCLUDING COVER SHEET: 2

### SPECIAL INSTRUCTIONS:

• ATTACHED IS LAYOUT OF CHURCH WITH INFO  
RELATED TO YOUR 1-10-17 LETTER & MR BAKER'S 1/17  
LETTER.

• YOU SHOULD HAVE ON FILE AN OVERHEAD PHOTO  
SHOWING CHURCH LOCATION DETAIL

• I HAVE NOTED TEST LOCATIONS FOR LEAD & COPPER

• DOES THIS SUFFICE?

MY PHONE IS 330 882 3396



EMAIL ROBERT PUTT @ ATT.NET

*Thank you*

**MANCHESTER UNITED METHODIST CHURCH**  
**5625 Manchester Road**  
**Akron, Ohio 44319**

1-27-17

330.882.4818  
 OH7762812

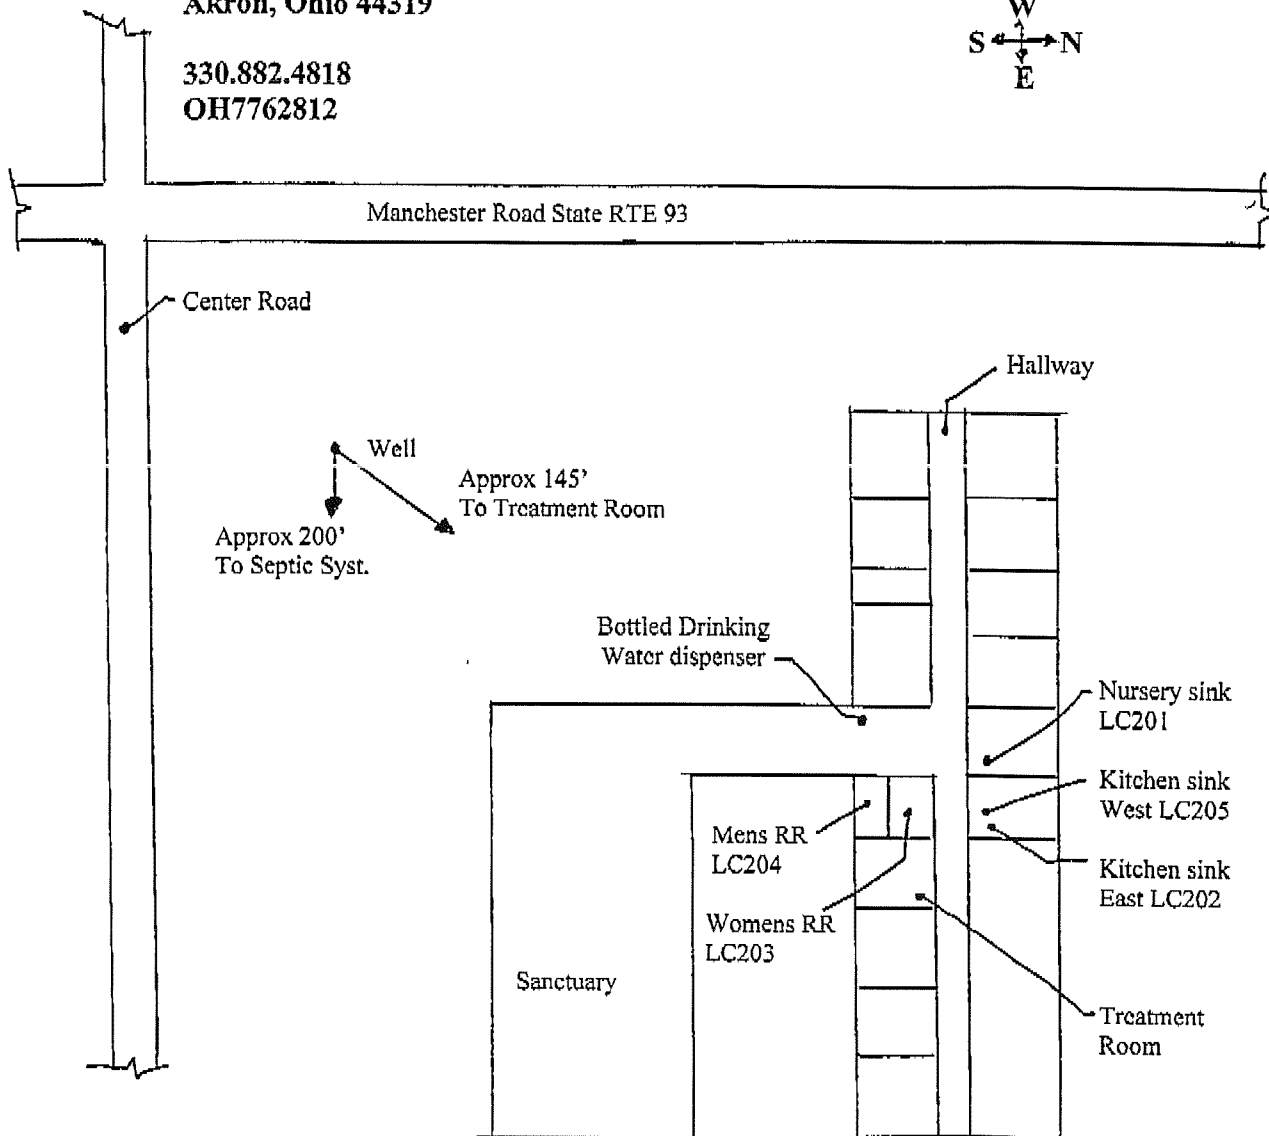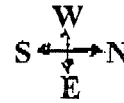

**Notes:**

1. Treatment room contains Pressure tank, Softener, Water heater, Janitor sink and Boiler for facility hot water heat.
2. Hot and Cold water piping North of Hallway is PEX, installed 2/13/16.
3. Interior water piping south of Hallway is copper. Church was built around 1960.
4. Well piping material is Polypropylene.
5. Service line from well to Treatment room is Polypropylene.