


Ohio PWS Oh 2853412

- 1 LC 201 = Employee Restroom sink
- 2 LC 202 = Employee Hand sink
- 3 LC 203 = Dish sink
- 4 Women's Restroom 1st Hand sink
- 5 Men's Restroom 1st Hand sink

1 FLOOR PLAN  
A1.0 1/4" = 1'-0"  
1" = 4"

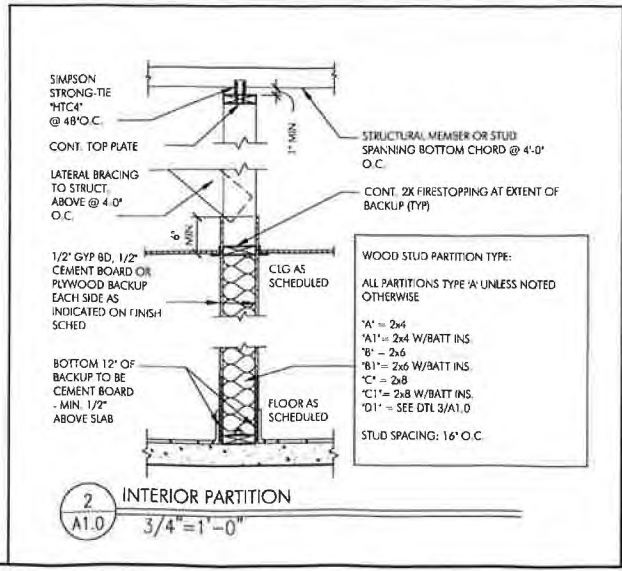

**KEY NOTES**

- NEW CHASE FOR ICE MACHINE PIPING
- NEW COLUMN SEE STRUCTURAL
- NEW CASH BOOTH WINDOW
- RELOCATE EXISTING EQUIPMENT TO NEW LOCATION, RECONNECT EXISTING CONNECTIONS - PER OWNER & ACM
- INFILL PORTION OF EXISTING OPENING WITH MATERIALS TO MATCH ADJACENT - SEE ELEVATIONS
- RELOCATED ICE MACHINE 2, 110V CONDENSATE PLUMBS TO EXISTING DUPLEX NEW 220V OUTLET FOR RELOCATED 30AMP BREAKER FOR ICE MACHINE. ROUTE PIPING OVERHEAD TO NEW CHASE BEHIND CENTER ISLAND. ROUTE PIPING TO EXISTING FLOOR DRAIN (MIN 1" DIAMETER)
- LEVEL LANDING @ EXT. DOOR W/ MAX. 2% RUNNING/CROSS SLOPE AWAY FROM BUILDING
- SIZE OF LANDING
- RECONFIGURE MANAGERS ROOM - RECONNECT EXISTING CONNECTIONS AND EQUIPMENT
- NEW PILLAR - MATERIALS TO MATCH EXISTING
- RELOCATE EXISTING SINK AND EXISTING CONNECTIONS AND DRAIN
- NEW SIDEWALK TO CONNECT TO EXISTING
- NEW WINDOW SYSTEM - MATCH EXISTING OPENING WITH NEW WINDOW

**GENERAL NOTES**

- EXTERIOR DIMENSIONS ARE TO COLUMN REFERENCE LINES AND EXTERIOR FACE OF FINISH UNLESS OTHERWISE NOTED. INTERIOR DIMENSIONS ARE TO FACE OF FINISH.
- SEE 3/A4.0 FOR EXTERIOR WALL ASSEMBLY TYPES. SEE 2/A1.0 FOR INTERIOR PARTITION TYPES. INTERIOR PARTITIONS ARE TYPE 'A' UNLESS NOTED OTHERWISE.
- SEE EXTERIOR ELEVATIONS FOR WINDOW TYPES
- SEE SHEET A4.0 FOR DOOR AND ROOM FINISH SCHEDULES
- SEE SITE PLAN FOR SIDEWALKS, RAMPS, ETC.
- GC TO PROVIDE ADA SIGNAGE PACKAGE AND INSTALL SIGNS AT LOCATIONS AND POSITIONS INDICATED IN PACKAGE OR AS REQUIRED BY LOCAL CODES. SIGNAGE PACKAGE SUPPLIED BY: FOREST PERMA-SIGN 1-800-214-8745 9292 1ST ST., BOX 588 www.forestperma-sign.com NEW ROCHELLE, NY 10602
- MAXIMUM OCCUPANCY SIGN TO BE POSTED PER LOCAL CODE. SIGN FURNISHED AND INSTALLED BY GENERAL CONTRACTOR
- ALL HANDSINK LOCATIONS SHALL HAVE CEMENT BOARD BACKING 48" IN HEIGHT A.F.F.
- G.C. TO COORDINATE ALL REQUIRED BLOCKING FOR WALL HUNG EQUIPMENT, SHELVES, ETC. FOR PROPER INSTALLATION HEIGHTS.

**SYMBOL LEGEND**

- A - PARTITION TYPE TAG SEE 2/A1.0
- X - DOOR TAG - SEE DOOR SCHEDULE ON A4.0
- X - KEY NOTE

DATE	11/26/2014	PERMIT AND BID	BOB
REV			BY
LA#11047			
PREPARED FOR:	M. McDonald's USA, LLC		
<p>These drawings and specifications are the confidential and proprietary information of M. McDonald's USA, LLC. They are not to be copied or reproduced without written authorization. The contractor shall be responsible for obtaining all necessary permits and for compliance with all applicable laws, codes, and regulations. Use of these drawings for any other project is strictly prohibited. Reproduction of these drawings for any other project is strictly prohibited. Use of the services of property owners, architects and engineers. Reproduction of the contract documents for reuse on another project is not authorized.</p>			
DRAWN BY:	3/13/2014	DATE ISSUED:	
TITLE:	MCDONALD'S BAINBRIDGE	DATE:	
SHEET:	A1.0	DATE:	
<p>17688 CHILlicothe ROAD, BAINBRIDGE, OHIO 44203</p>			