


PWS name Rock of Ages school
 4407 S. Kansas Rd.
 Applecreek, Ohio 44606

PWS ID 8546512



Contact Person
 Henry Miller
 335 Woodbury Circle
 Dalton, Ohio 44618
 Cell 330-845-3727

(Note: copper inside buildings
 Before 1983)

New well Head + New vented Cap New pressure Tank
 Done NOV. 2016

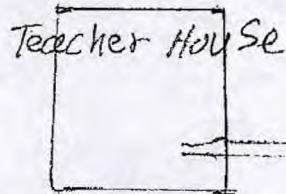

Plastic

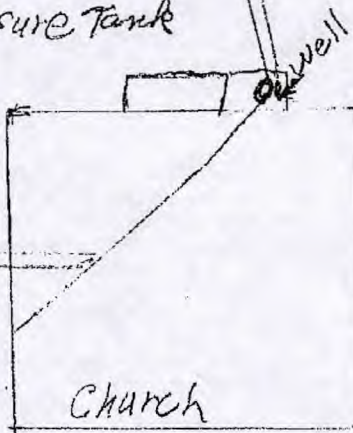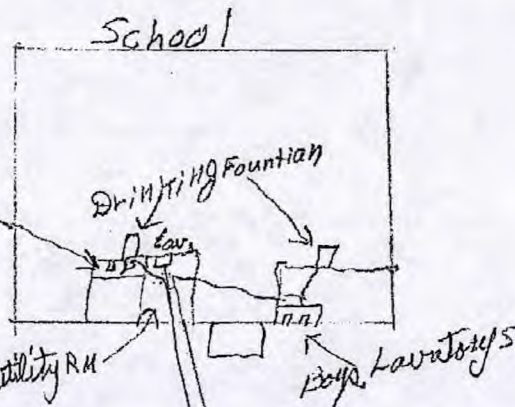

Church
 Late 1950's
 Addition in 1980's
 Kitchen
 2 restrooms } down
 2 restrooms } up
 Drinking fountain

Note: See SMP Sheet for sample Locations IDs
 Lead + Copper sampling was done 7-22-15
 Next sampling for lead + copper would be 6-30 to 9-30-2018