

RECEIVED

MAR 01 2017

OHIO EPA NEDO



**Manchester Local Schools**

6075 Manchester Rd.

Akron, Ohio 44319

(330) 882-4157 (O) / (330) 882-0013 (Fax)

**Manchester Local School District  
Administration Office Building**

6075 Manchester Rd

Akron, Ohio 44319

330-882-4157 (O)

330-882-0013 (F)

**Contact:** Director of Services

Mr. Michael E. Stafford (330) 882-4157

mike.stafford@manchester-panthers.org

**Building:**

(3 Stories)

Built New 1928

Addition 1965

27,937 SqFt.

**PWS ID:** OH7795712

**Water and Treatment Details:**

Well

Chlorine Injection Pump

Softener (1)

Storage Tanks (3 - WX-350 120 Gallon Tanks)

Contact Tanks (4 - Clack RT120 120 Gallon Tanks)

**Water Mains:** (Hot and Cold) \*Original Copper and Solder

First floor with risers to 2nd and 3rd Floor Restrooms on West Side of building

(\*Mains possible reworked or replaced in 1965 Addition)

**Well/Softener/Contact Tanks (Tie-In):** - \*Plumbed in Schedule 40 Pipe and

L-Copper + Schedule 40 Pressure Fittings + Pro-Press Fittings


(\*All has been reworked since 2000.)

**Comments:** Since 1988 all water line repairs have been made with L-Copper, Lead Free Solder, Pro-Press Fittings, Schedule 40 PVC and PVC Pressure Fittings.

All Fixtures in the building have been updated and/or replaced at least once since 1988.

Entity: Manchel Administration Bldg  
Doc Type: Report  
Doc Subtype: \_\_\_\_\_  
Program: DPAGW  
County: Summit  
Secondary ID: OH 7795712  
EDC Inslor



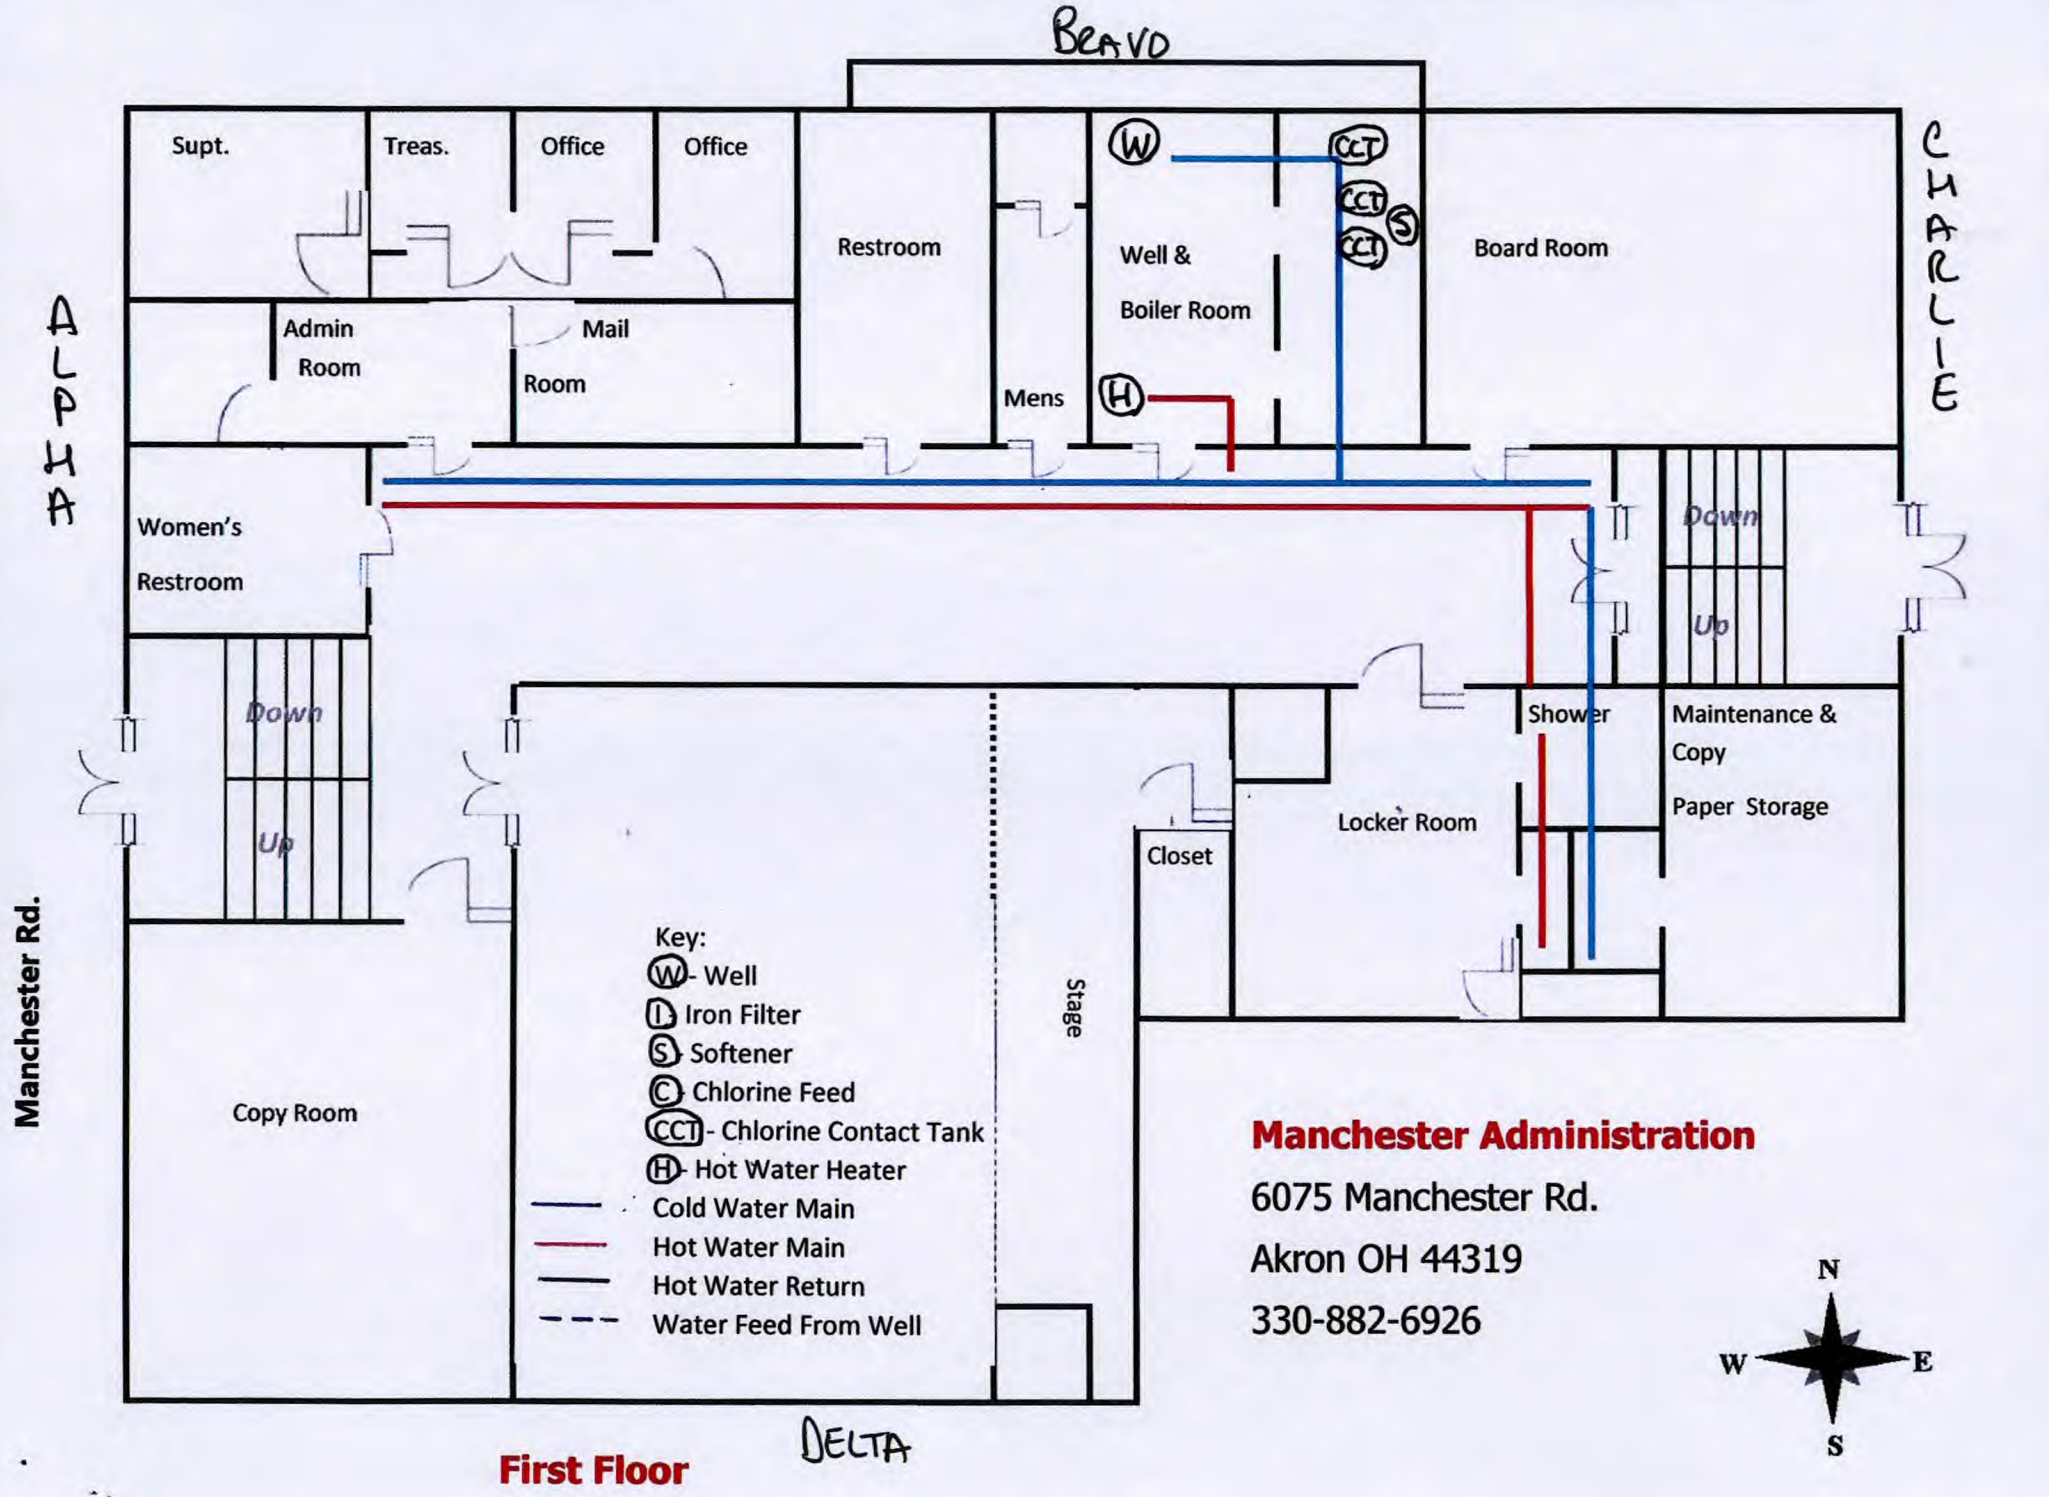

DELTA

Manchester Rd.




**First Floor**

- Key:
- (W) - Well
  - (I) - Iron Filter
  - (S) - Softener
  - (C) - Chlorine Feed
  - (CCT) - Chlorine Contact Tank
  - (H) - Hot Water Heater
  - Cold Water Main
  - Hot Water Main
  - Hot Water Return
  - - - Water Feed From Well

**Manchester Administration**

6075 Manchester Rd.

Akron OH 44319

330-882-6926






BRAVO

CHARLIE

ALPHA

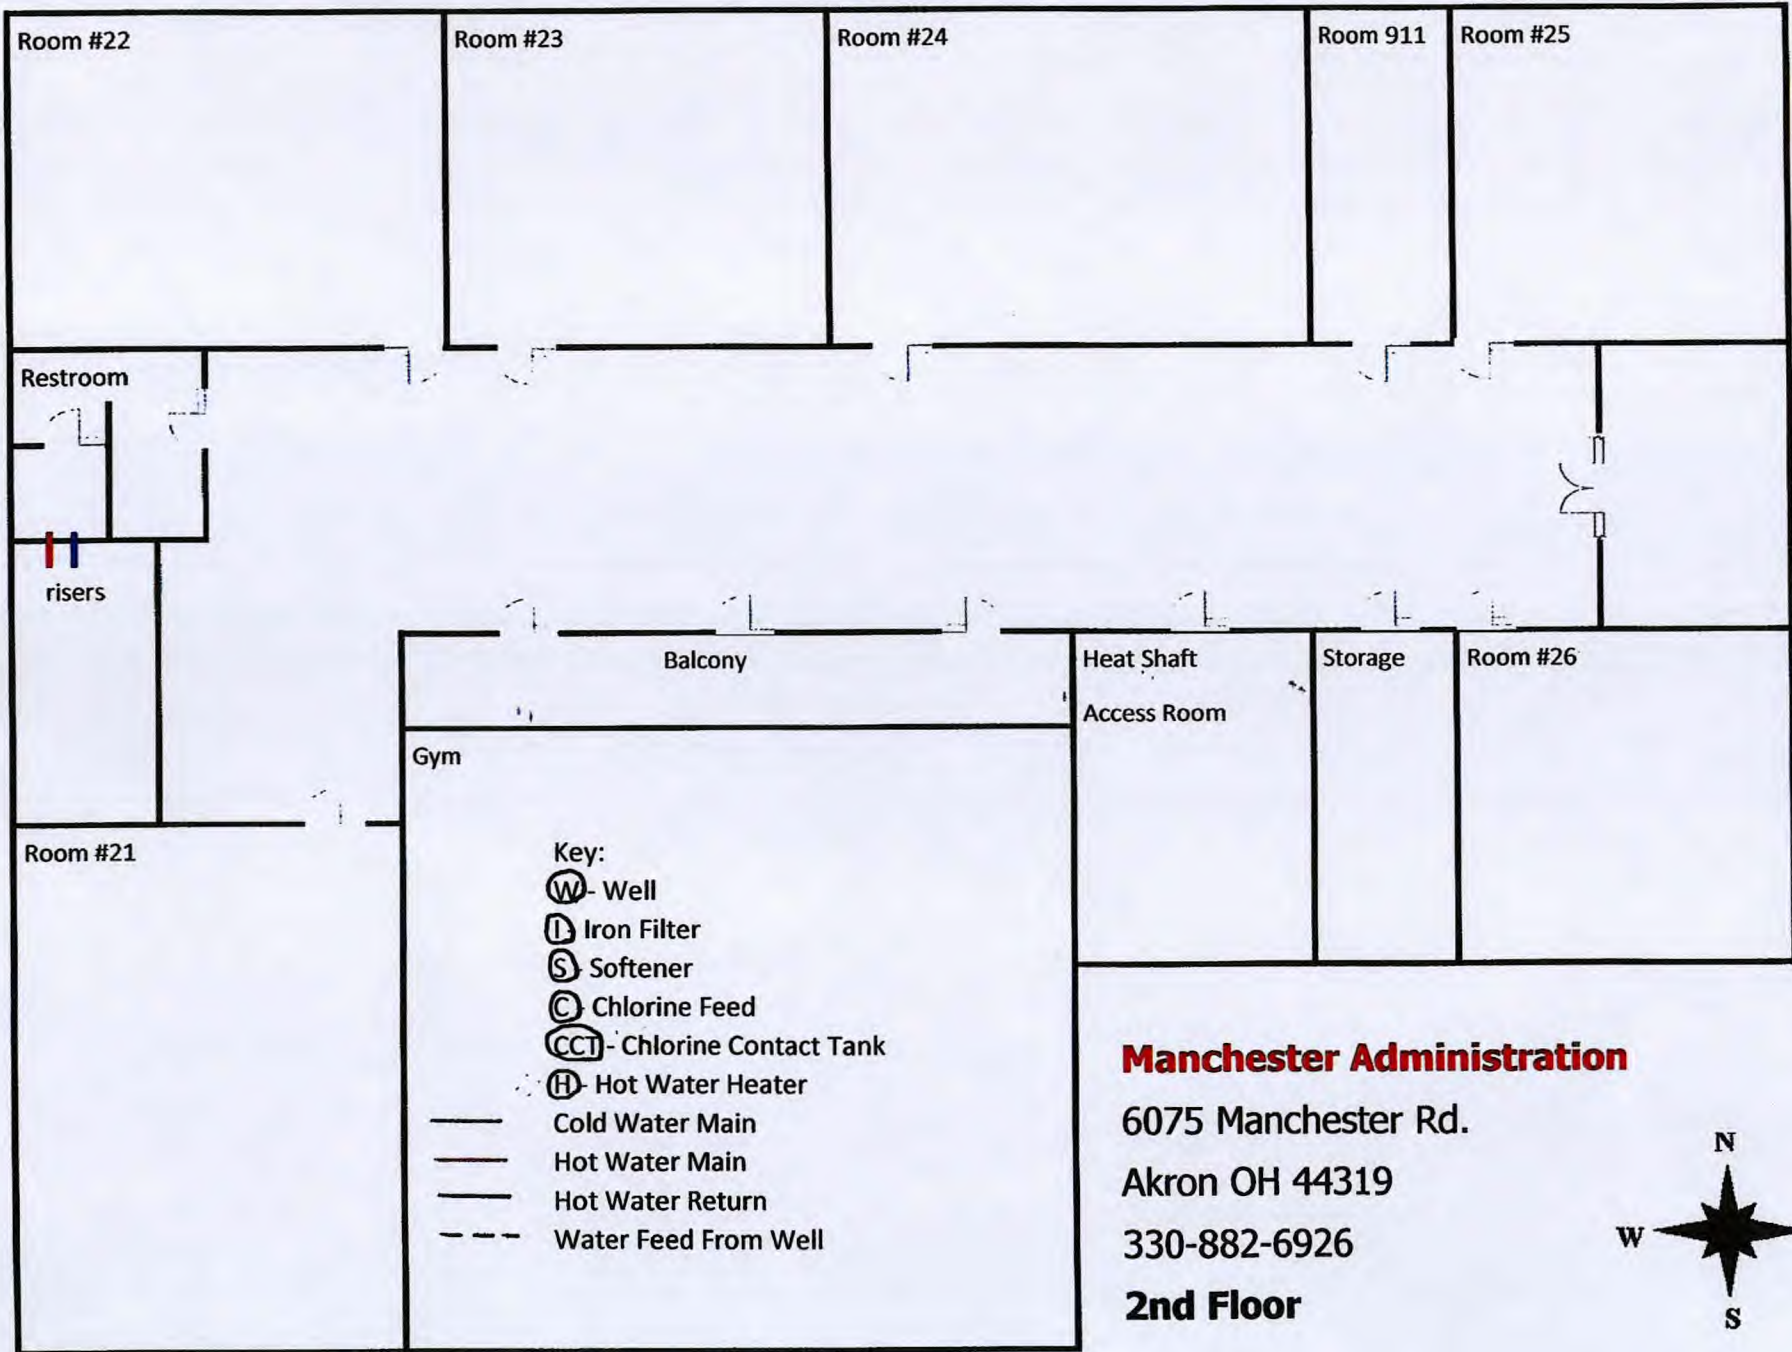

Room #22

Room #23

Room #24

Room 911

Room #25

Restroom

risers

Balcony

Heat Shaft

Storage

Room #26

Access Room

Gym

Room #21

Key:

Ⓜ Well

Ⓛ Iron Filter

Ⓢ Softener

Ⓒ Chlorine Feed

ⒸⒸ Chlorine Contact Tank

Ⓜ Hot Water Heater

— Cold Water Main

— Hot Water Main

— Hot Water Return

- - - Water Feed From Well

**Manchester Administration**

6075 Manchester Rd.

Akron OH 44319

330-882-6926

**2nd Floor**




DELTA

BRavo

ALPHA

CHARLIE

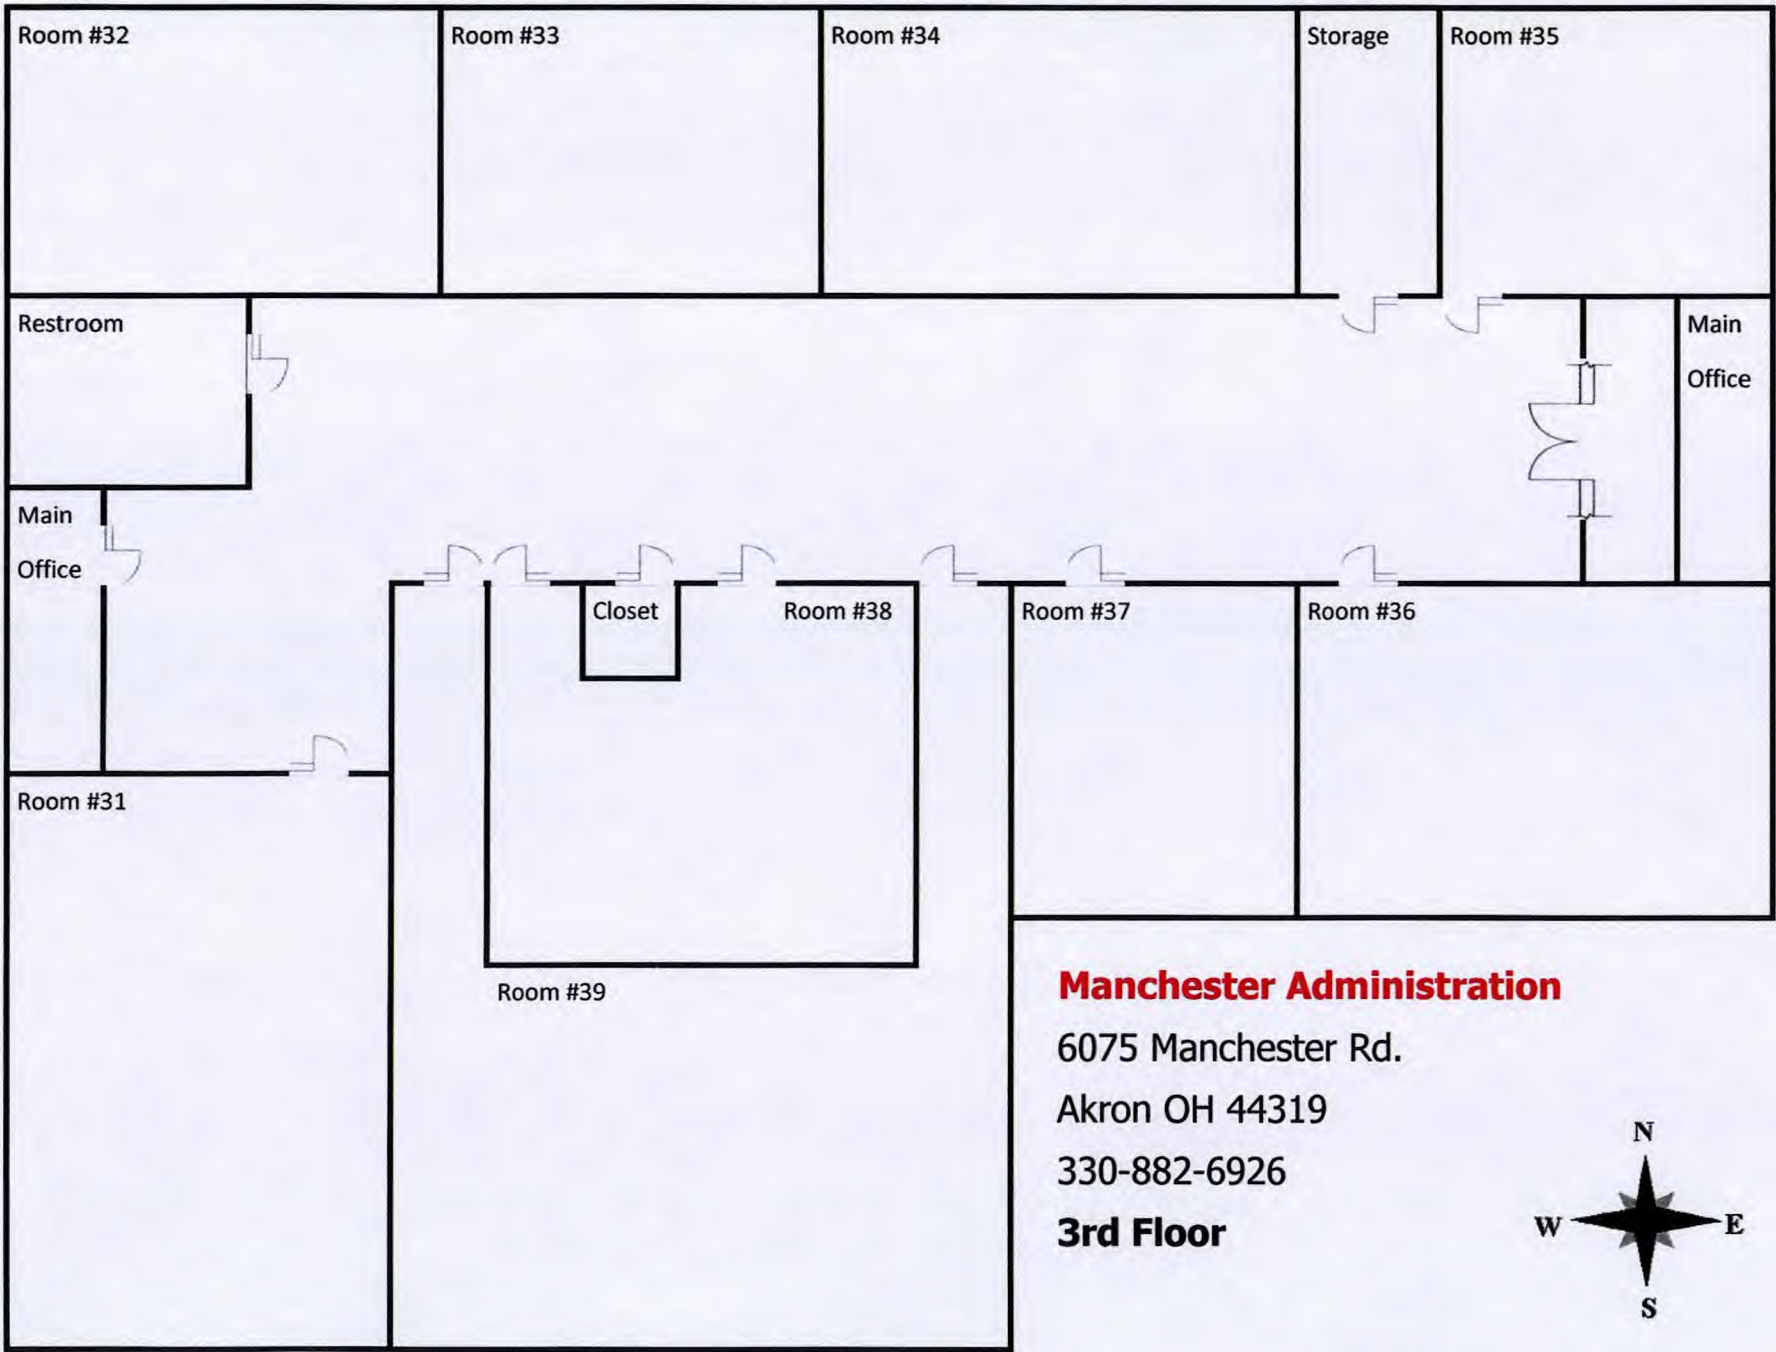

DELTA

**Manchester Administration**

6075 Manchester Rd.


Akron OH 44319

330-882-6926

**3rd Floor**





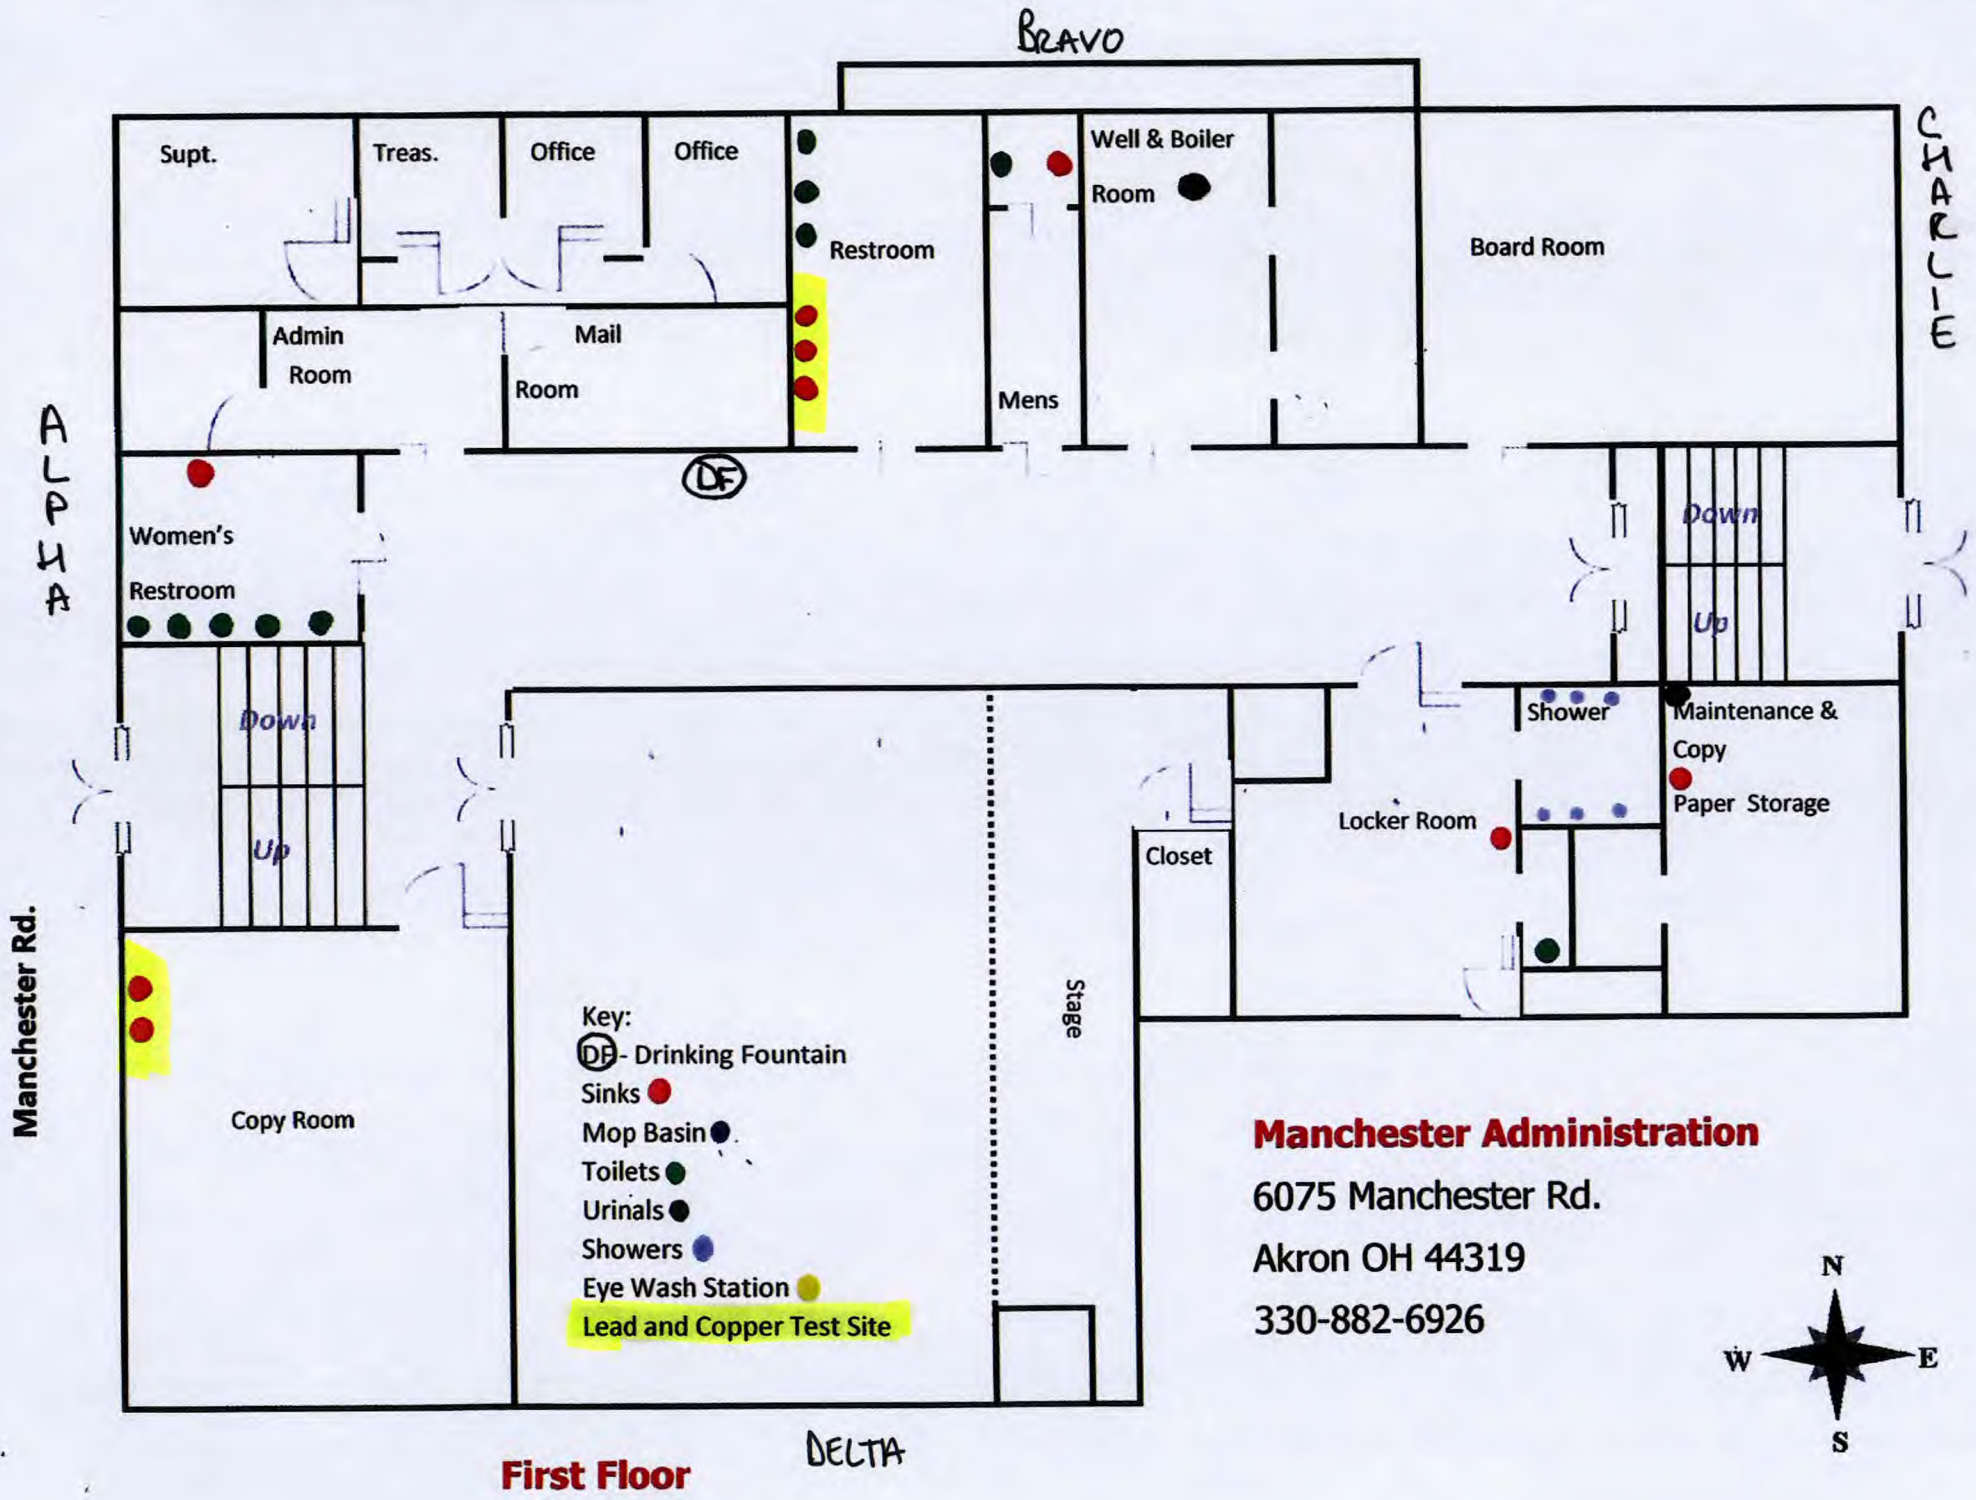




BEAVO

CHARLIE

ALPHA

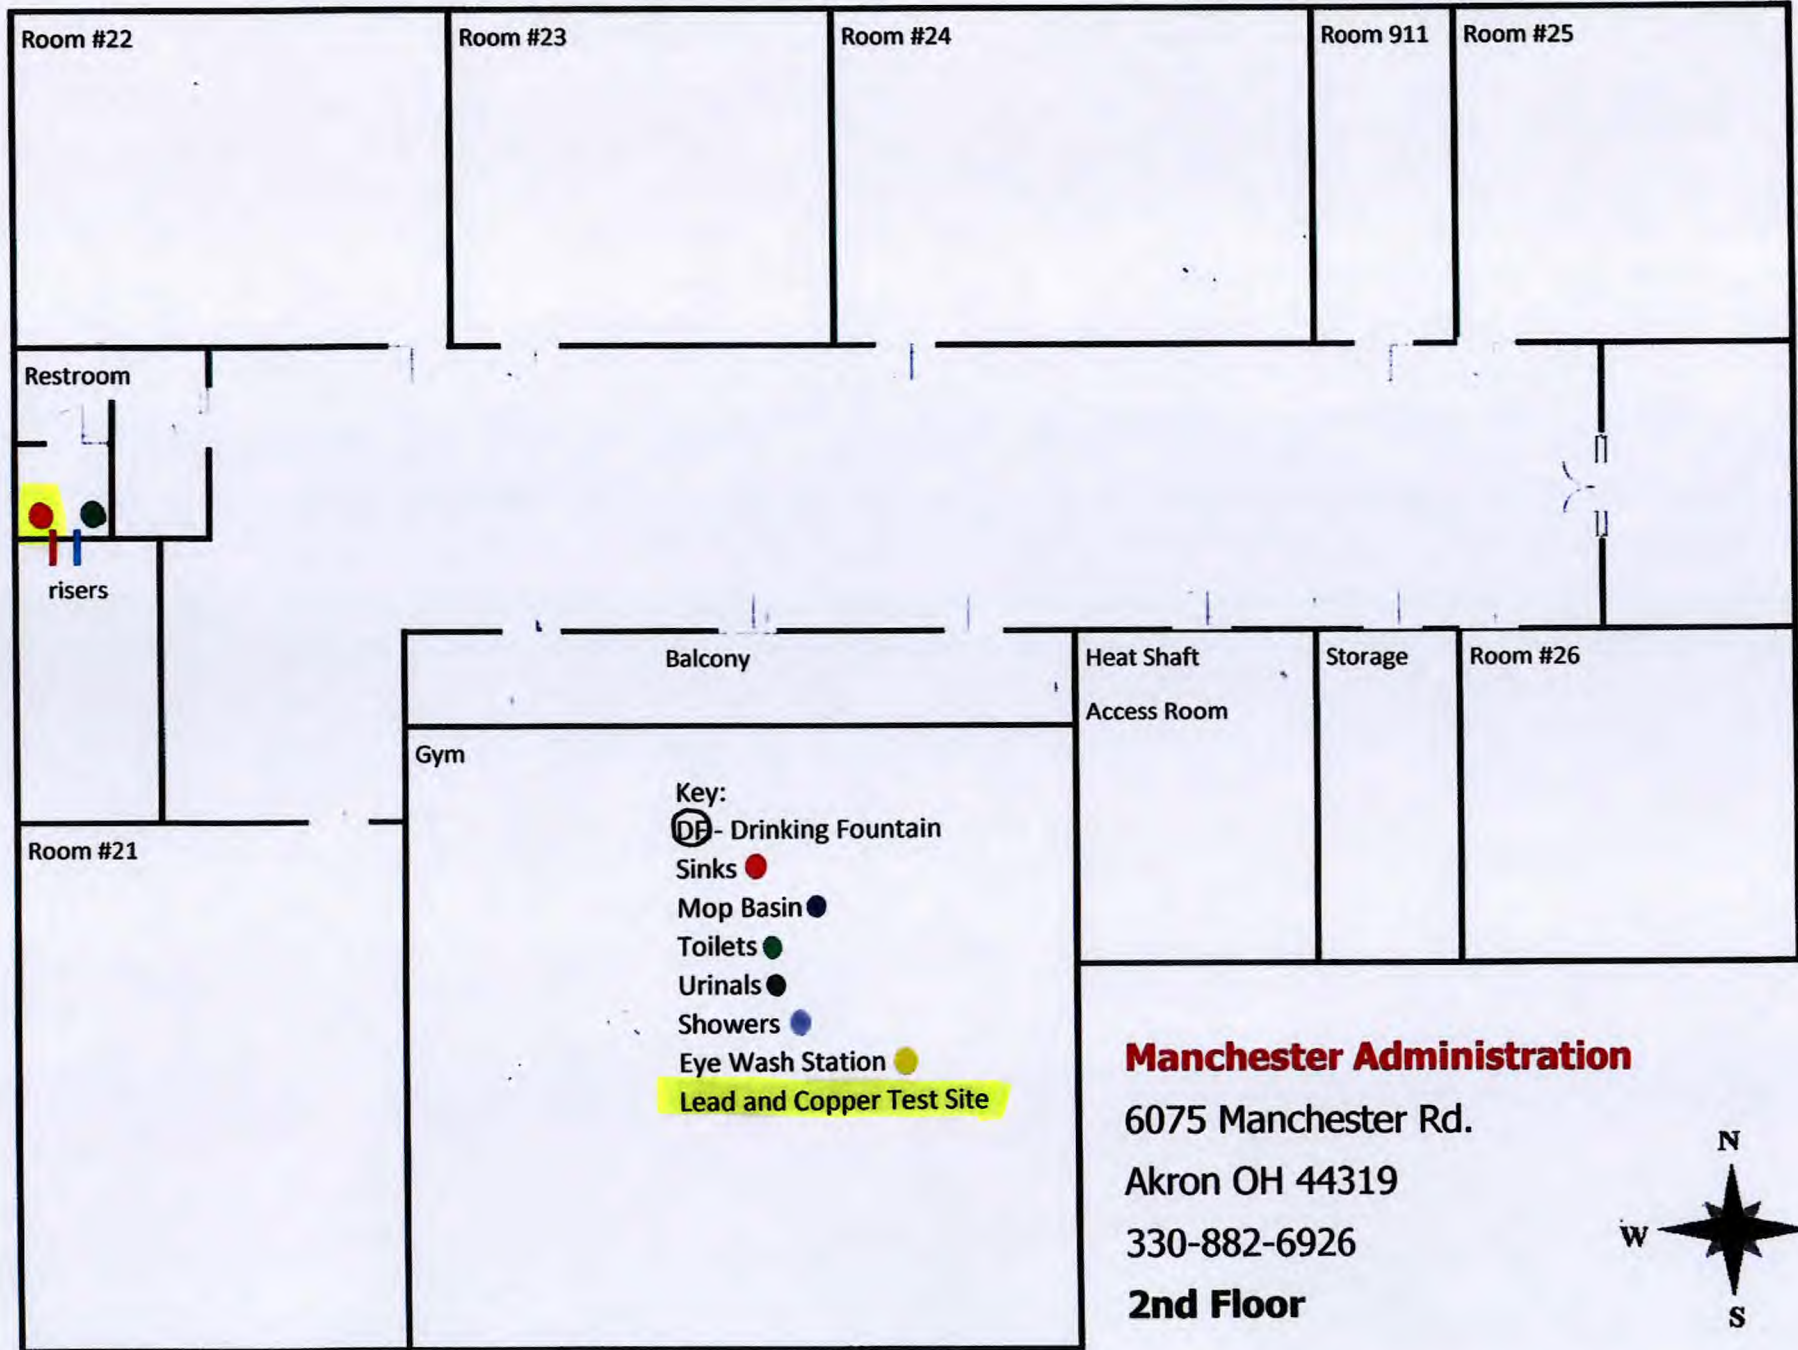

**Manchester Administration**

6075 Manchester Rd.

Akron OH 44319

330-882-6926

**2nd Floor**




DELTA

BRavo

DELTA

CHARIE

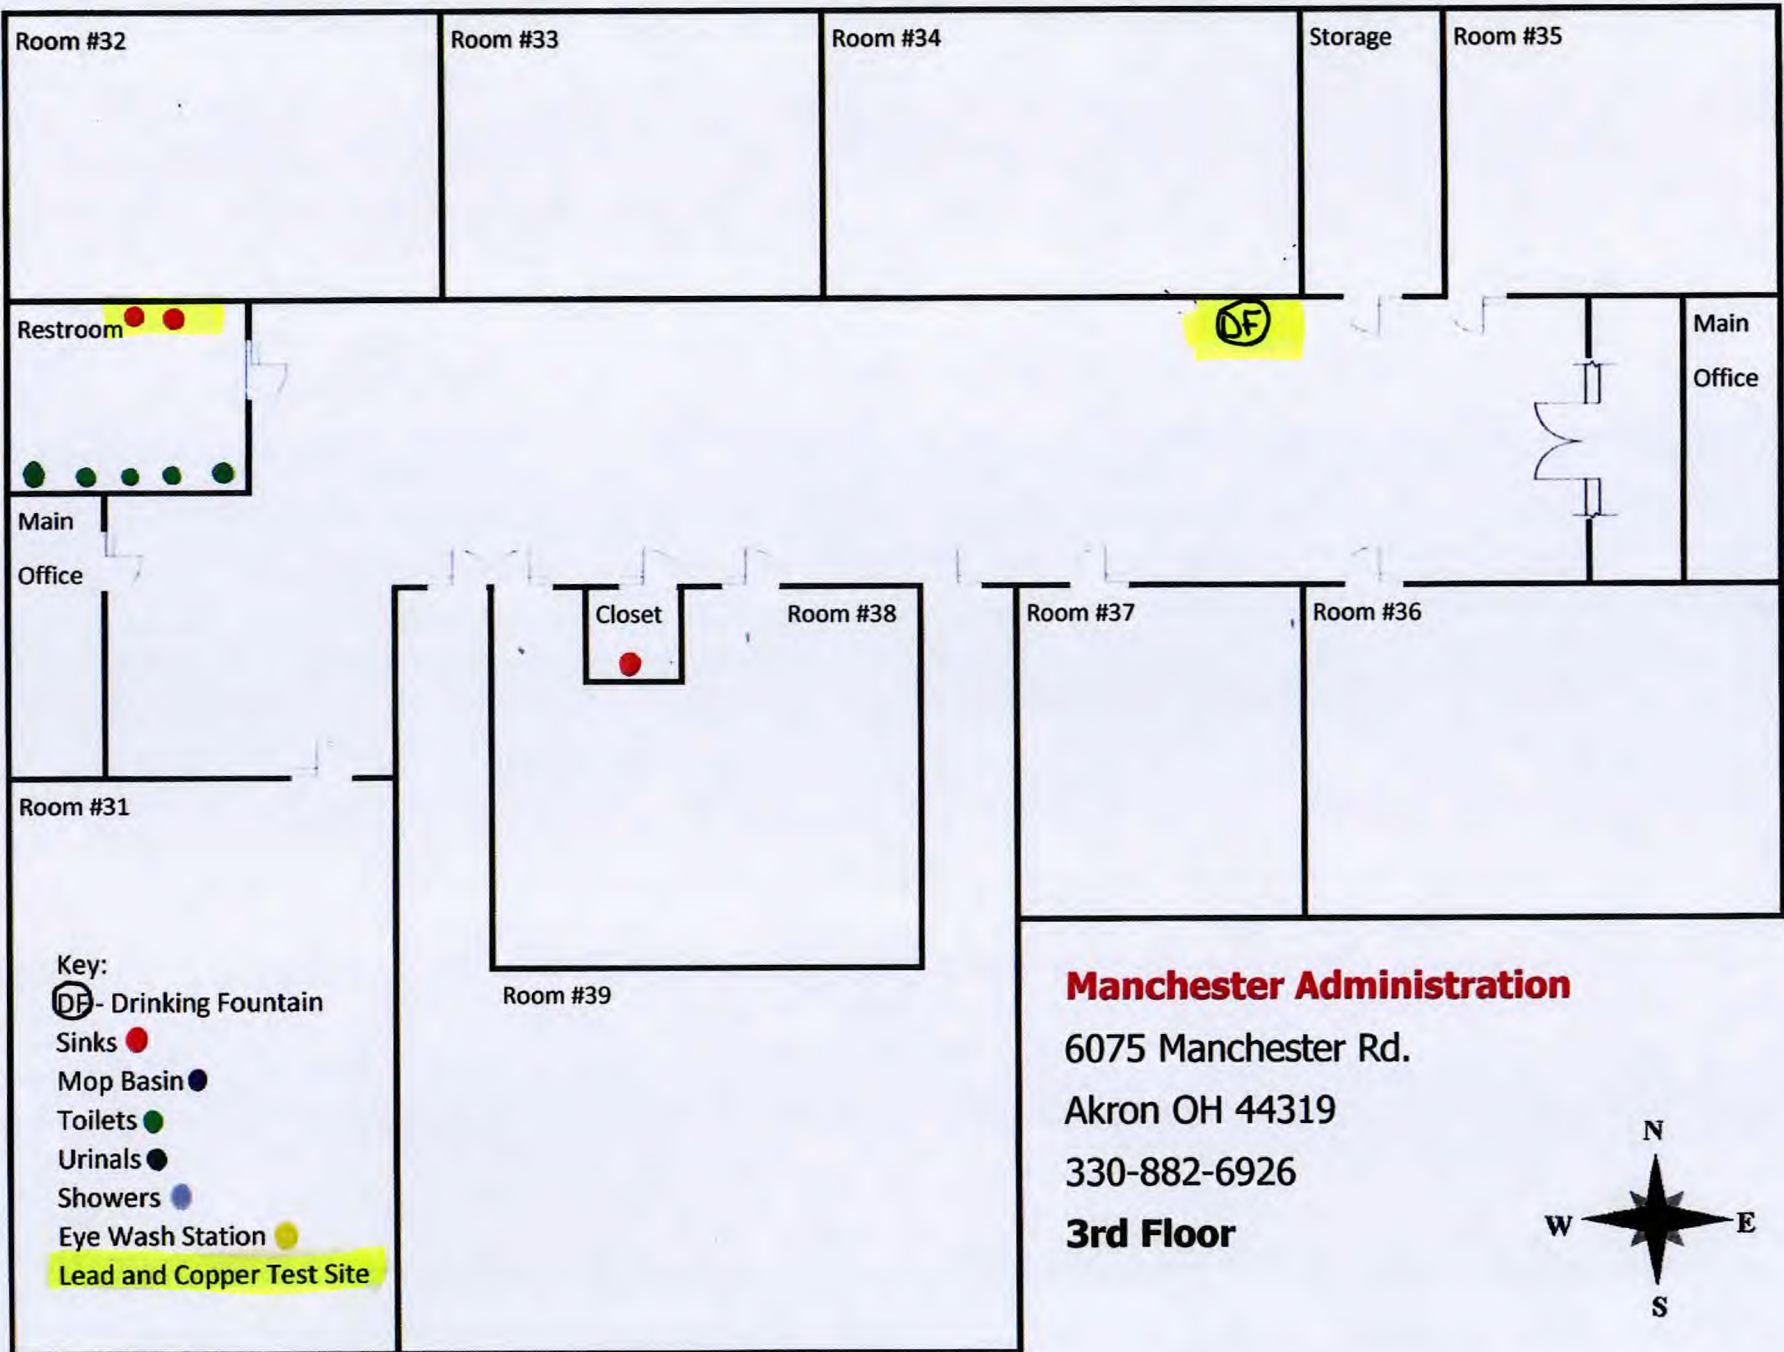

- Key:
- DF - Drinking Fountain
  - Sinks ●
  - Mop Basin ●
  - Toilets ●
  - Urinals ●
  - Showers ●
  - Eye Wash Station ●
  - Lead and Copper Test Site

**Manchester Administration**

6075 Manchester Rd.

Akron OH 44319

330-882-6926

**3rd Floor**



DELTA