

RECEIVED

MAR 01 2017

OHIO EPA NEDO



Manchester Local Schools

6075 Manchester Rd.
Akron, Ohio 44319
(330) 882-4157 (O) / (330) 882-0013 (Fax)

Manchester Nolley School

6285 Renninger Rd
Akron, Ohio 44319
(O) 330-882-4133

Contact: Director of Services
Michael E Stafford (330) 882-4157
mike.stafford@manchester-panthers.org

Building:

Built New 1962
Addition 1968

47,001 SqFt.

PWS ID: OH7778112

Water Treatment Details:

Well
Chlorine Injection Pump
Softener (2)
Storage Tank (2500 Gallon)

Water Mains: (Cold/Hot/Return) Original Copper + Solder

Well/Softener/Iron Filters (Tie-In): - Plumbed in Schedule 40 PVC, L-Copper and Schedule 40 Pressure Fittings + Pro-Press Fittings, Copper Fittings w/Solder

Comments: Since 1988 all water line repairs have been made with L-Copper, Lead Free Solder, Pro-Press Fittings, Aqua-Pex Tubing + Brass Pex Fittings, Schedule 40 PVC + PVC Schedule 40 Pressure Fittings

All Fixtures in the building have been updated and/or replaced at least once since 1988.

Entity: Nolley Elementary
Doc Type: Report
Doc Subtype: _____
Program: DPAGW
County: Summit
Secondary ID: OH 7778112

EDOC in color

Nolley Elementary School

6285 Renninger Rd.

Akron OH 44319

330-882-4133

Key:


- ⊙ - Well
- Ⓛ - Iron Filter
- Ⓢ - Softener
- ⓐ - Chlorine Feed
- ⓐⓐ - Chlorine Contact Tank
- Ⓜ - Hot Water Heater
- Cold Water Main
- Hot Water Main
- Hot Water Return
- - - Water Feed From Well



DELTA

CHARLIE

BRAVO

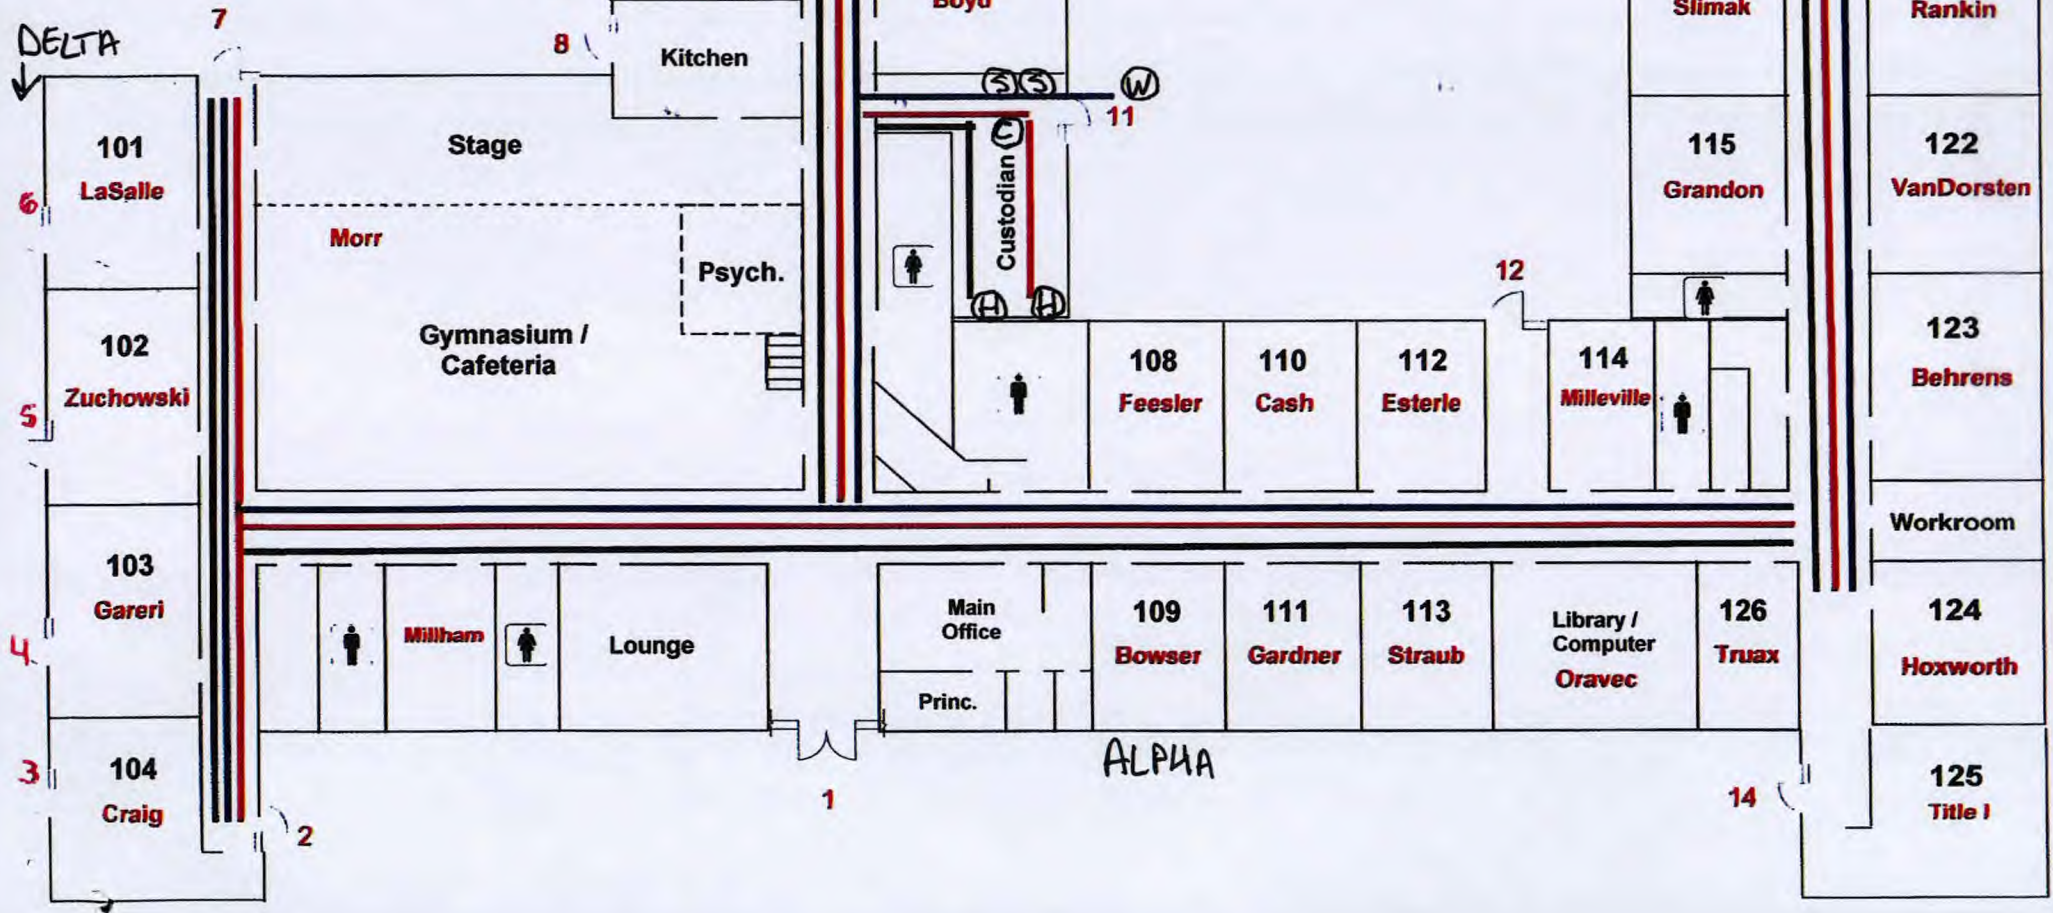

Nolley Elementary School

6285 Renninger Rd.

Akron OH 44319

330-882-4133

Key:

DF - Drinking Fountain

Sinks ●

Mop Basin ●

Toilets ●

Urinals ●

Showers ●

Eye Wash Station ●

Lead and Copper Test Site

