



Manchester Local Schools

6075 Manchester Rd.
Akron, Ohio 44319
(330) 882-4157 (O) / (330) 882-0013 (Fax)

RECEIVED

MAR 01 2017

OHIO EPA NEDO

Manchester High School

437 W Nimisila Rd
Akron, Ohio 44319
(O) 330-882-3291

Contact: Director of Services
Mr. Michael E Stafford (330) 882-4157
mike.stafford@manchester-panthers.org

Building:

Built New 1960
Addition 1965
Addition 1974

89,875 SqFt

PWS ID: OH7778012

Water and Treatment Details:

- Well
- Chlorine Injection Pump
- 1 - 500* Gallon Storage Tank
- Storage Tanks - (3 - WX-350 120 Gallon Tanks)
- Softener (4)
- Iron Filter (2)

Water Mains: (Hot/Cold/HW-Return) Original Copper + Solder

Well/Softener/Iron Filters (Tie-In):- Plumbed in Schedule 40 PVC + Schedule 40 Pressure Fittings

Comments: Since 1988 All water line repairs have been made with L-Copper, Lead Free Solder, Pro-Press Fittings, Aqua-Pex Tubing + Brass Pex Fittings, Schedule 40 PVC and PVC Pressure Fittings.

All Fixtures in the building have been updated and/or replaced at least once since 1988.

Entity: Manchester High School
 Doc Type: Report
 Doc Subtype: _____
 Program: DPAGW
 County: Summit
 Secondary ID: OH 7778012
 eDCC in color

Manchester High School


437 W. Nimisila Rd.
Akron OH 44319
330-882-3291

CHARLIE



Key:

- (W) Well
- (I) Iron Filter
- (S) Softener
- (C) Chlorine Feed
- (CCT) Chlorine Contact Tank
- (H) Hot Water Heater
- Cold Water Main
- Hot Water Main
- Hot Water Return
- - - Water Feed From Well

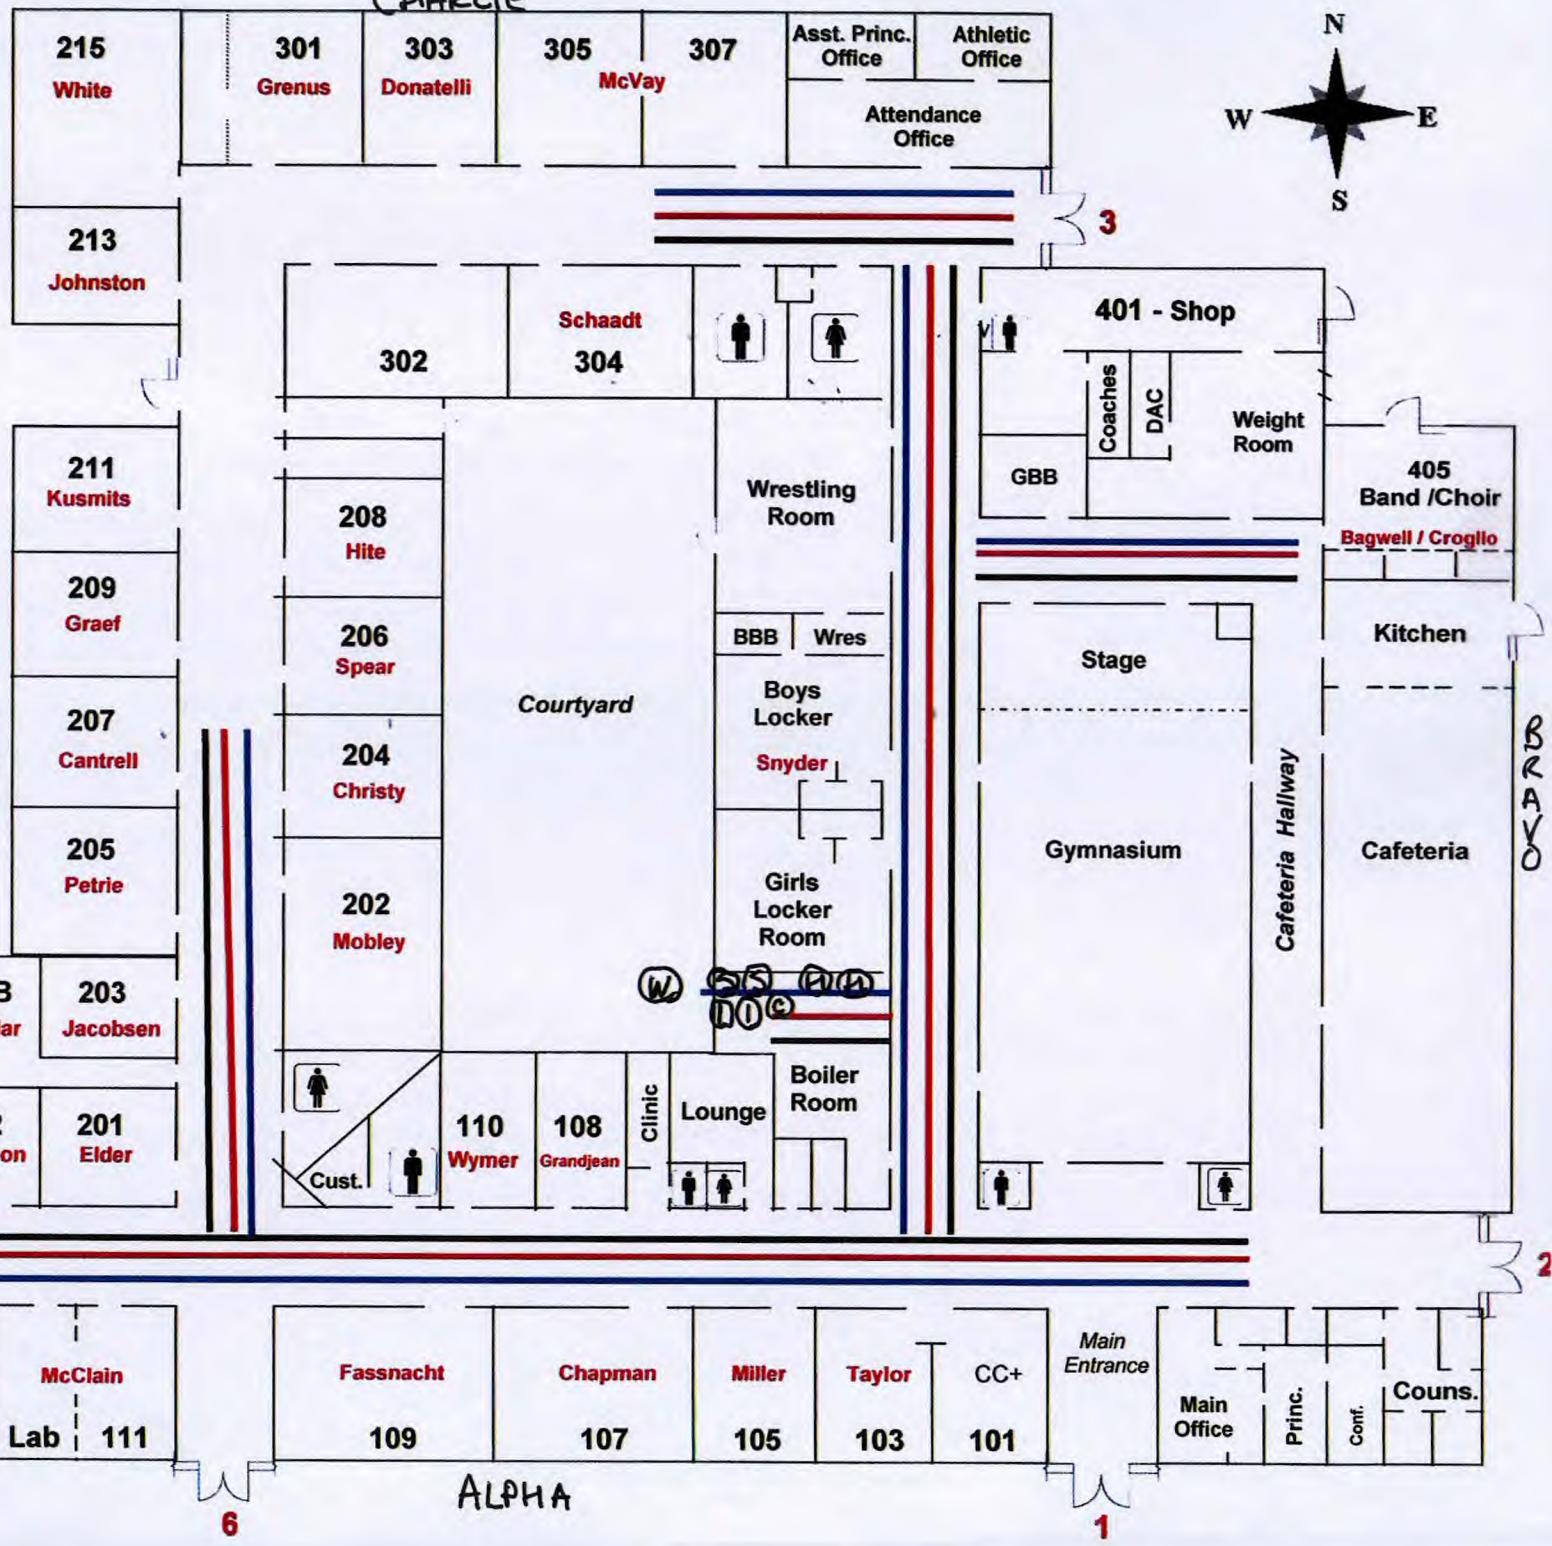

5

6

1

2

ALPHA

Manchester High School


437 W. Nimisila Rd.
Akron OH 44319
330-882-3291

CHARLIE



Key:

- DF - Drinking Fountain
- Sinks ●
- Mop Basin ●
- Toilets ●
- Urinals ●
- Showers ●
- Eye Wash Station ●
- Lead and Copper Test Site

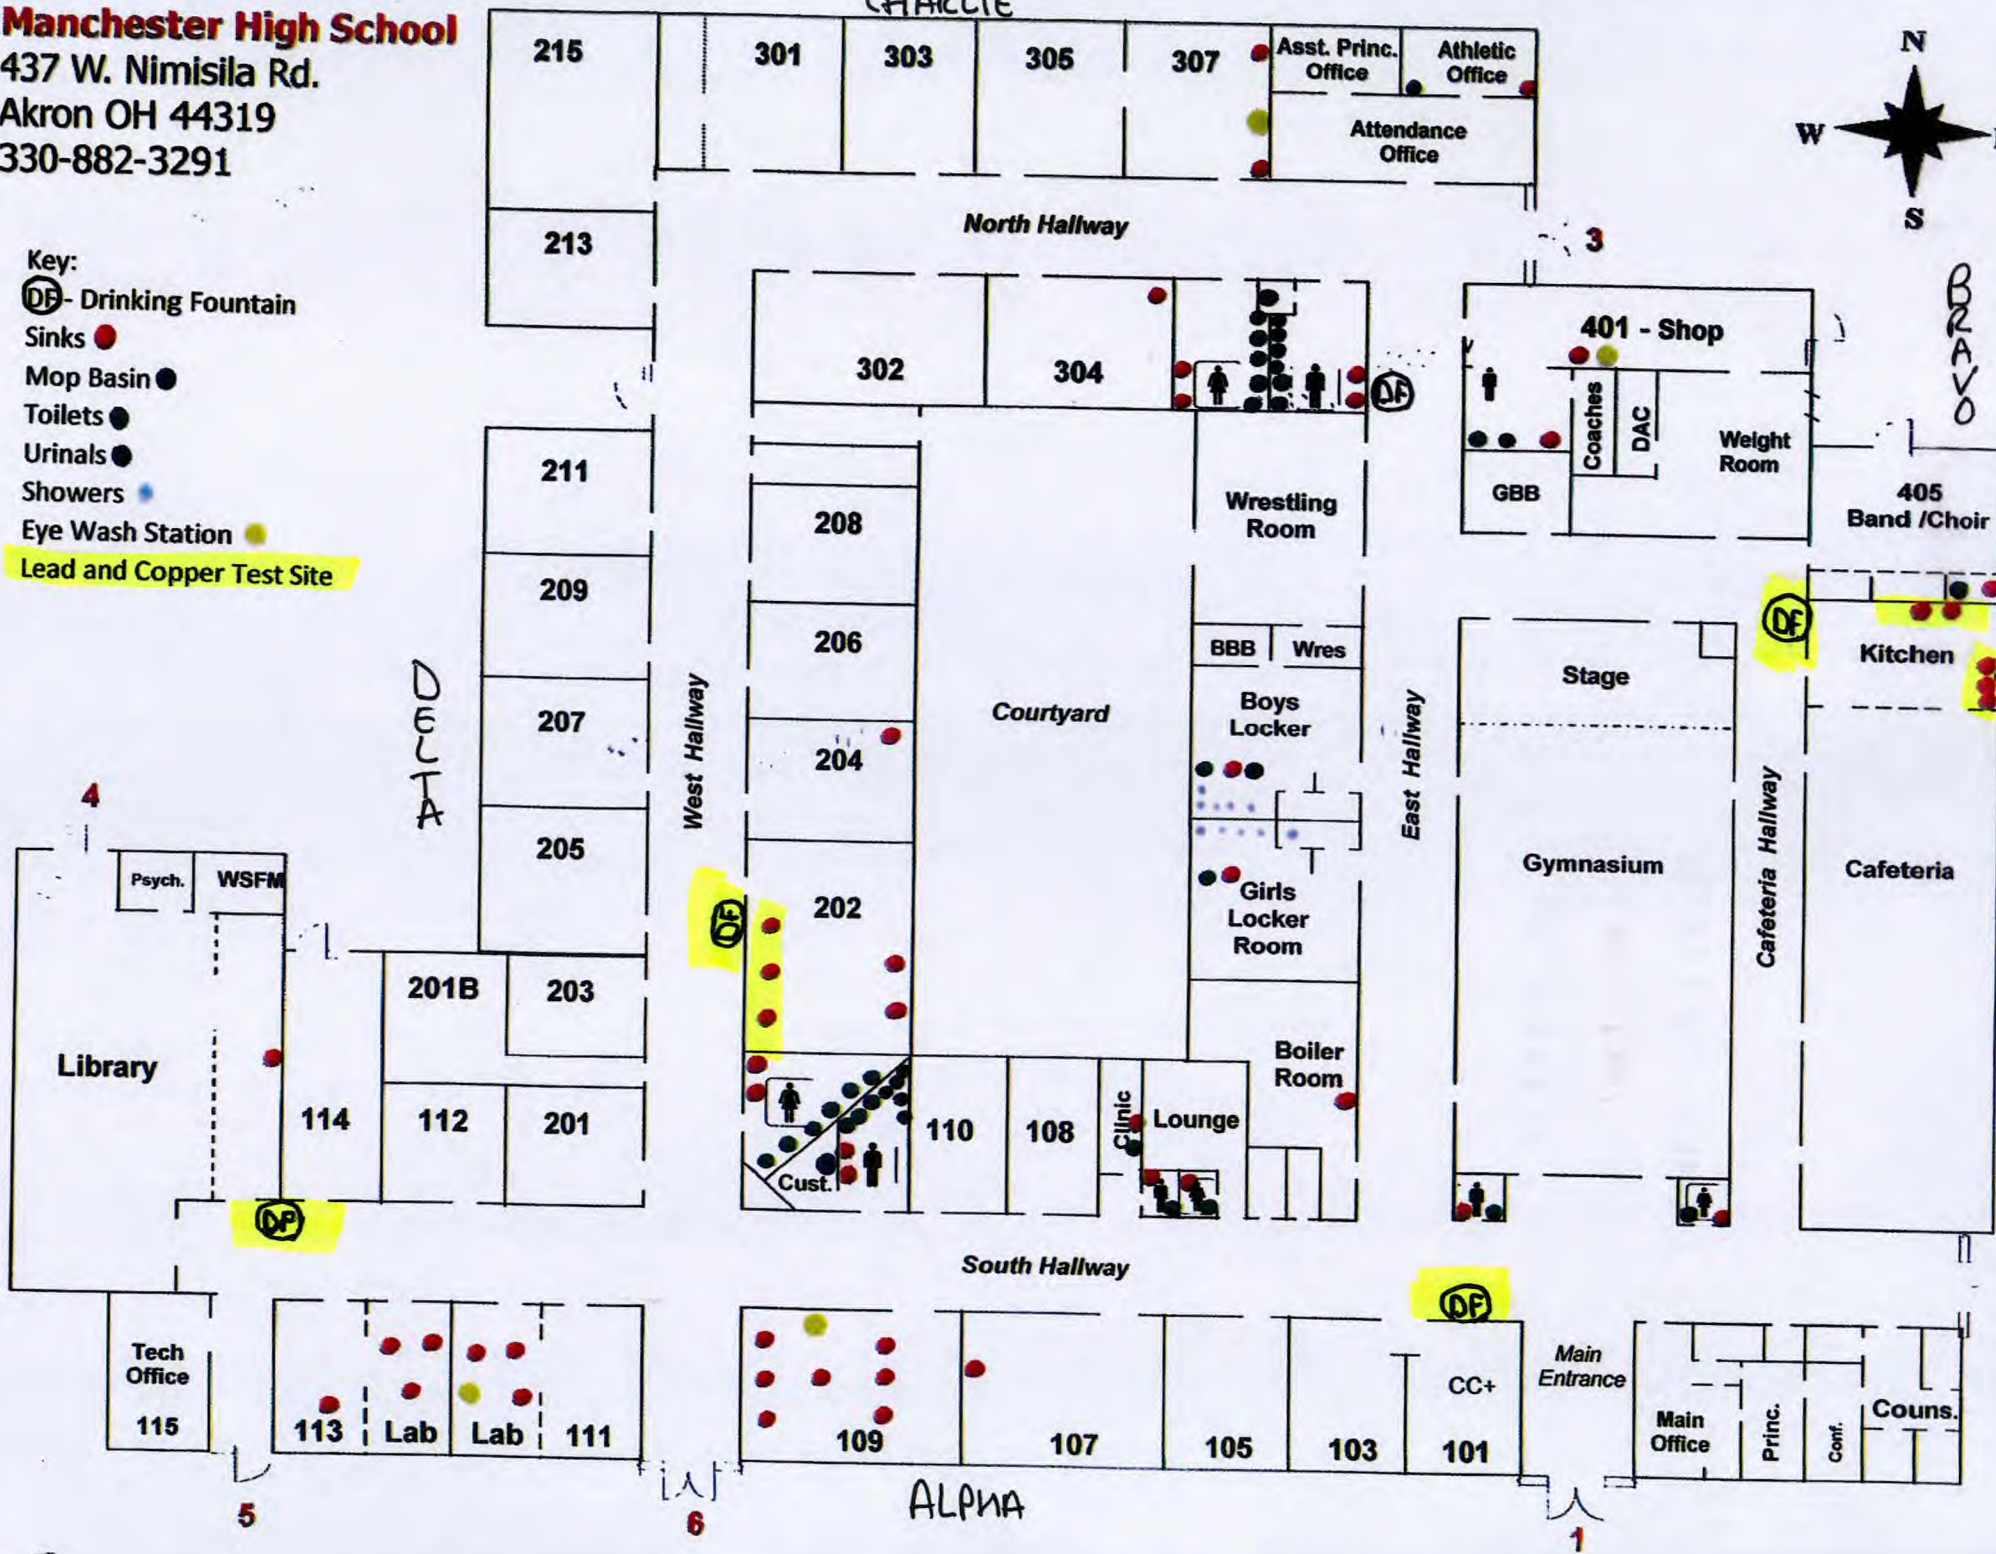

DELTA


ALPHA

5

6

1

4

3