Lead and Copper Monitoring Site Plan

Bainbridge Township Centerville Mills Park/ Aurora Co-Op Preschool

PWS ID: OH 2831012

Building name for system map

- A) Well house- Water Treatment Plant
- B) Dining Hall-Sample site
- C) Aurora Co-Op Daycare Sample
- *Bar scale on each site plan
- *Locate Buildings onsite plan
- *Layout of hot and cold water distribution



BY:

Dining Hall site plan attached

- Boy's restroom sink
- 2) Girl's restroom ink
- 3) Kitchen sink

Entity: Centeralle Mill RK/ Aurora Coop Doc Type: D +DORT

Doc Subtype:

Program: DOAGW

Secondary ID: 01283/012

e DOC IN COLOR

Aurora Co-Op Daycare

- 1) Office Sink
- 2) Boy's restroom sink

Fixture materials- unknown

Note: All water lines are PVC replaced from lead and copper in 2016 unless otherwise indicated. Lines at restroom sinks are still copper with solder fittings. Dining hall was built in 1933 and daycare was built in 1988.

Because it is practically impossible to determine the lead content of an installed fixture, fitting or pipe, it should be assumed that the manufacture or installation date is the primary indicator of the lead content. Therefore, the characteristics of buildings and piping solder or fixtures would be buildings built prior to 1998 or that use plumbing material or solder manufactured before 1998 may have materials with greater than 8% lead and are at a higher risk of contributing lead to the drinking water than materials manufactured after 1998. In addition, buildings built and plumbing materials manufactured after 2014 were required to have less than 0.25% lead by weight and have the lowest risk for contributing lead to the drinking water. It should be noted however that, although prohibited, some use of leaded solder or leaded components may have occurred after the prohibitions became






Geauga REALink



Frank J. Gliha, Geauga County Auditor Joe Cattell, Geauga County Engineer PE, PS

1 Inch = 97.33 Feet | Scale: 1,168

February 2, 2017

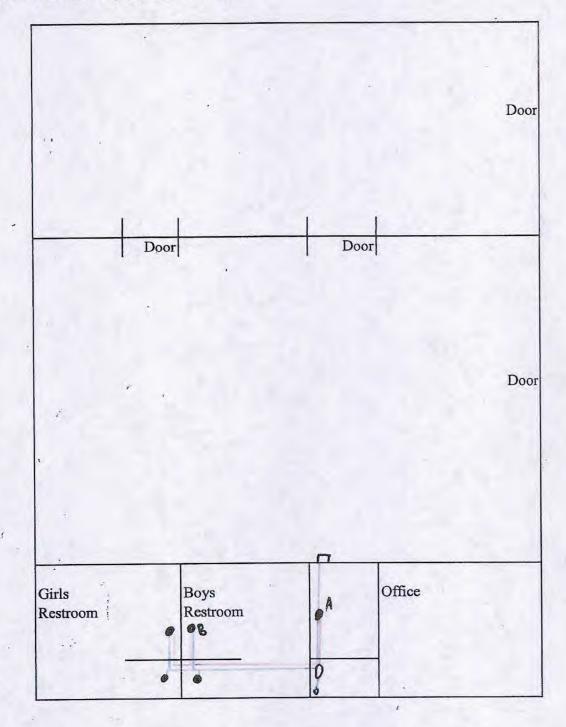

$$N \xrightarrow{E} S$$

