



Valley Presbyterian Church

17560 Chillicothe Road, Chagrin Falls, OH 44023
Phone: 440-543-1071 Fax: 440-543-4047

Email: valleypc@netlink.net Web: www.valleypresbychurch.org

RECEIVED
FEB 13 2017
OHIO EPA NEDO

The Reverend John Wahl, Pastor

February 9, 2017

Patricia Vanah
Ohio Environmental Protection Agency
2110 E Aurora Road
Twinsburg, OH 44087

Dear Ms. Vanah:

Per HB512 Lead & Copper Mapping, I have attached mappings for Valley Presbyterian Church. If you have any questions, please contact Harry Balcer at our church at 440-543-1071.

Blessings,

Rebecca Bliss


Rebecca Bliss
Office Manager

Entity: Valley Presbyterian
Doc Type: Report
Doc Subtype: _____
Program: DDAGW
County: Columbiana
Secondary ID: OH 2848512

eDoc in color

Room #s, thermo starts, heating routes & pumps

PUMPS
 ①-②-③-④-⑤
 FEEDING
 1.
 2.

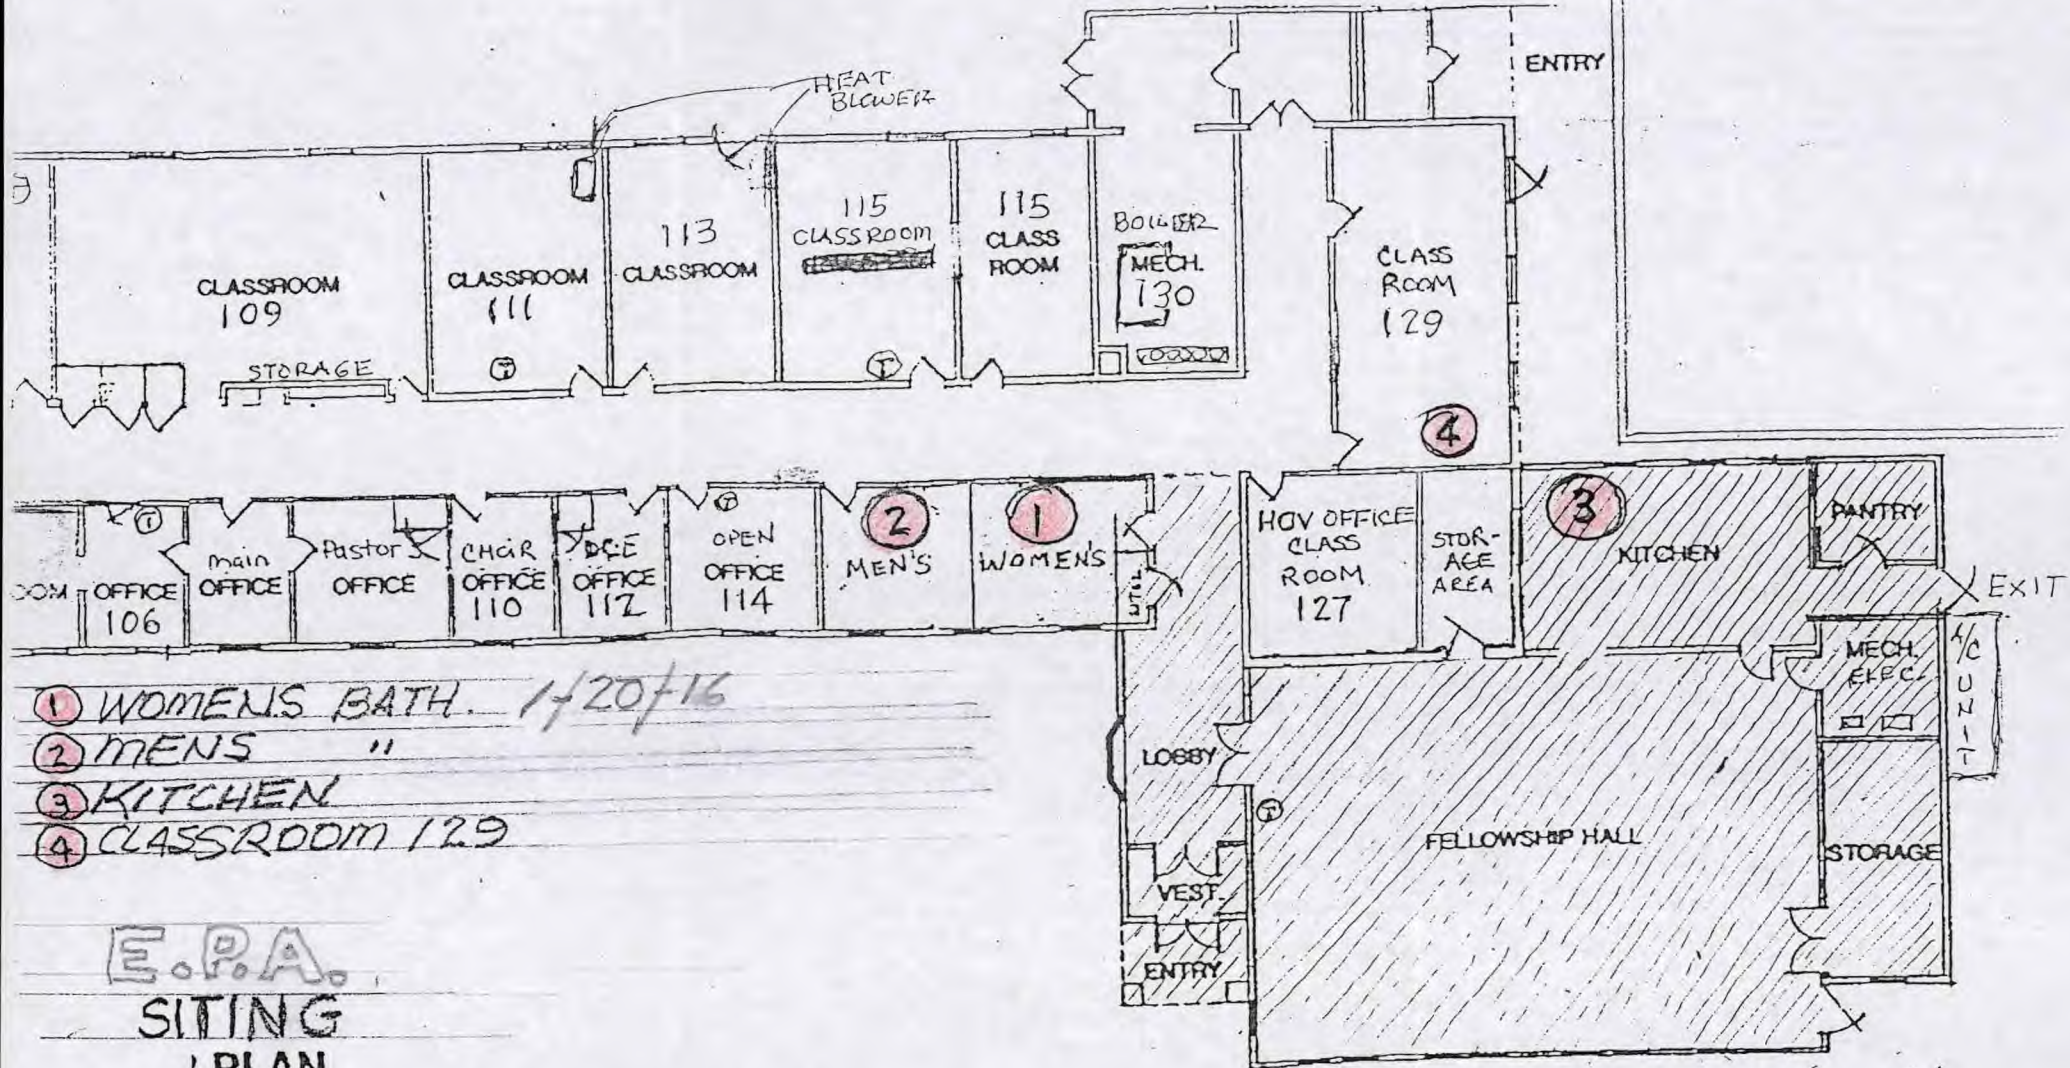


- ① WOMENS BATH. 1/20/16
- ② MENS "
- ③ KITCHEN
- ④ CLASSROOM 129

E.P.A.
SITING
PLAN

SAMPLES TAKEN THRU 4

* LOCATION *
 VALLEY PRESBYTERIAN CHURCH
 17560 CHILICOTE ROAD
 CHAGRIN FALLS, OHIO 44023
 PHONE # 440-543-1071

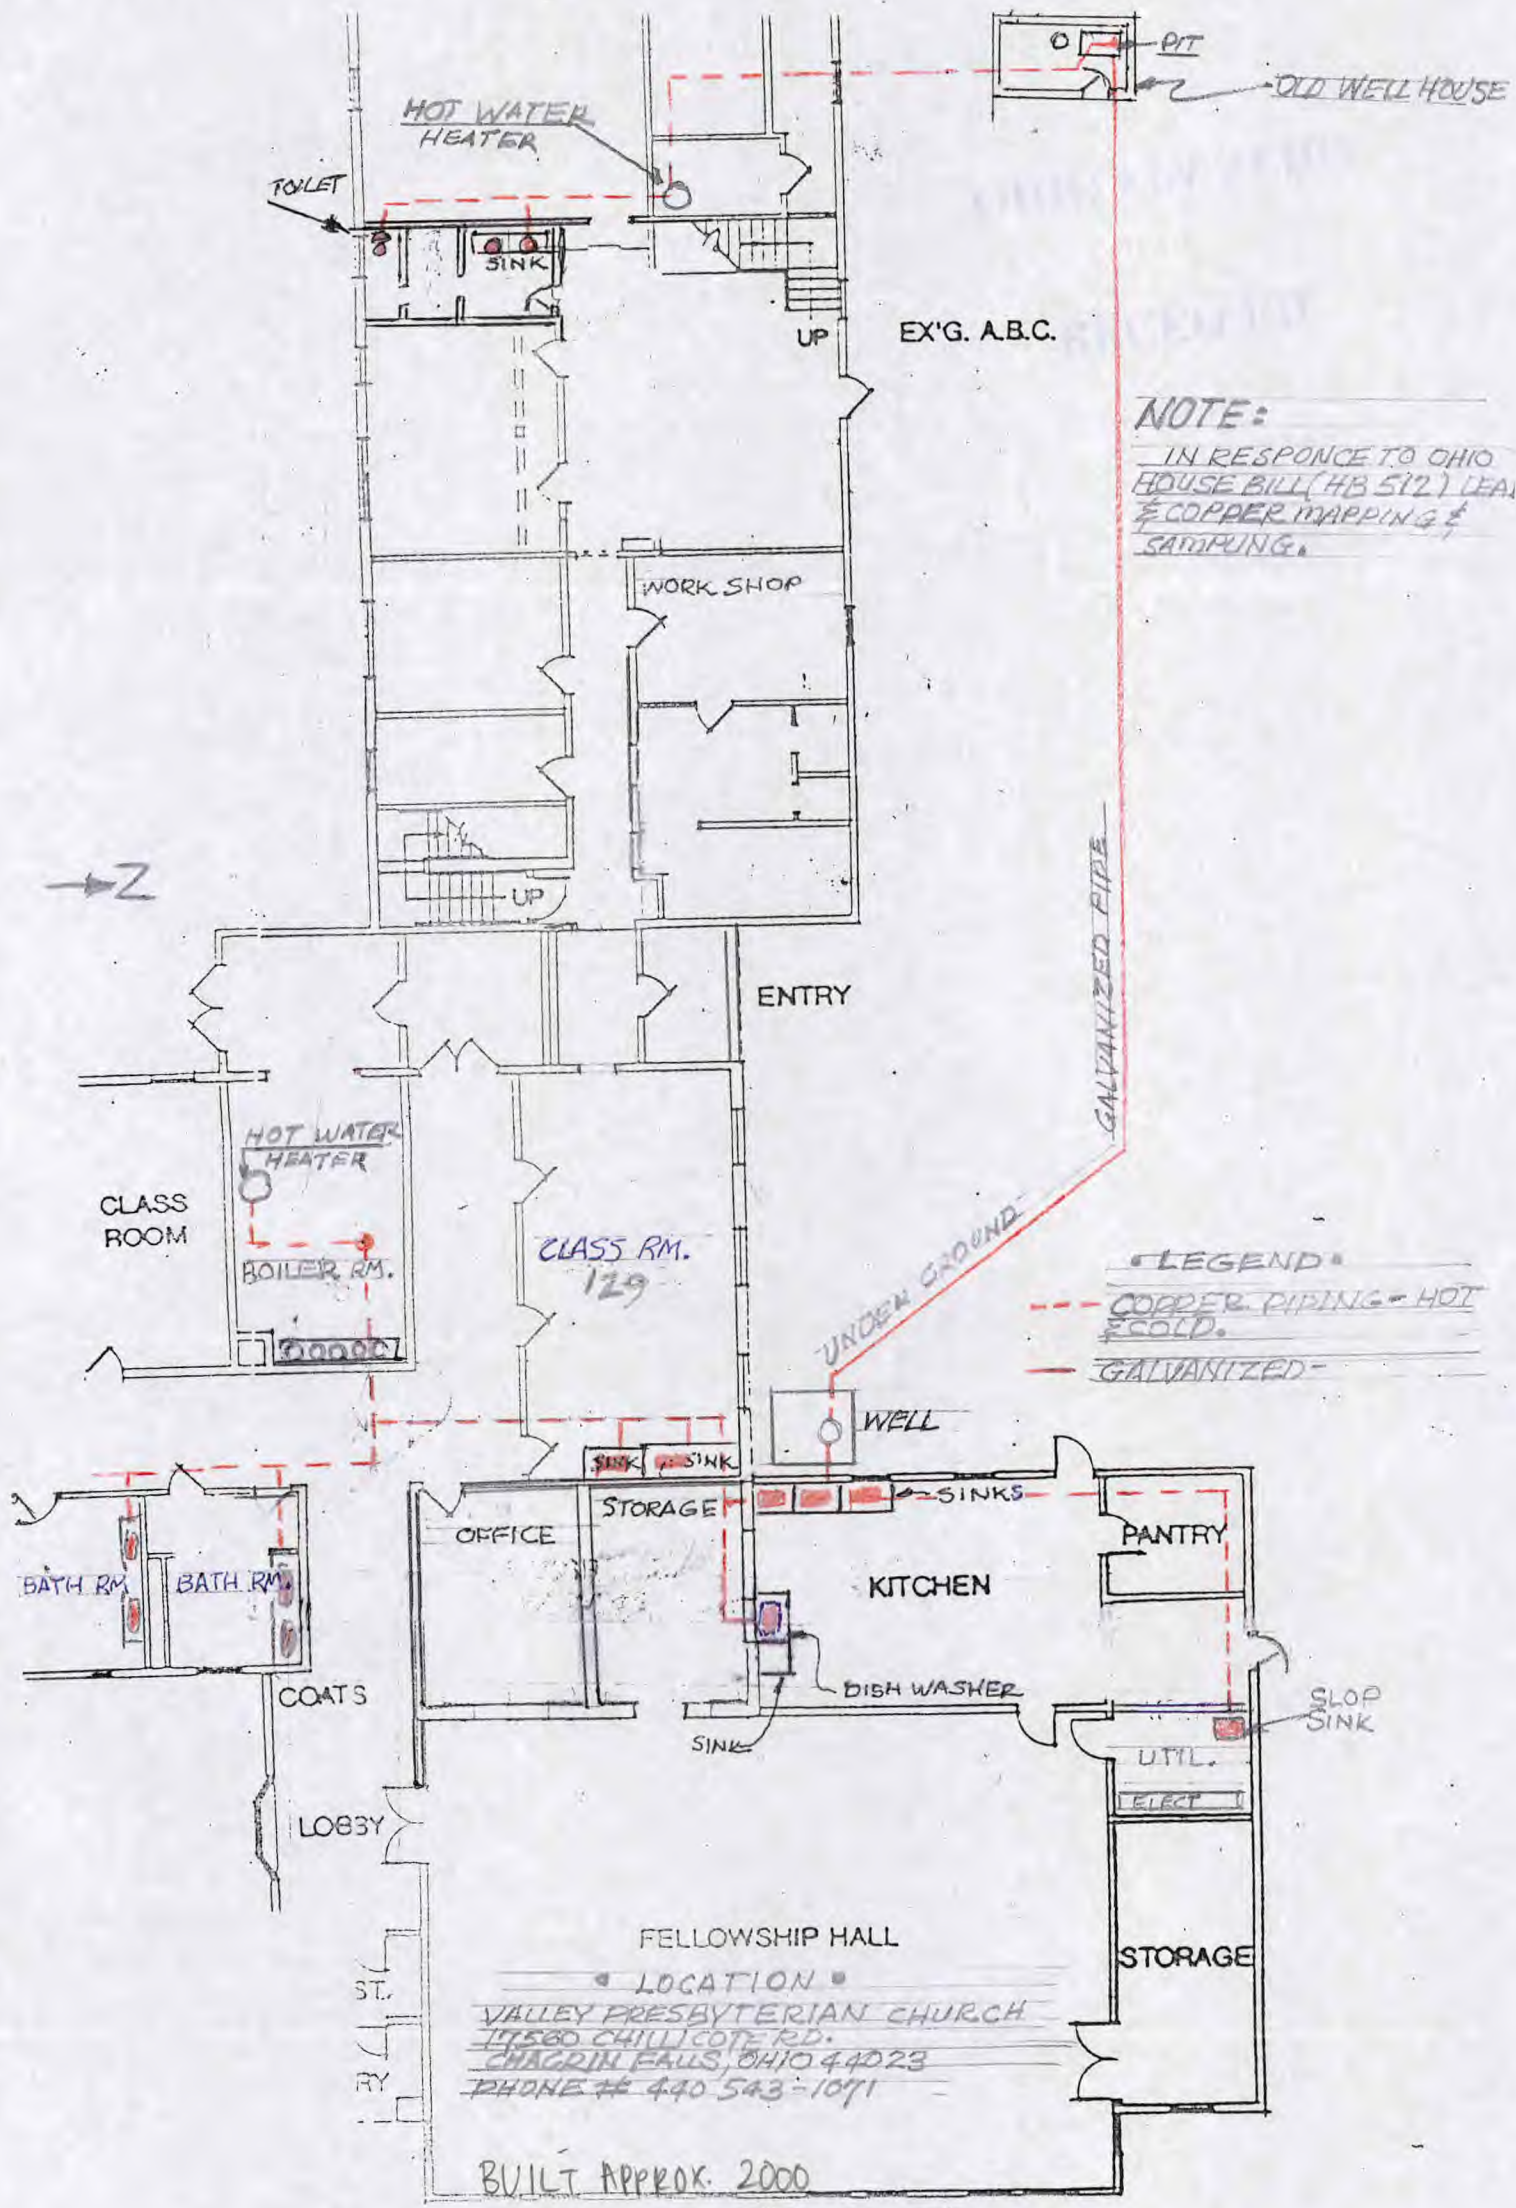

→ Z

EX'G. A.B.C.

OLD WELL HOUSE

GALVANIZED PIPE

UNDERGROUND

LEGEND

- - - - - COPPER PIPING - HOT & COLD.
 ——— GALVANIZED ———

LOCATION
 VALLEY PRESBYTERIAN CHURCH
 11560 CHILICOTHE RD.
 CHAGRIN FALLS, OHIO 44023
 PHONE # 440 543-1071

BUILT APPROX. 2000