

CORDLE MOBILE HOME PARK

3290 US Highway 42 SW
London, OH 43140



Phone: 740.507.6208

ccordle2@columbus.rr.com

Fax: 775.514.6565

March 1, 2017

Dear Katie Anderson:

Enclosed please find the map of our water distribution system and the listing of sampling locations for lead and copper testing. This is being provided as required by Ohio House Bill 512. Our water lines are plastic and are highlighted in yellow on the map. We have no lead piping in our mobile home park.


In you have any question concerning the information provided please let me know.

Sincerely,

A handwritten signature in black ink that reads "Craig R. Cordle".

Craig R. Cordle, *Owner*

Back Section of Park

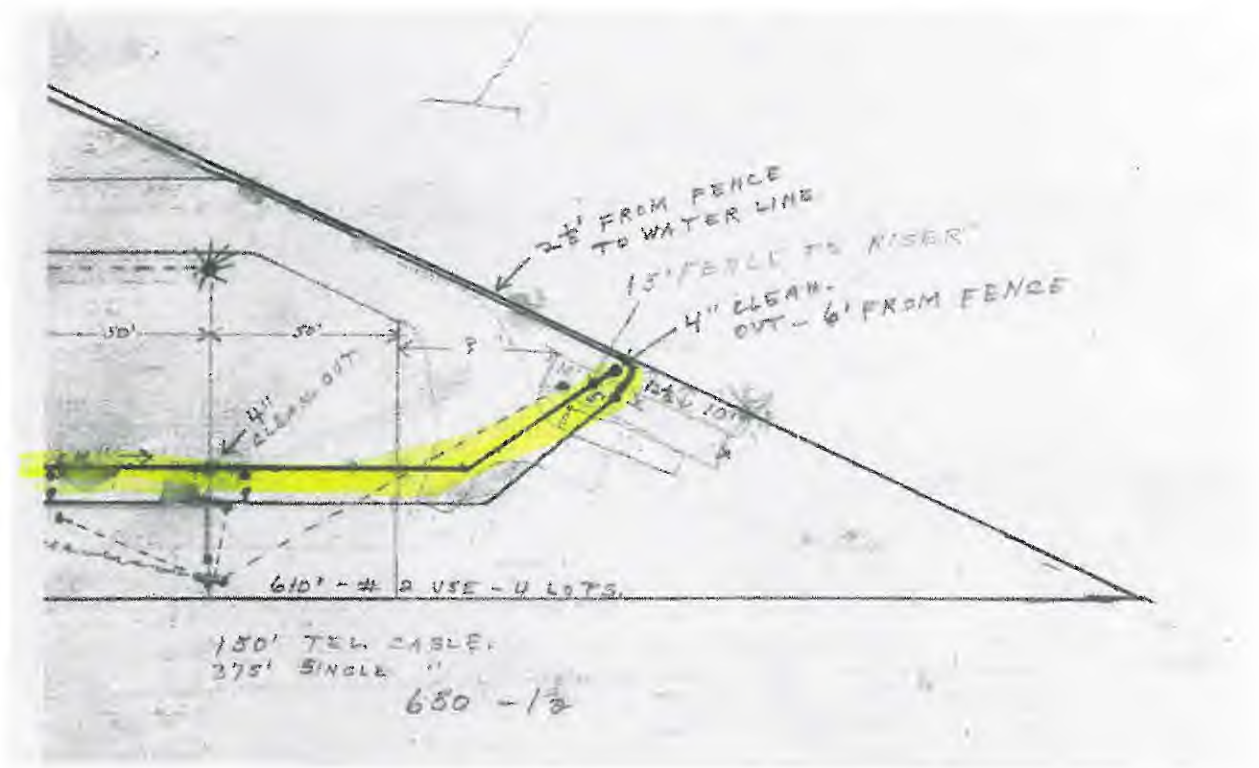

Buildings in Ohio built prior to 1998 or that use plumbing material or solder manufactured before 1998 may have materials with greater than 8% lead and are at a higher risk of contributing lead to the drinking water than materials manufactured after 1998. In addition, buildings built and plumbing materials manufactured after 2014 were required to have less than 0.25% lead by weight and have the lowest risk for contributing lead to the drinking water. It should be noted however that, although prohibited, some use of leaded solder or leaded components may have occurred after the prohibitions became effective.

**VERIFICATION FORM FOR COMMUNITY PUBLIC WATER SYSTEMS
CLAIMING NO LEAD SERVICE LINES**

The owner or operator of all community public water systems must identify and map areas of their distribution system that are known or are likely to contain lead service lines. Systems must submit a copy of the applicable map to the Ohio Department of Health and the Ohio Department of Job and Family Services. Systems must also submit a report to the director containing at least both of the following: (1) The applicable map with narrative, and (2) A list of sampling locations used to collect samples as required by Ohio Revised Code (ORC) Section 6109.121 and any rules adopted thereunder, including contact information for the owner and occupant of each sampling site.

Should a water system determine no lead service lines exist in their distribution system, they must provide information stating they reviewed, at the minimum, historical permit records and local ordinances, distribution maintenance records and information pertaining to installation dates or materials for all services lines. This information must be verified below.

I HEREBY CERTIFY THAT THE FOLLOWING METHOD(S) WERE USED TO DETERMINE NO LEAD SERVICE LINES EXIST IN THIS WATER SYSTEM'S DISTRIBUTION SYSTEM, AS REQUIRED BY ORC 6109.121(F):

LEAD SERVICE LINE VERIFICATION
<p>This PWS states they have no lead service lines and has reviewed the following information (select one or more of the following):</p> <ul style="list-style-type: none"><input type="checkbox"/> Historical permit records and/or local ordinances<input type="checkbox"/> Distribution maintenance records (i.e. meter replacement, waterline break repairs)<input type="checkbox"/> Information pertaining to installation dates for all service lines (i.e. after 1986 when lead services lines were banned)<input checked="" type="checkbox"/> Service line material of all service lines is known (i.e. all service lines are known to be PVC)

Craig R. Cordle 3-6-17
Signature of Responsible Person Date

CRAIG R. CORDLE
Printed Name and Title of Responsible Person

PWS NAME: CORDLE MHP
PWS ID: OH 4900312
COUNTY: MADISON

<p>For Ohio EPA use only:</p> <p>Date Verification Rec'd: <u>3/6/17 KA</u></p>

Entity: Cordles MHP

Doc Type: Report

Doc Subtype: —

Program: Drinking Water

County: Madison

Secondary ID: OH4900312

Rec'd: 3/6/17