


Dawson's Mobility Home Park

← 2

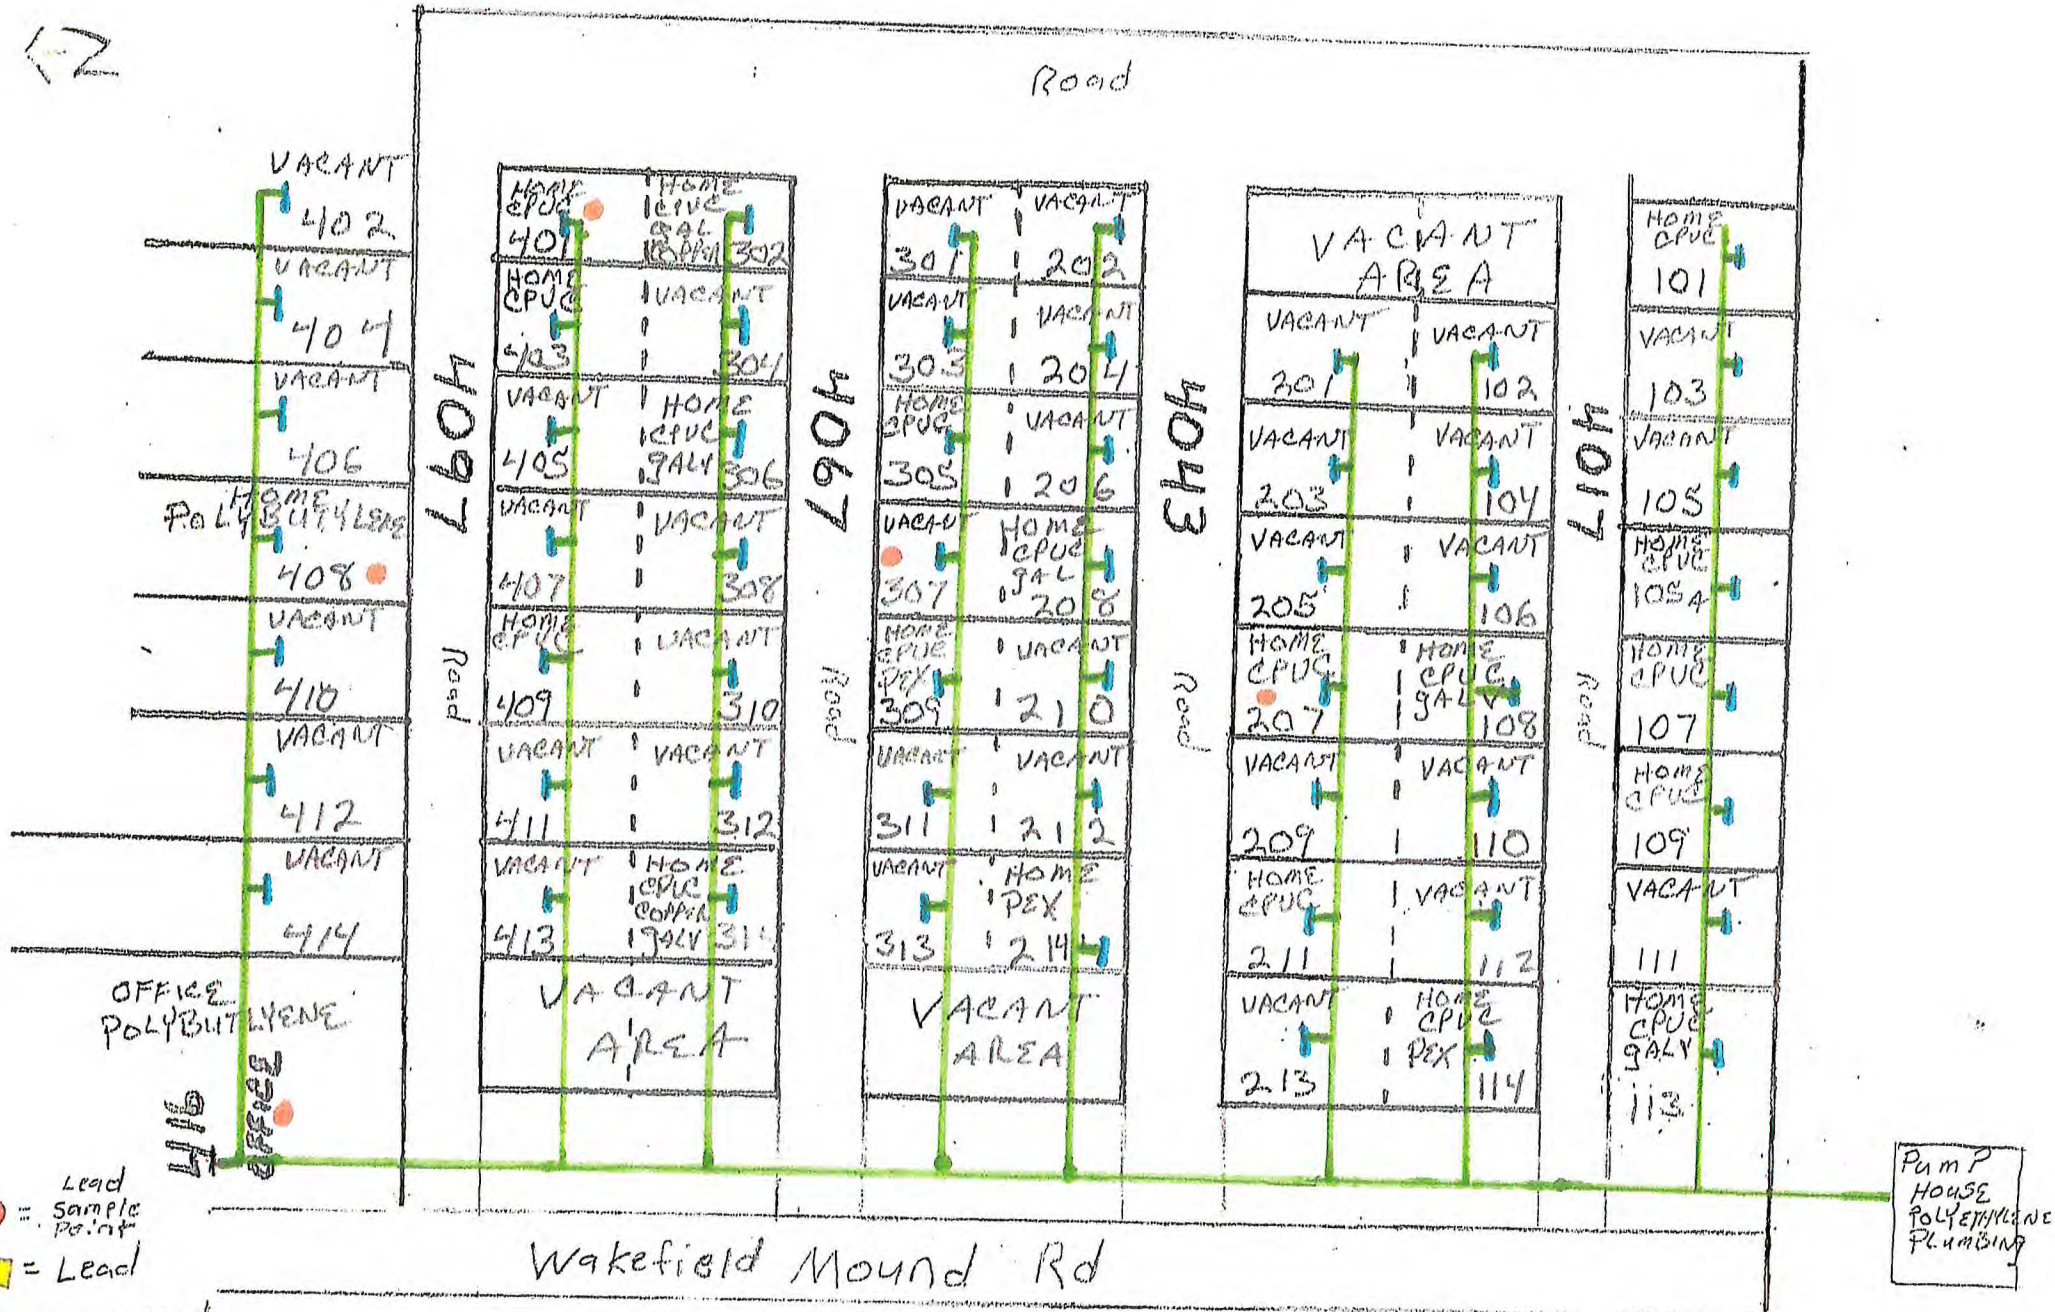

**Buildings Served By the Water System Likely to Contain Lead
Solder, Plumbing or Fixtures**

1. **4067 lot # 302** - has some copper plumbing; may contain lead solder
2. **4067 lot # 314** - has some copper plumbing; may contain lead solder

* The water system contains brass valves which could contain lead.