

All potable distribution lines are PVC. Copper plumbing is used in restrooms/locker rooms and sinks for hand washing. There are no lead lines.

Miba Bearings US
 McCONNELSVILLE, OHIO
 GROUND FLOOR PLAN

92,008 SQ FT: TOTAL GROUND FLOOR AREA


SCALE: 1" = 32'-0"

Legend

- Distribution line
- DF Drinking fountain
- * in sample location

Toilets, sinks, and Showers

↑ water line goes to upper level.

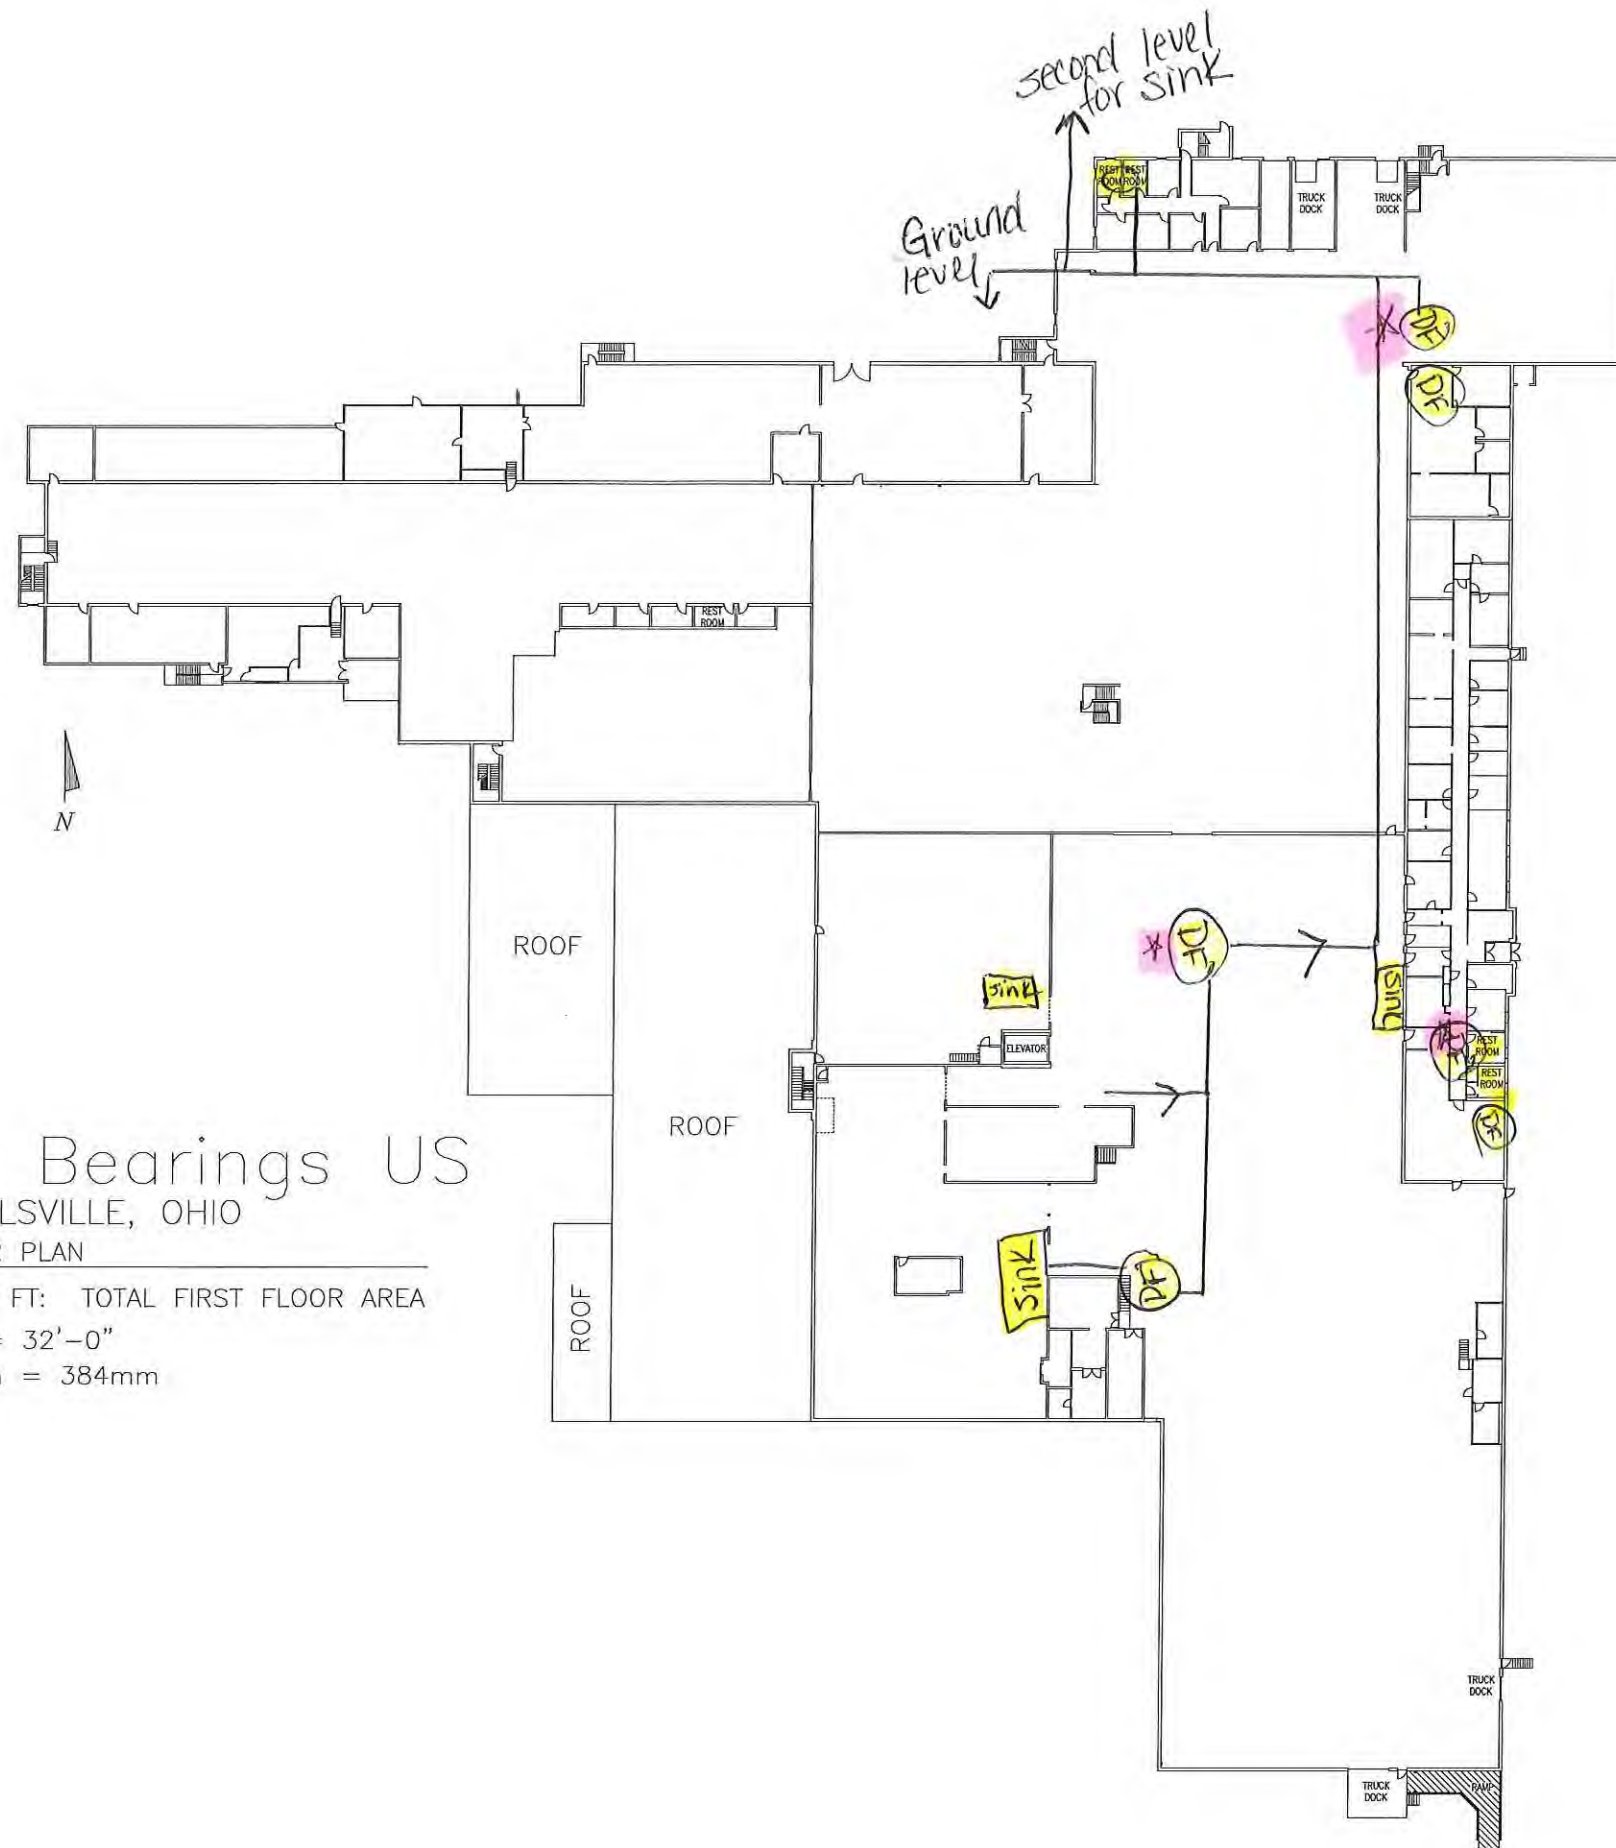

Miba Bearings US
 McCONNELSVILLE, OHIO
 FIRST FLOOR PLAN
 136,635 SQ FT: TOTAL FIRST FLOOR AREA
 SCALE: 1" = 32'-0"
 SCALE: 1mm = 384mm