

RE: Shelby City  
Report  
Drinking Water Program  
Richland County  
PWS ID: OH7004511

**Shelby Municipal  
Utilities Office**

23 E. Main St. • Shelby, Ohio 44875  
PHONE: 419-342-4085 • FAX: 419-347-8850



STEVEN L. SCHAG, Mayor  
JOHN ENSMAN, Director of Utilities  
AMBER CASTOR, Utilities Office Manager

3/3/17

Ohio Department of Health  
Lead Program  
246 North High Street  
Columbus, Ohio 43215

**RECEIVED**

MAR 03 2017

DDAGW - NWDO

To whom it may concern,

**VII. Submittal Requirements – Lead Mapping in the Distribution System**


1. A. Lead map is provided. Please see Exhibit A
1. B. A narrative description is provided. Please see Exhibit B
1. C. A list of our Tier 1 Lead & Copper Sampling locations is provided. Please see Exhibit C

John Ensman  
Utilities Director  
City of Shelby  
Utilities Office  
23 East Main Street  
Shelby, Ohio 44875

MAR 03 2017

DDAGW - NWDO

# CITY OF SHELBY RICHLAND COUNTY, OHIO

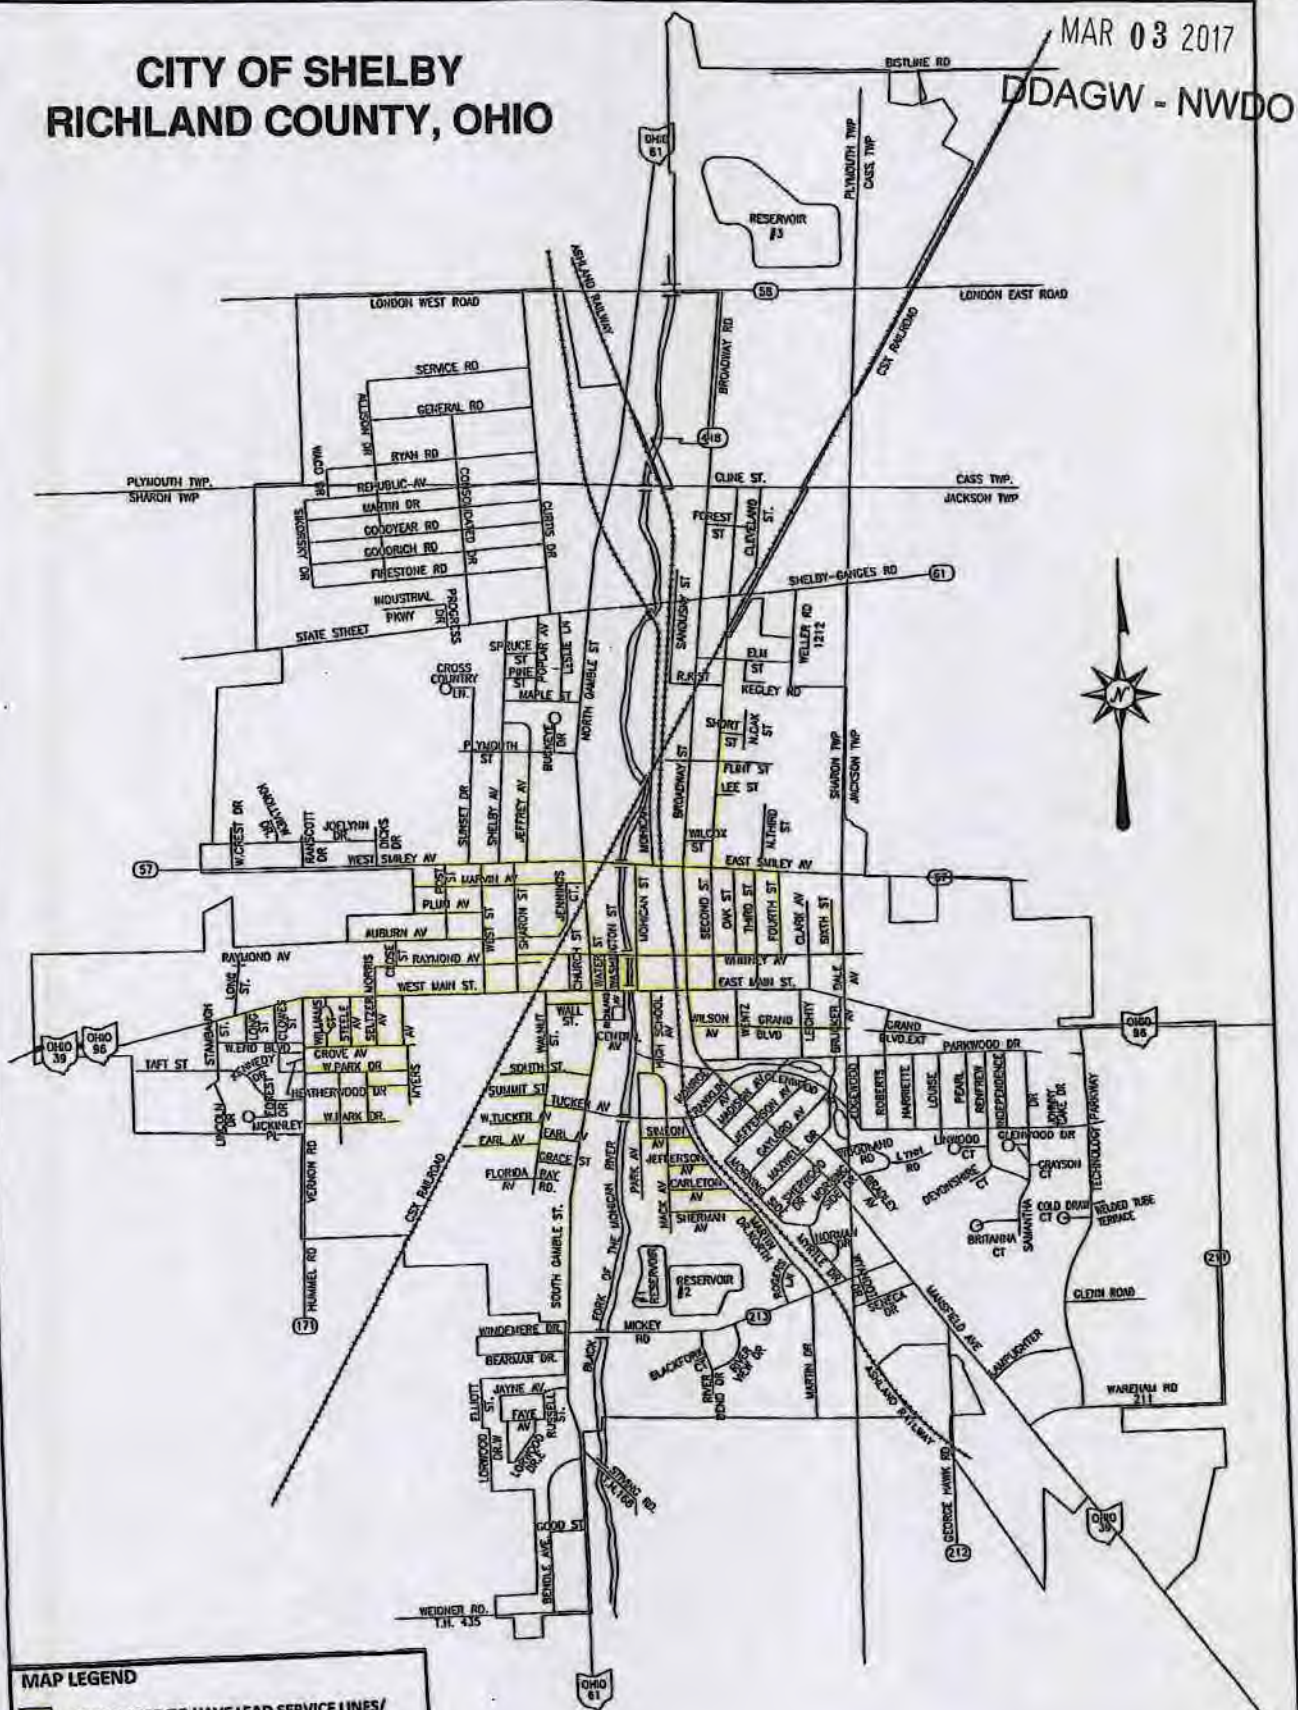

**MAP LEGEND**

- CONSIDERED TO HAVE LEAD SERVICE LINES/  
POSSIBLE LEAD IN PLUMBING & FIXTURES
- CONSIDERED NOT TO HAVE LEAD SERVICE LINES/  
POSSIBLE LEAD IN PLUMBING & FIXTURES

**Shelby Municipal  
Utilities Office**

23 E. Main St. • Shelby, Ohio 44875  
PHONE: 419-342-4085 • FAX: 419-347-8850



STEVEN L. SCHAG, Mayor  
JOHN ENSMAN, Director of Utilities  
AMBER CASTOR, Utilities Office Manager

---

**Exhibit B**

3/3/17

Following is a narrative of the included Lead Service Line Location Identification Map for the City of Shelby, Ohio.

All roadways highlighted in yellow are considered to have possible lead service lines and may have lead in the plumbing and fixtures in the structures.

All roadways that are not highlighted are not considered to have lead service lines and may have lead in the plumbing and fixtures in the structures.

This information was compiled from our water distribution card files held at the City of Shelby Service Department, Division of Water Distribution. Additional information was obtained from our employee base providing over 17 years of knowledge of our water distribution system, service lines & shut-off valves.

The City of Shelby has been actively involved in replacing lead components when identified during a water main break repair.

**RECEIVED**

MAR 03 2017

DDAGW - NWDO