

RE: Lindsey Village Water
Report
Drinking Water Program
Sandusky County
PWS ID: OH7200512

RECEIVED

MAR 03 2017

DDAGW - NWDO

WATER SYSTEM LEAD SERVICE MAP FOR

Village of Lindsey

SANDUSKY COUNTY, OHIO

BUILDING NOTE:

BUILDINGS IN OHIO BUILT PRIOR TO 1986 OR THAT USE PLUMBING MATERIAL OR SOLDER MANUFACTURED BEFORE 1986 MAY HAVE MATERIALS WITH GREATER THAN 8% LEAD AND ARE AT A HIGHER RISK OF CONTRIBUTING LEAD TO THE DRINKING WATER THAN MATERIALS MANUFACTURED AFTER 1986. IN ADDITION, BUILDINGS BUILT AND PLUMBING MATERIALS MANUFACTURED AFTER 2014 WERE REQUIRED TO HAVE LESS THAN 0.25% LEAD BY WEIGHT AND HAVE THE LOWEST RISK FOR CONTRIBUTING LEAD TO THE DRINKING WATER. IT SHOULD BE NOTED HOWEVER THAT, ALTHOUGH PROHIBITED, SOME USE OF LEADED SOLDER OR LEADED COMPONENTS MAY HAVE OCCURRED AFTER THE PROHIBITIONS BECAME EFFECTIVE.


NOTE: FOR ALL COPPER PIPE ON THE PRIVATE SIDE, THE MATERIALS IN THE FITTINGS AND FITTURES IS UNKNOWN.

LEGEND

- 110 HOUSE NUMBER
- EXISTING HYDRANT
- EXISTING WATER WELL
- EXISTING WATER VALVE
- EXISTING ARRESTOS CEMENT WATER MAIN (NO LEAD) (1945-1960) ON VILLAGE BYA
- EXISTING PLASTIC WATER MAIN (NO LEAD)
- EXISTING COPPER WATER SERVICE (1940-1960) ON VILLAGE BYA
- PUBLIC SIDE = COPPER (NON-LEAD) PRIVATE SIDE = COPPER (PRE 1986)
- PUBLIC SIDE = COPPER (NON-LEAD) PRIVATE SIDE = NON-LEAD (2014 & AFTER)
- PUBLIC SIDE = COPPER (NON-LEAD) PRIVATE SIDE = COPPER (PRE 1986) & PLASTIC
- PUBLIC SIDE = COPPER (NON-LEAD) PRIVATE SIDE = COPPER (1988-2013) & PLASTIC
- PUBLIC SIDE = COPPER (NON-LEAD) PRIVATE SIDE = COPPER (1989-2013)
- PUBLIC SIDE = COPPER (NON-LEAD) PRIVATE SIDE = COPPER (1988-1997) & GALVANIZED
- PUBLIC SIDE = COPPER (NON-LEAD) PRIVATE SIDE = COPPER (PRE 1986) & UNKNOWN
- PUBLIC SIDE = COPPER (NON-LEAD) PRIVATE SIDE = PLASTIC, NON-LEAD
- PUBLIC SIDE = COPPER (NON-LEAD) PRIVATE SIDE = COPPER (PRE 1986) PLASTIC & UNKNOWN
- PUBLIC SIDE = COPPER (NON-LEAD) PRIVATE SIDE = COPPER (PRE 1986) PLASTIC & GALVANIZED
- PUBLIC SIDE = COPPER (NON-LEAD) PRIVATE SIDE = LEAD & COPPER (PRE 1986)
- PUBLIC SIDE = COPPER (NON-LEAD) PRIVATE SIDE = COPPER (1988-2013) & GALVANIZED
- PUBLIC SIDE = COPPER (NON-LEAD) PRIVATE SIDE = COPPER (PRE 1986) & GALVANIZED
- PUBLIC SIDE = COPPER (NON-LEAD) PRIVATE SIDE = COPPER (1988-1997)
- PUBLIC SIDE = COPPER (NON-LEAD) PRIVATE SIDE = PLASTIC & UNKNOWN
- PUBLIC SIDE = COPPER (NON-LEAD) PRIVATE SIDE = COPPER (1988-1997) PLASTIC
- PUBLIC SIDE = COPPER (NON-LEAD) PRIVATE SIDE = GALVANIZED
- PUBLIC SIDE = COPPER (NON-LEAD) PRIVATE SIDE = PLASTIC, GALVANIZED & UNKNOWN
- PUBLIC SIDE = COPPER (NON-LEAD) PRIVATE SIDE = LEAD, COPPER & PLASTIC
- PUBLIC SIDE = COPPER (NON-LEAD) PRIVATE SIDE = UNKNOWN
- PUBLIC SIDE = COPPER (NON-LEAD) PRIVATE SIDE = COPPER (PRE 1986) PLASTIC, GALVANIZED & UNKNOWN

LEAD/COPPER SAMPLE TESTING LOCATIONS

- 304 1/2 DEWEY ST, LINDSEY, OH 43442 (TIER 3)
- 317 LINCOLN ST, LINDSEY, OH 43442 (TIER 3)
- 117 N MAIN ST, LINDSEY, OH 43442 (TIER 3)
- 111 S MAIN ST, LINDSEY, OH 43442 (TIER 3)
- 414 S MAIN ST, LINDSEY, OH 43442 (TIER 3)
- 317 S MAPLE ST, LINDSEY, OH 43442 (TIER 3)
- 313 WALNUT ST, LINDSEY, OH 43442 (TIER 3)

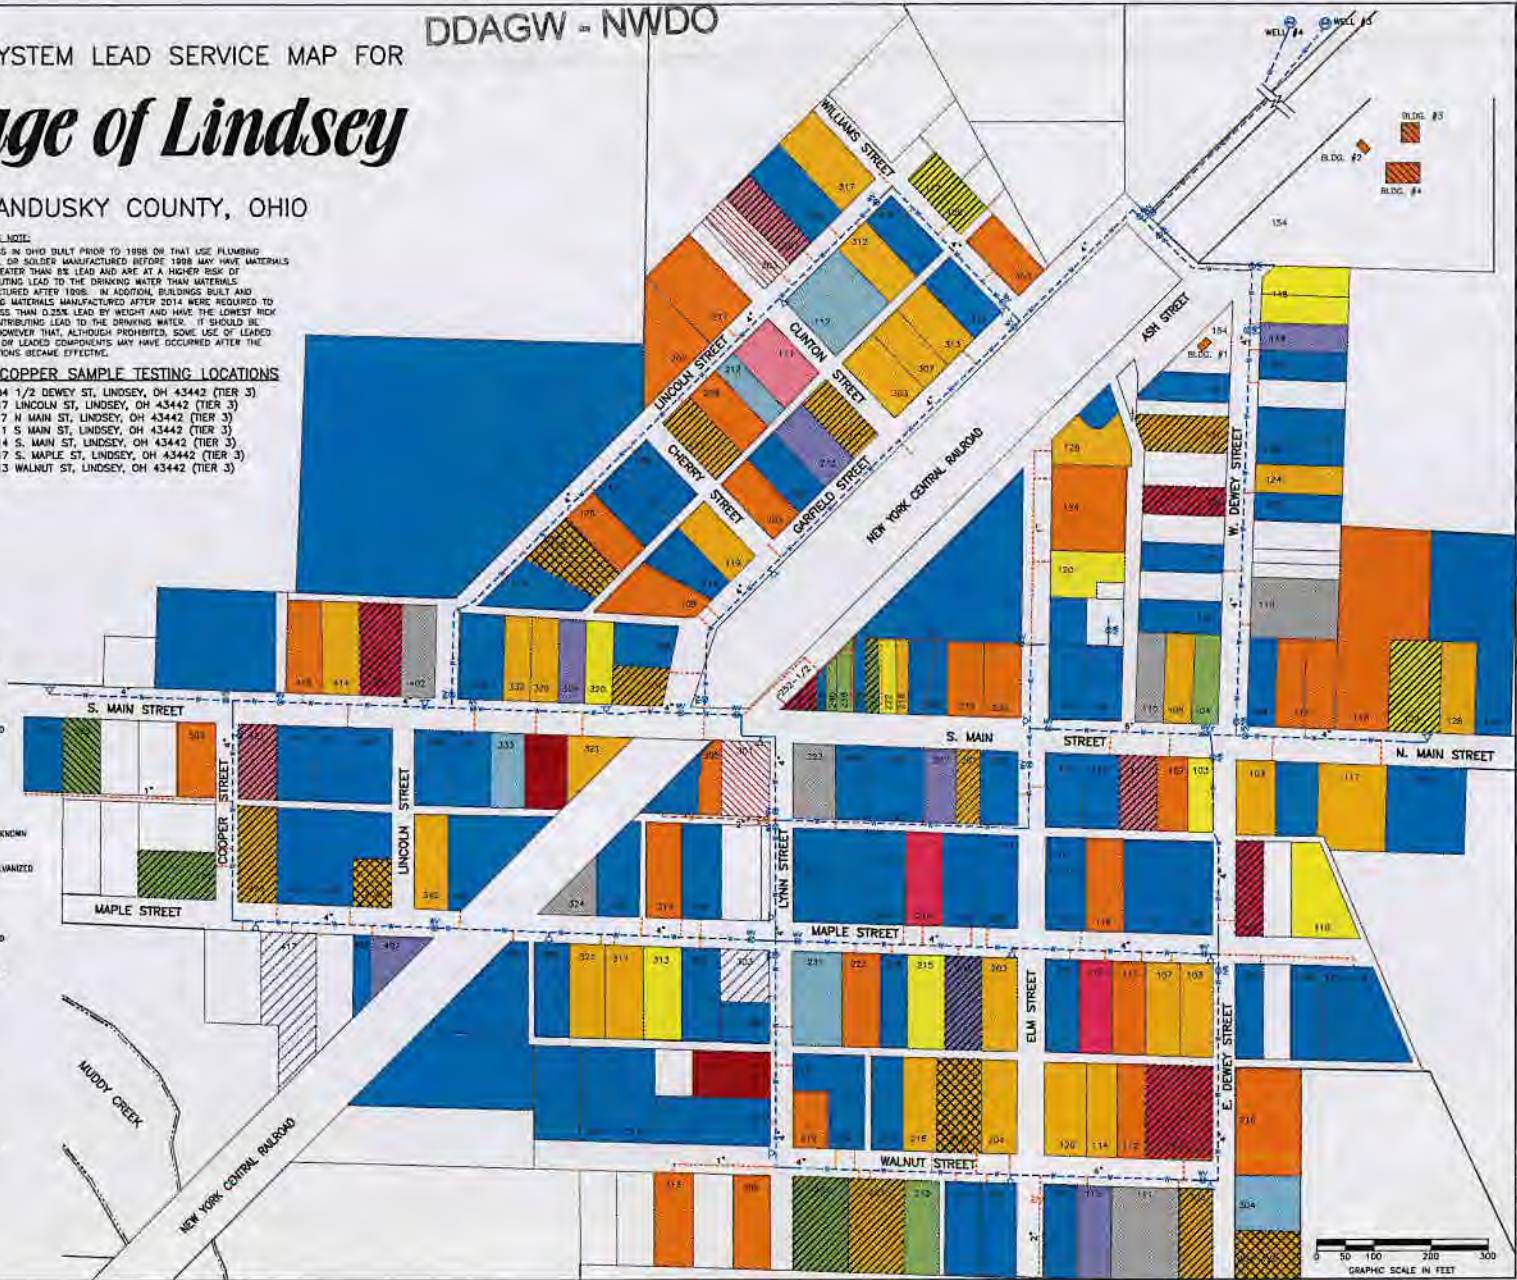

OHIO UTILITY PROTECTION SERVICE
CALL 1-800-392-2764
TWO WORKING DAYS
BEFORE YOU GO



FellerFinch
A ASSOCIATES, INC.
Engineers Surveyors

DATE: _____
REVISED: _____

WATER SYSTEM LEAD SERVICE MAP
VILLAGE OF LINDSEY,
SANDUSKY COUNTY, OHIO

DATE: _____
SCALE: 1" = 100'
SHEET: 3-3-17
DRAWN BY: JRS
CHECKED BY: JRS
PROJECT: 10000370
DRAWING: 10-083700001

SHEET 1 of 1

