

RE: Lucas Village
Report
Drinking Water Program
Richland County
PWS ID: OH7002612



RECEIVED

MAR 06 2017

OHIO E.P.A.
N.W.D.O.

February 24, 2017

Village of Lucas
101 First Avenue.
Lucas, OH 44843

The Village of Lucas has no known lead service lines located within the Village of Lucas water distribution system.

Verification, to best of our knowledge, is based on the following information:

1. Village of Lucas Ordinance #O-305-61 (1961) Section 205 required only copper service lines to be used within the Village of Lucas water distribution system. Ordinance #O-07-99 (1999) also requires copper service lines to be utilized within the Village of Lucas.
2. Based on 25 years working experience in the Village of Lucas water distribution system, making repairs, meter replacements, etcetera, the current water operator has no record of any lead service lines or lead lines of any type within the Village water system.
3. Based on the experience and records available, some service lines installed prior to 1961 were galvanized in nature.

Please contact the Village Administrator and Certified Water Operator, Tim Stallard, with any questions or comments concerning this information at the Lucas village office at 419-892-2178 or by e-mail at Lucaststallard@aol.com.

Thank You,

Tim Stallard, Village Administrator
Village of Lucas
419-892-2178 office
419-892-2999 fax
Lucaststallard@aol.com

"The Quiet & Peaceful Village"


**VERIFICATION FORM FOR COMMUNITY PUBLIC WATER SYSTEMS
CLAIMING NO LEAD SERVICE LINES**

The owner or operator of all community public water systems must identify and map areas of their distribution system that are known or are likely to contain lead service lines. Systems must submit a copy of the applicable map to the Ohio Department of Health and the Ohio Department of Job and Family Services. Systems must also submit a report to the director containing at least both of the following: (1) The applicable map with narrative, and (2) A list of sampling locations used to collect samples as required by Ohio Revised Code (ORC) Section 6109.121 and any rules adopted thereunder, including contact information for the owner and occupant of each sampling site.

Should a water system determine no lead service lines exist in their distribution system, they must provide information stating they reviewed, at the minimum, historical permit records and local ordinances, distribution maintenance records and information pertaining to installation dates or materials for all services lines. This information must be verified below.

I HEREBY CERTIFY THAT THE FOLLOWING METHOD(S) WERE USED TO DETERMINE NO LEAD SERVICE LINES EXIST IN THIS WATER SYSTEM'S DISTRIBUTION SYSTEM, AS REQUIRED BY ORC 6109.121(F):

LEAD SERVICE LINE VERIFICATION	
<p>This PWS states they have no lead service lines and has reviewed the following information (select one or more of the following):</p> <ul style="list-style-type: none"> <input checked="" type="checkbox"/> Historical permit records and/or local ordinances <input checked="" type="checkbox"/> Distribution maintenance records (i.e. meter replacement, waterline break repairs) <input checked="" type="checkbox"/> Information pertaining to installation dates for all service lines (i.e. after 1986 when lead services lines were banned) <input type="checkbox"/> Service line material of all service lines is known (i.e. all service lines are known to be PVC) 	

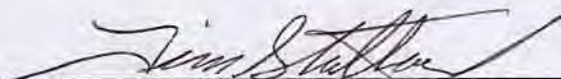
 Signature of Responsible Person Date 2/27/17
Tom Stallard Village Adm/Operator
 Printed Name and Title of Responsible Person

PWS NAME: Lucas Village of
PWS ID: OH 7002612
COUNTY: RICHLAND

<p>For Ohio EPA use only:</p> <p>Date Verification Rec'd: _____</p>
--

RECEIVED

MAR 06 2017

**OHIO E.P.A.
N.W.D.O.**


RECEIVED

MAR 06 2017

OHIO E.P.A.
N.W.D.O.

Buildings in Ohio built before 1998 or that use plumbing material or solder manufactured before 1998 may have materials with greater than 8% lead and are at a higher risk of contributing lead to the drinking water than materials manufactured after 1998. In addition, building built and plumbing materials manufactured after 2014 were required to have less than 0.25% lead by weight and have the lowest risk for contributing lead to the drinking water. It should be noted however that, although prohibited, some use of lead solder or lead components may have occurred after the prohibitions became effective.

← NORTH

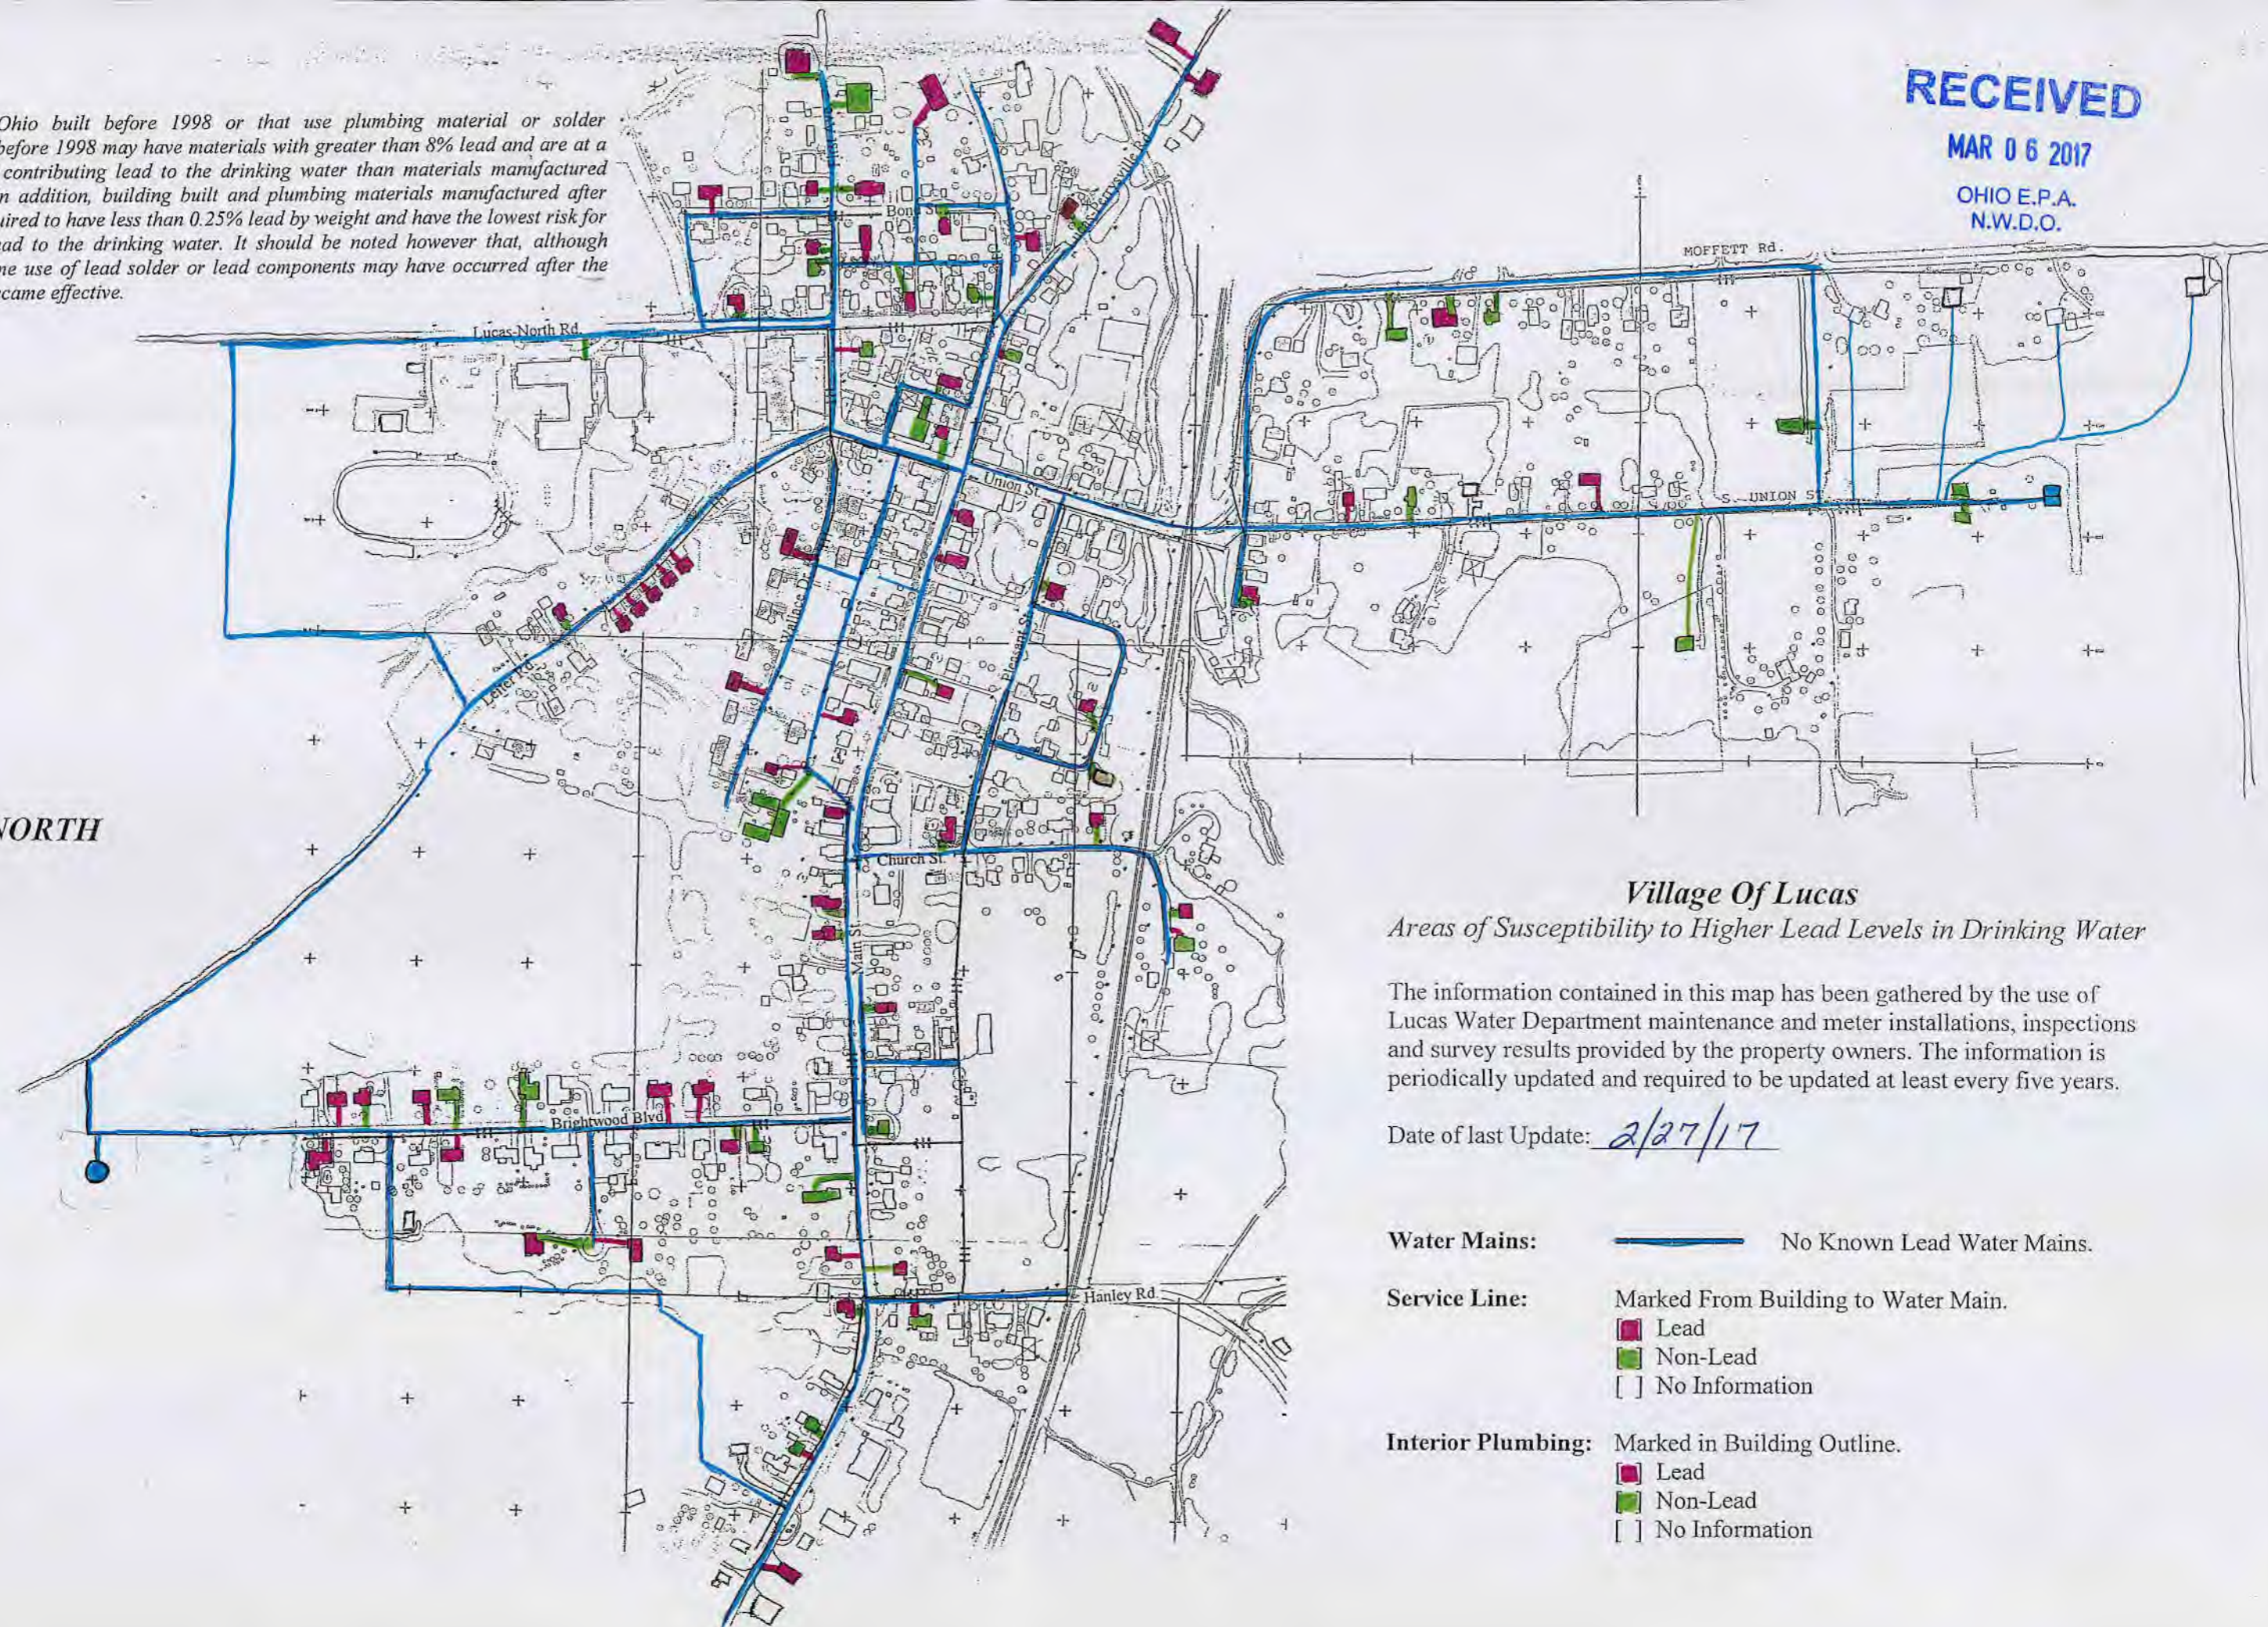

Village Of Lucas


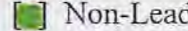

Areas of Susceptibility to Higher Lead Levels in Drinking Water

The information contained in this map has been gathered by the use of Lucas Water Department maintenance and meter installations, inspections and survey results provided by the property owners. The information is periodically updated and required to be updated at least every five years.


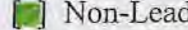

Date of last Update: 2/27/17

Water Mains:  No Known Lead Water Mains.

Service Line: Marked From Building to Water Main.

-  Lead
-  Non-Lead
-  No Information

Interior Plumbing: Marked in Building Outline.

-  Lead
-  Non-Lead
-  No Information