

RE: Oak Harbor Village
Report
Drinking Water Program
Ottawa County
PWS ID: OH6202603



VILLAGE OF OAK HARBOR

146 Church Street
P.O. Box 232
OAK HARBOR, OHIO 43449-0232
(419) 898-5561
Fax (419) 898-2519

Joe Helle
Mayor

2010 – 175 years as a Village
2011 – 100 years of Municipal Water
2014 – 100 years of Public Power

Randall L. Genzman
Village Administrator

Village of Oak Harbor
Lead Mapping Narrative
March 6, 2017

The Village of Oak Harbor water system was first operated in 1911. Several improvements have been made with the addition of elevated towers, clear well, new distribution mains and services. A majority of the existing homes were built prior to 1986. A marginal increase in residential construction was experienced between 1986 and 2011.

We currently sample twenty (20) residences on a three (3) year cycle. Upon this review, we are researching new tier one SMP's for future Lead and Copper sampling.

Our data was gathered through collection of tap records on file at our Department of Public Works, system upgrade blueprints and the experiences and knowledge of current and former water department employees.


Randall Genzman
Administrator

RECEIVED


MAR 06 2017

DDAGW - NWDO

RECEIVED

MAR 06 2017

DDAGW - NWDO

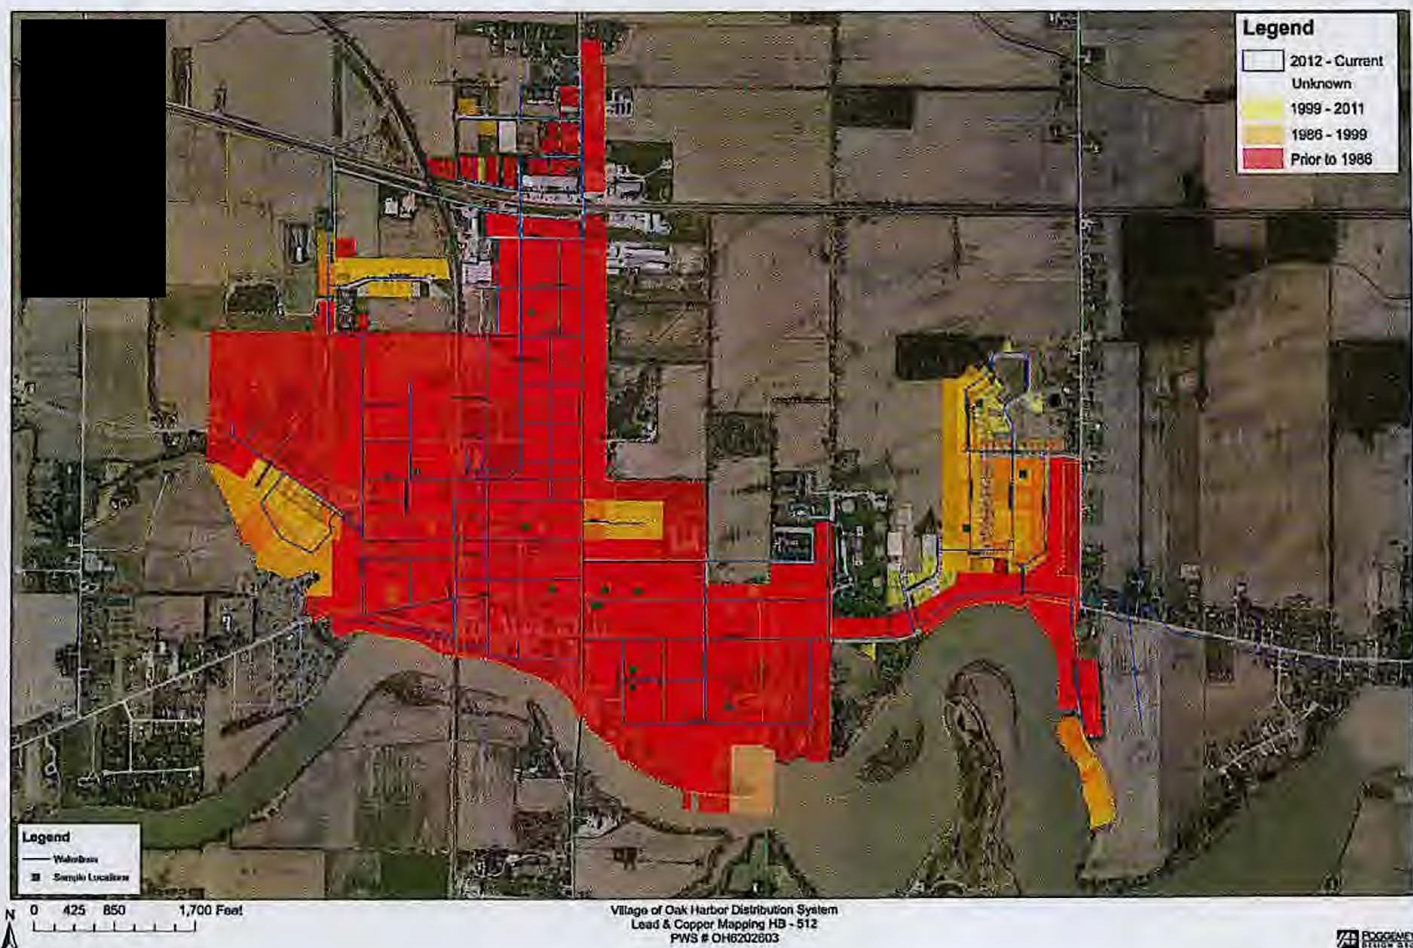

RECEIVED

MAR 06 2017

DDAGW - NWDO

