


RE: Safy of America Headquarters
Report
Drinking Water Program
Allen County
PWS ID: OH0254912

SAFY of America
10100 Elida Rd.
Delphos, OH 45833

PWS ID:
OH 0254912

NORTH

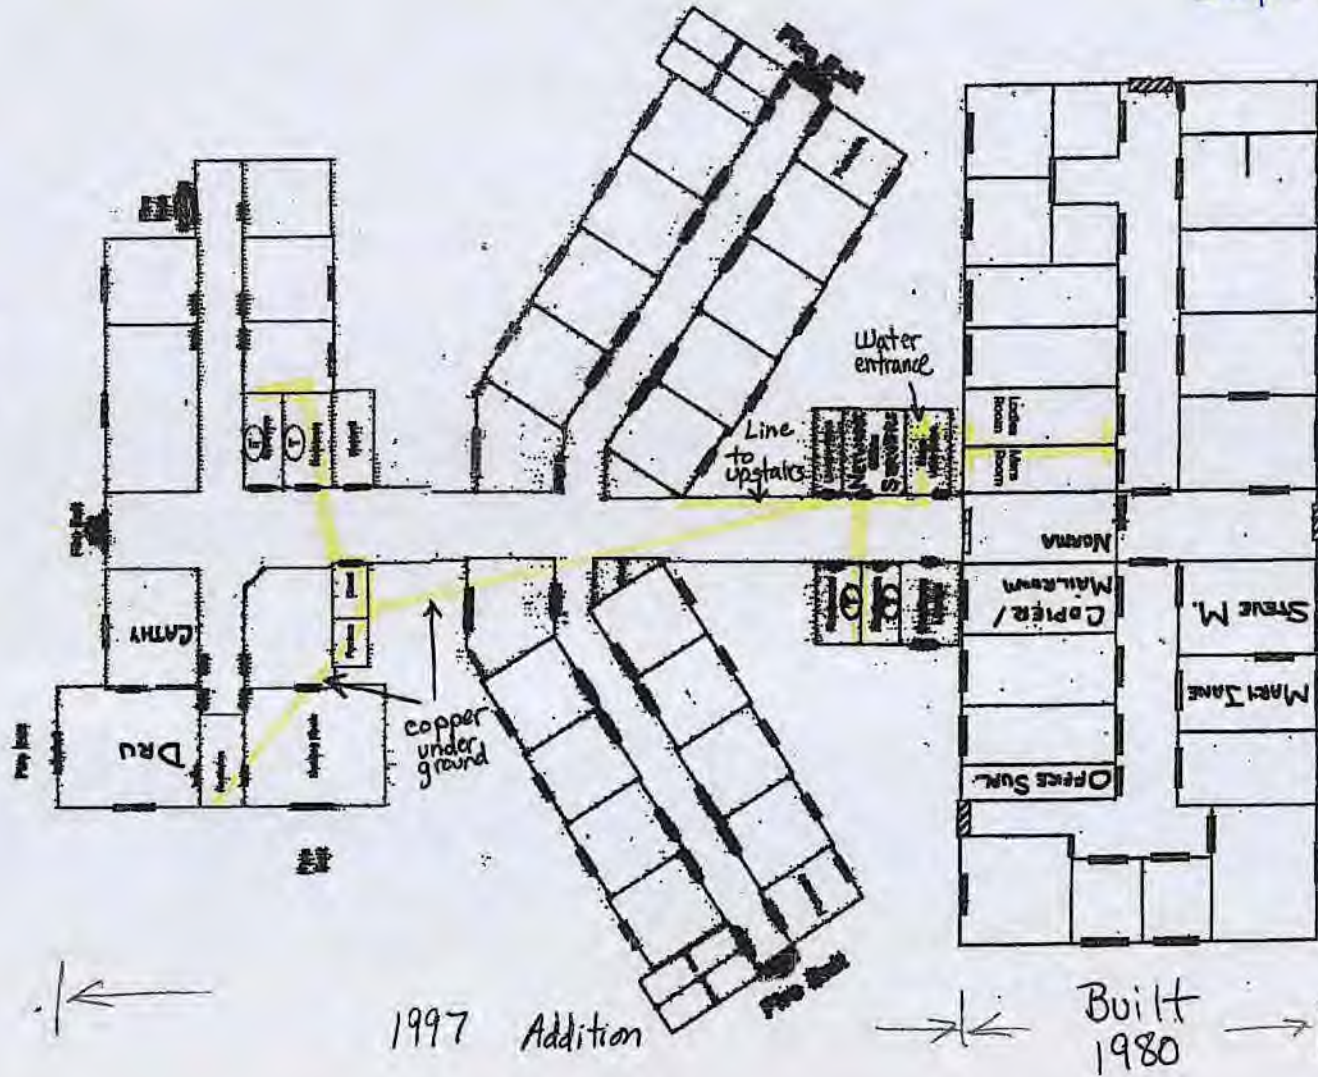

RECEIVED
MAR 06 2017
DDAGW - NWDO

Elida Rd.

water lines

SAFY OFFICE
10100 Elida Rd.
Delphos, OH 45833

PWS ID:
OH 0254912

N



Upstairs

Water lines

1997 addition

Elida Rd