

RE: Hicksville Village
Report
Drinking Water Program
Defiance County
PWS ID: OH2000212

March 1, 2017

The Village of Hicksville Water Department is aware of one (1) lead service line attached to the Village's water system. That service supplies 614 E. High St. It has always been a part of our Lead & Copper sampling routine group, and it has always tested below the Action Level.

Based on the age of the water system, it would be natural to assume there may be more lead service lines, however; none have been located or verified to date.

Our routine and back-up sampling locations are concentrated on the older parts of the water system infrastructure that have the potential for lead joints and/or fittings.


Jessica Elson
Water Superintendent
Village of Hicksville
419.542.8984
HixWater@defnet.com

RECEIVED

MAR 06 2017

DDAGW - NWDO

RECEIVED
 MAR 06 2017
 DDAGW - NWDO

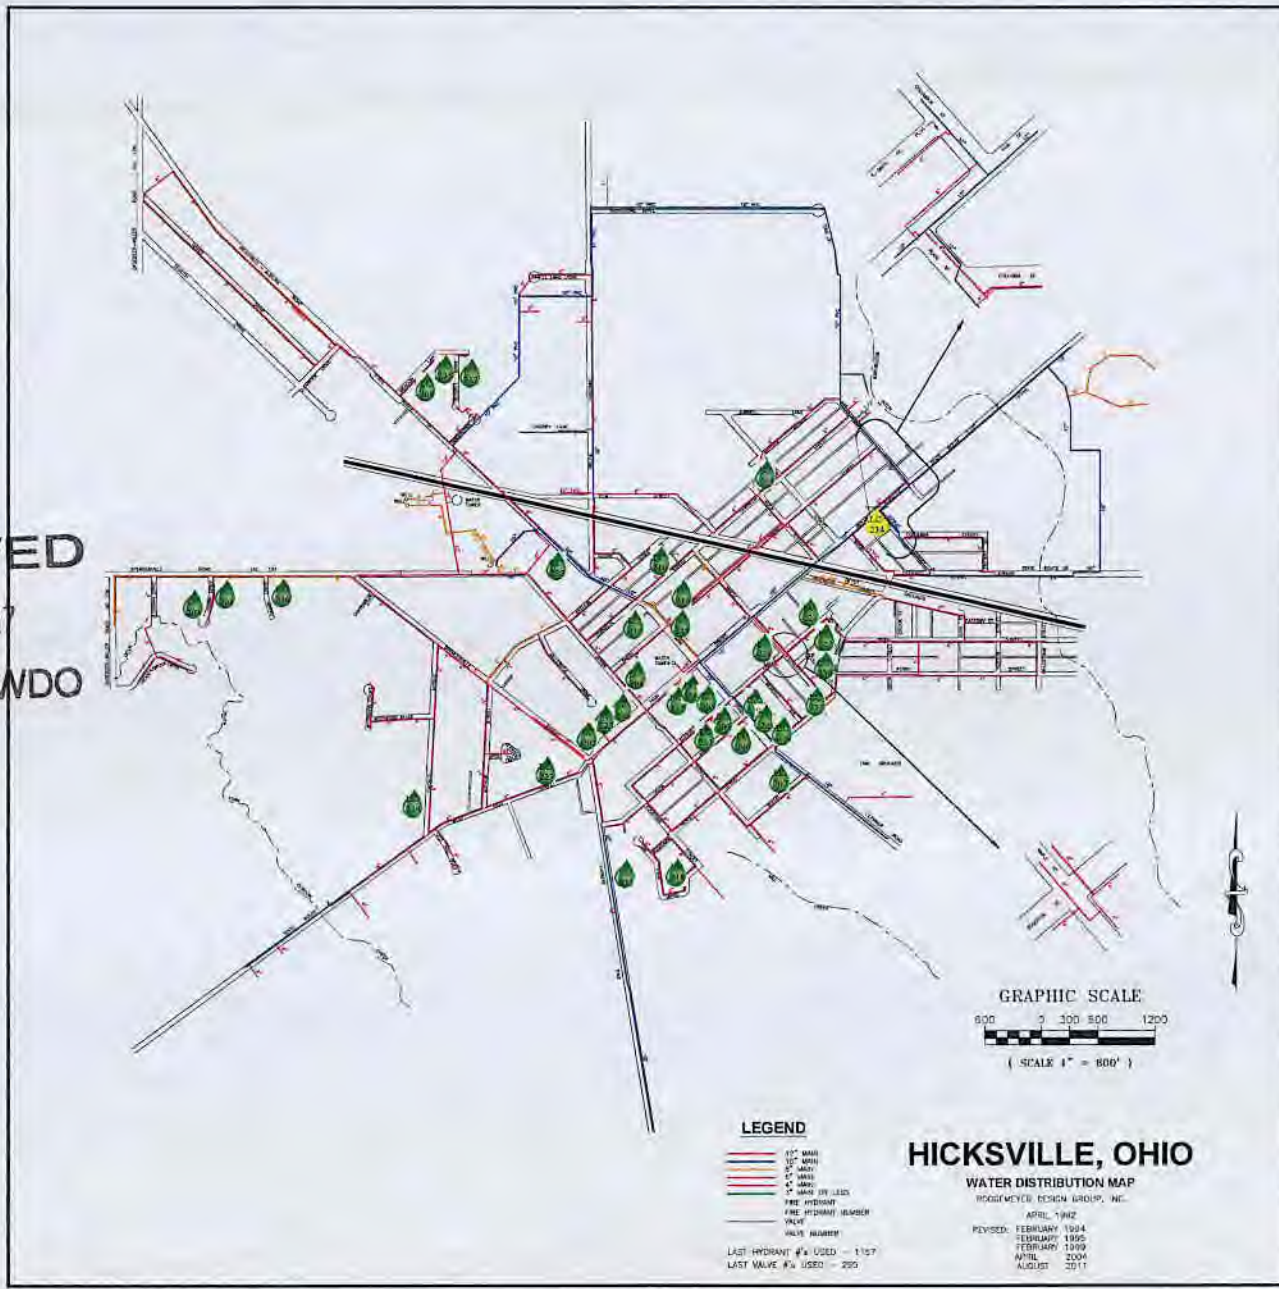

- LEGEND**
- 12" MAIN
 - 10" MAIN
 - 8" MAIN
 - 6" MAIN
 - 4" MAIN
 - 2" MAIN BY LEAD
 - FIRE HYDRANT
 - FIRE HYDRANT NUMBER
 - VALVE
 - VALVE NUMBER
- LAST HYDRANT #'s USED - 1157
 LAST VALVE #'s USED - 289

HICKSVILLE, OHIO
 WATER DISTRIBUTION MAP
 PROCEMCO DESIGN GROUP, INC.
 APRIL 1982
 REVISED: FEBRUARY 1984
 FEBRUARY 1995
 FEBRUARY 1999
 APRIL 2004
 AUGUST 2017