

RE: Rawson Village Water
Report
Drinking Water Program
Hancock County
PWS ID: OH3200612


WATER SYSTEM LEAD SERVICE MAP

Village of Rawson Hancock County, Ohio

RECEIVED

MAR 06 2017

DOAGW - NW00

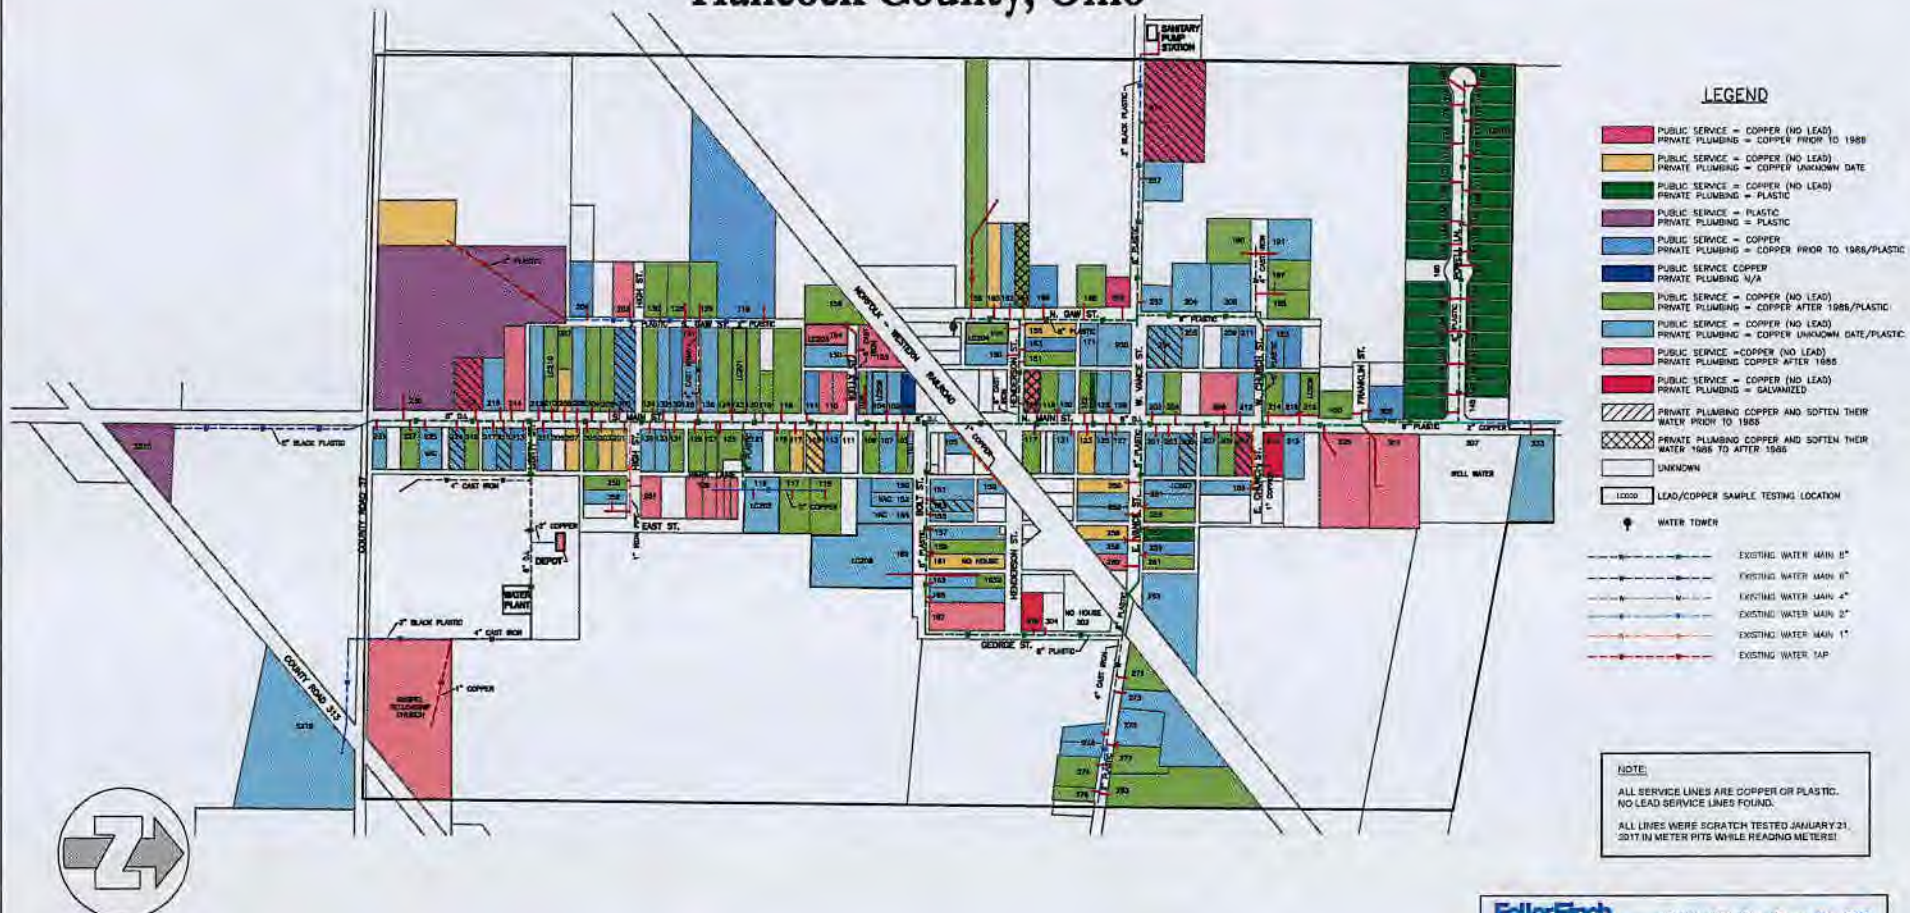

LEGEND

- PUBLIC SERVICE = COPPER (NO LEAD)
PRIVATE PLUMBING = COPPER PRIOR TO 1988
- PUBLIC SERVICE = COPPER (NO LEAD)
PRIVATE PLUMBING = COPPER UNKNOWN DATE
- PUBLIC SERVICE = COPPER (NO LEAD)
PRIVATE PLUMBING = PLASTIC
- PUBLIC SERVICE = PLASTIC
PRIVATE PLUMBING = PLASTIC
- PUBLIC SERVICE = COPPER
PRIVATE PLUMBING = COPPER PRIOR TO 1988/PLASTIC
- PUBLIC SERVICE = COPPER
PRIVATE PLUMBING = N/A
- PUBLIC SERVICE = COPPER (NO LEAD)
PRIVATE PLUMBING = COPPER AFTER 1988/PLASTIC
- PUBLIC SERVICE = COPPER (NO LEAD)
PRIVATE PLUMBING = COPPER UNKNOWN DATE/PLASTIC
- PUBLIC SERVICE = COPPER (NO LEAD)
PRIVATE PLUMBING = COPPER AFTER 1988
- PUBLIC SERVICE = COPPER (NO LEAD)
- PRIVATE PLUMBING COPPER AND SOFTEN THEIR WATER PRIOR TO 1988
- PRIVATE PLUMBING COPPER AND SOFTEN THEIR WATER 1988 TO AFTER 1988
- UNKNOWN
- LEAD/COPPER SAMPLE TESTING LOCATION
- WATER TOWER
- EXISTING WATER MAIN 8"
- EXISTING WATER MAIN 6"
- EXISTING WATER MAIN 4"
- EXISTING WATER MAIN 2"
- EXISTING WATER MAIN 1"
- EXISTING WATER TAP

NOTE:
ALL SERVICE LINES ARE COPPER OR PLASTIC.
NO LEAD SERVICE LINES FOUND.
ALL LINES WERE SCRATCH TESTED JANUARY 21, 2017 IN METER PITS WHILE READING METERS!



FellerFinch & ASSOCIATES, INC.
Engineers • Surveyors
1683 Woodlands Drive, Maumee, Ohio 43537
Phone: (419) 883-2680
Fax: (419) 883-2592
www.fellerfinch.com
DATE: 2-23-17 PROJECT NO. 10P05233