

RE: Bellevue City  
Report  
Drinking Water Program  
Huron County  
PWS ID: OH3900011



TO: Janis D'Amico  
Ohio EPA  
Northwest District Office  
347 N. Dunbridge Rd. 43402

From: Bellevue Water Department  
830 E. Center St.  
Bellevue, OH 44811

**RECEIVED**

**MAR 06 2017**

OHIO E.P.A.  
N.W.D.O.

2/272017

Included is a copy of the lead mapping for the City of Bellevue.


Sincerely,

Chris Sallee/Bellevue Water Supt.  
419-484-5520



Buildings in Ohio built prior to 1998 or that use plumbing material or solder manufactured before 1998 may have materials with greater than 8% lead and are at a higher risk of contributing lead to the drinking water than materials manufactured after 1998. In addition, buildings built and plumbing materials manufactured after 2014 were required to have less than 0.25% lead by weight and have the lowest risk for contributing lead to the drinking water. It should be noted however that, although prohibited, some use of leaded solder or leaded components may have occurred after the prohibitions became effective.

There are thick yellow lines marked on this distribution map signifying the potential for the possibility of lead service lines. All records of the City of Bellevue indicate that there are no lead water service lines in the city. However, considering the age of certain water lines around town, as well as studying tap records of past service lines, the yellow lines represent areas of the city where lead service lines may be found. If map is not indicated yellow, it is an area of town where there are copper service lines, and it has been the City of Bellevue's policy to use mechanical joints, not solder, to deliver potable water to homes and businesses.

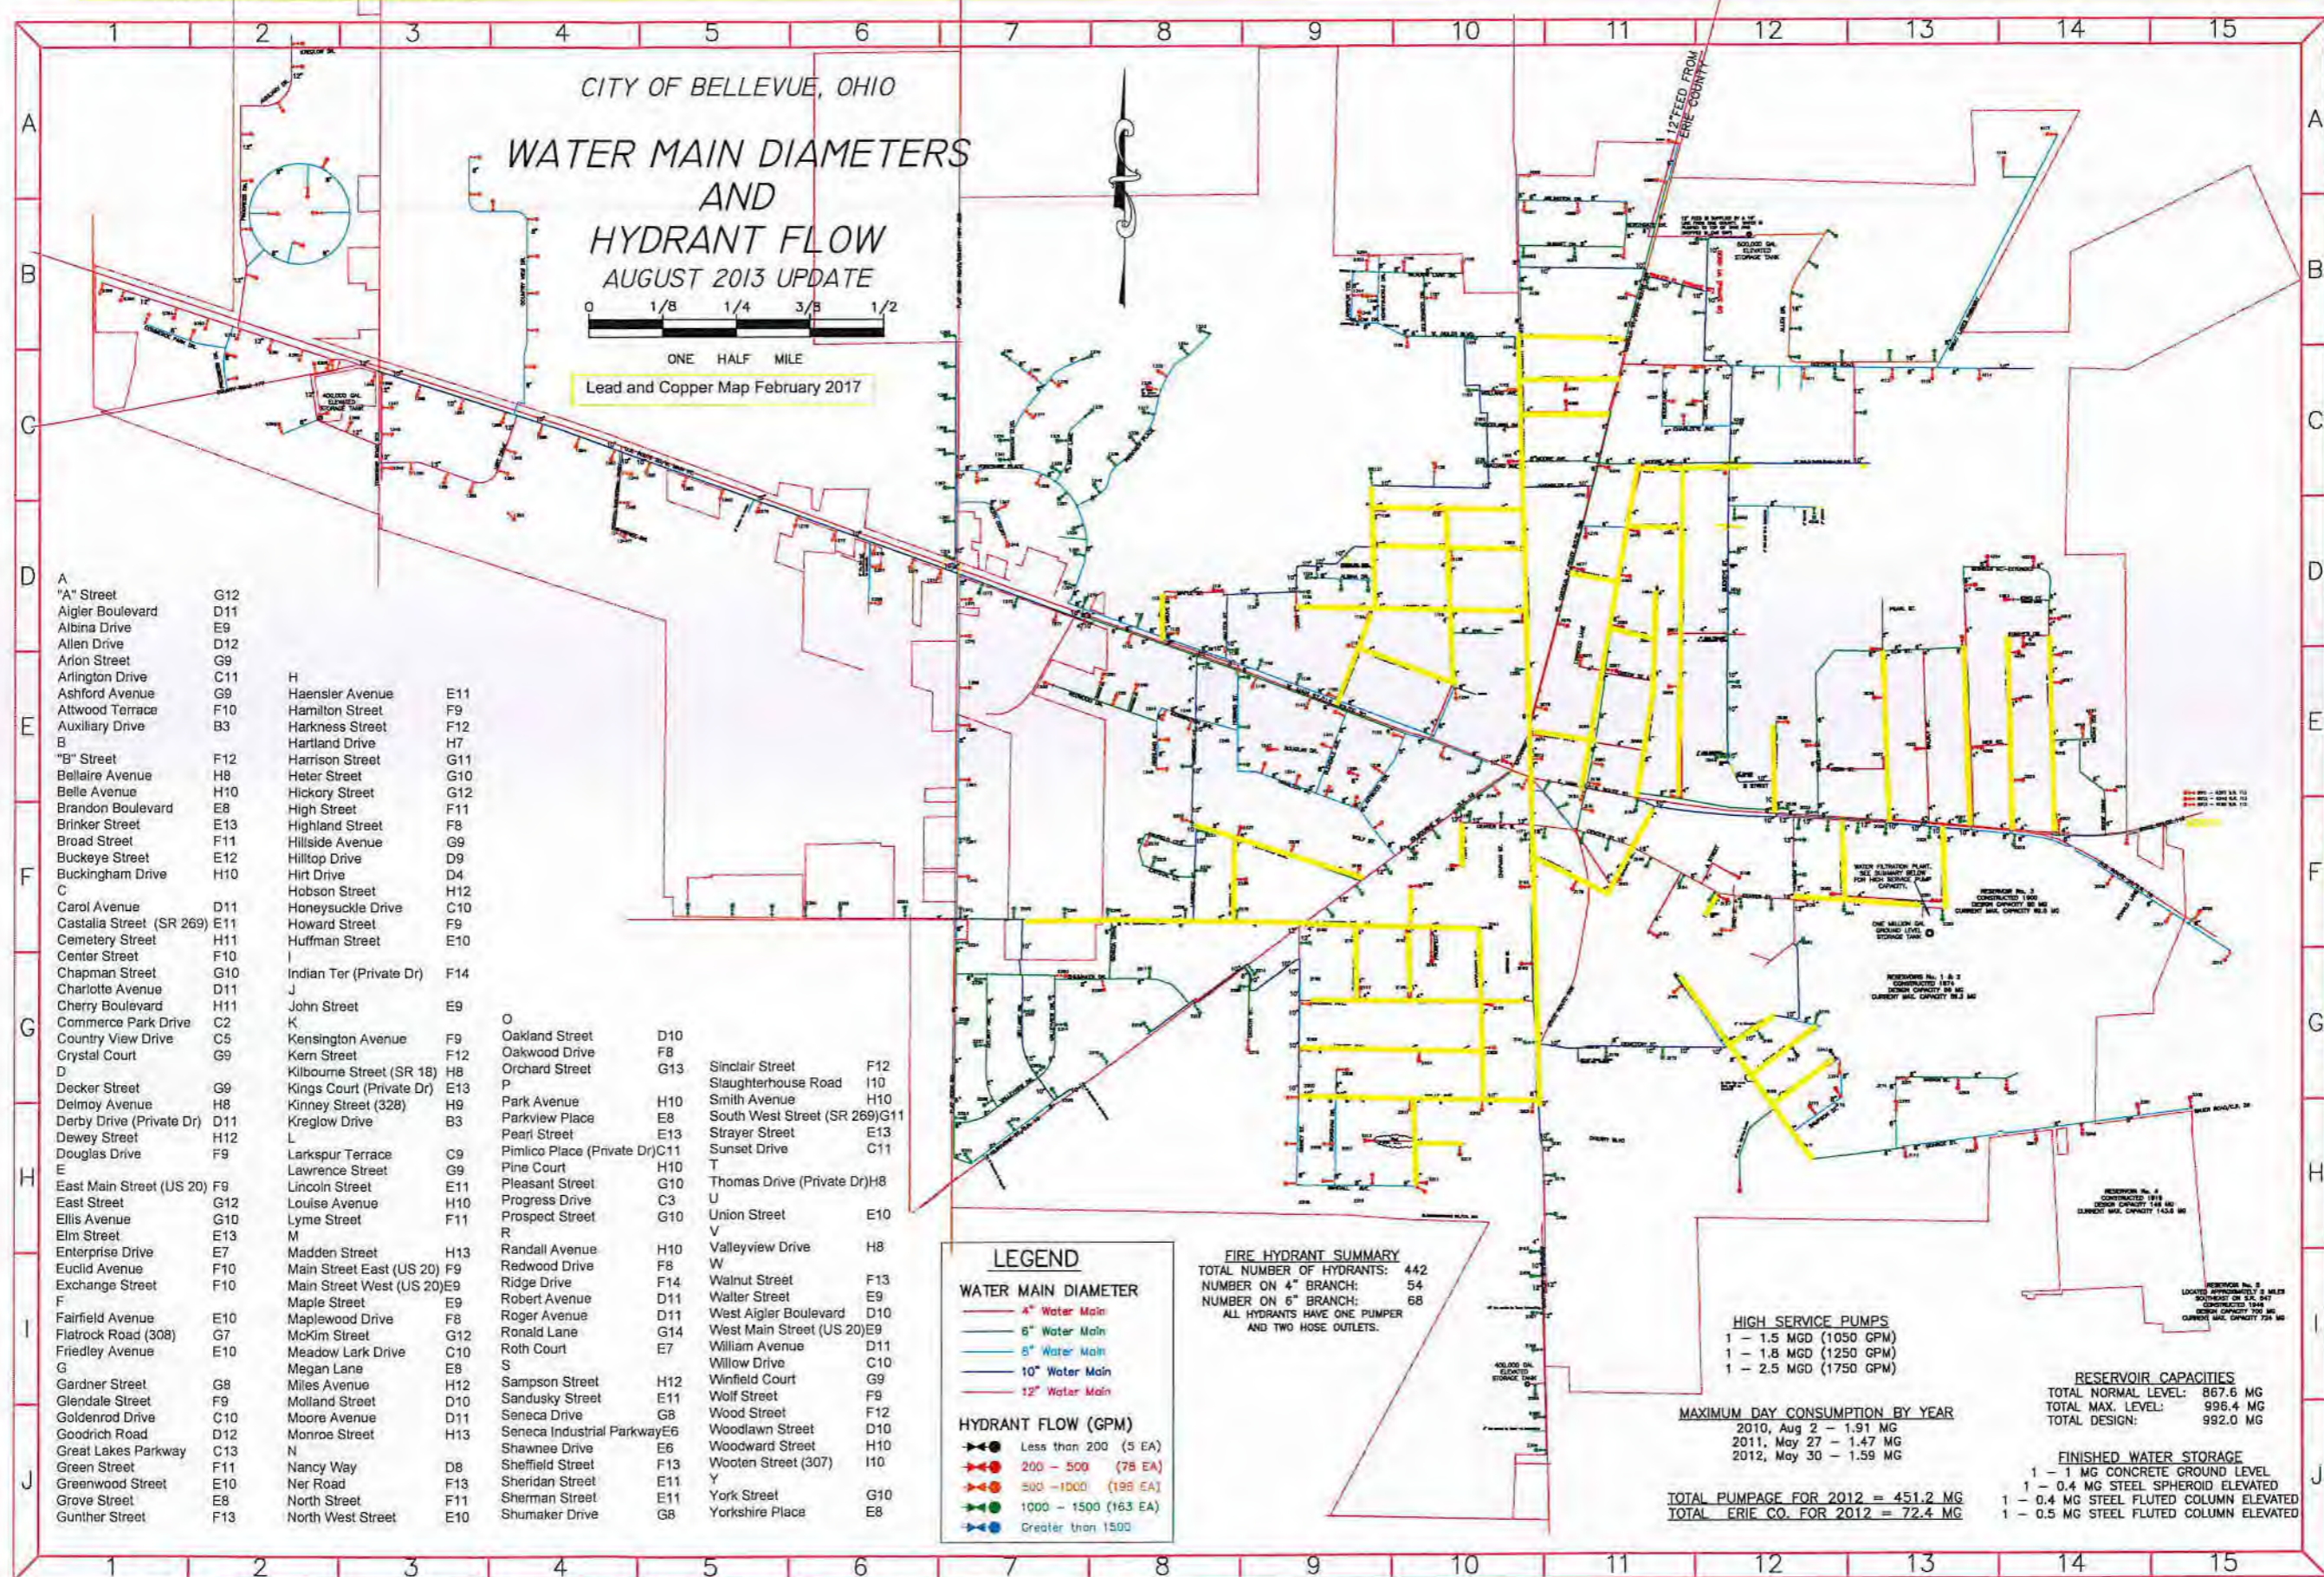

**RECEIVED**  
MAR 06 2017  
OHIO E.P.A.  
N.W.D.O.