



Entity: HARTVILLE ELEMENTARY
 Doc Type: REPORT
 Doc Subtype:
 Program: DRINKING WATER
 Secondary ID: 0K7654612

RECEIVED
 MAR 06 2017

BY:

Hartville Elementary

Lake Local School District
 Hartville Elementary
 245 Belle Street
 Hartville, OH 44632
 330.877.4278




sink



Drinking Fountain

/ 047654612

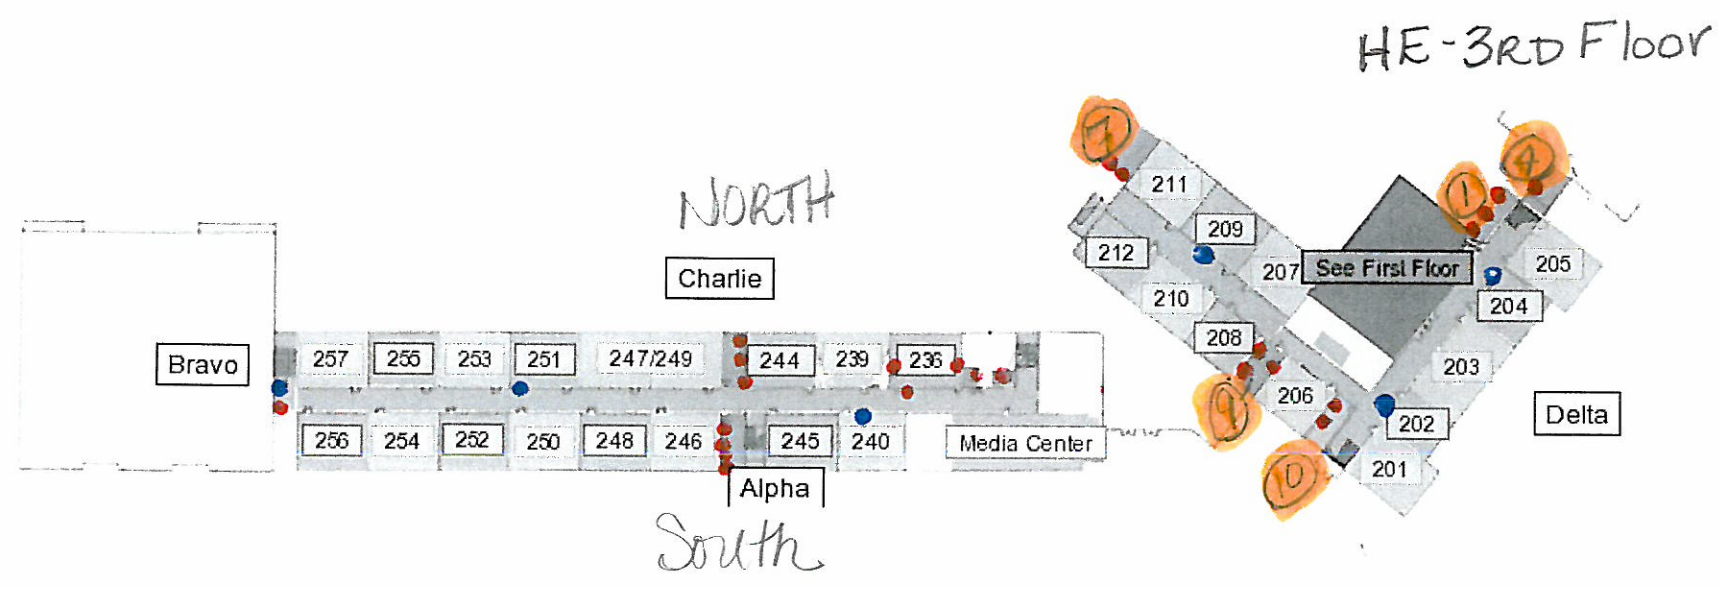

047654512
 Lake/Hartsville Elementary 2nd floor
 047654612

Lake Local School District
 Lake Elementary School
 225 Lincoln Street
 Hartsville, OH 44632
 330.877.4276




- Sink
- Drinking Fountain

04 7654612
 Lake / Hartville Elementary - 1st floor
 04 7654512

Lake Local School District
 Lake Elementary School
 225 Lincoln Street
 Hartville, OH 44632
 330.877.4276