


Google Maps

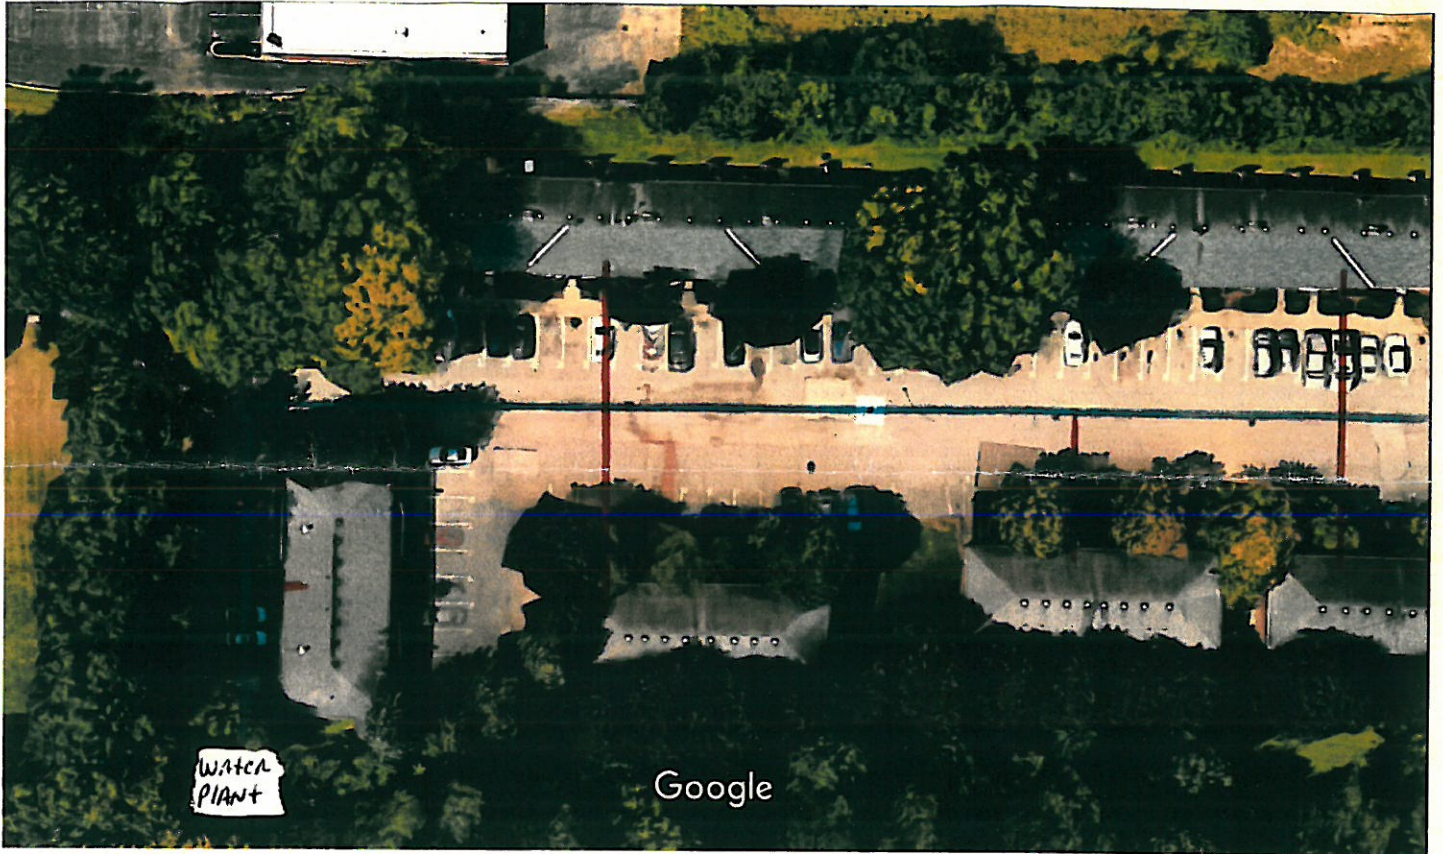

Imagery ©2017 Google, Map data ©2017 Google 20 ft

↑
N
↑

- █ - Water main 4" Ductile Iron
- █ - Service lines 2" Ductile Iron

OH- 670 4012

Built in - 1969

Woodland Pointe town houses
 4474 SR 43
 Kent Ohio 44240

MARK.Boettler@gmail.com

Entity: _____
 Doc Type: Report
 Doc Subtype: _____
 Program: DPAGW
 County: Putah
 Secondary ID: OH 6782712 OH6704012
 • edac in color

RECEIVED
 FEB 03 2017

BY: