

RE: Glandorf Village
Report
Drinking Water Program
Putnam County
PWS ID: OH6901303

Village of Glandorf
Utilities Department
203 N. Main Street, P.O. Box 91
Glandorf, OH 45848
(419) 538-6140

March 3, 2017

Ohio Department of Health
Attn: Lead Program, 6th Floor
246 North High Street
Columbus, OH 43215

RECEIVED

MAR 06 2017

OHIO E.P.A.
N.W.D.O.

To Whom it May Concern:

Enclosed is a map of the Village of Glandorf, showing the distribution system to identify areas that are known or likely to contain lead service lines. This map was created to meet the guidelines set up by the Environmental Protection Agency (EPA), House Bill 512.



If you have questions please contact the Village of Glandorf at (419)538-6140 or email us at glandorfutilities@bright.net.

Sincerely,

Board of Public Affairs

Mayor Eugene Warnecke
Chris Recker
Doug Trombley
Tom Schroeder

VILLAGE OF GLANDORF

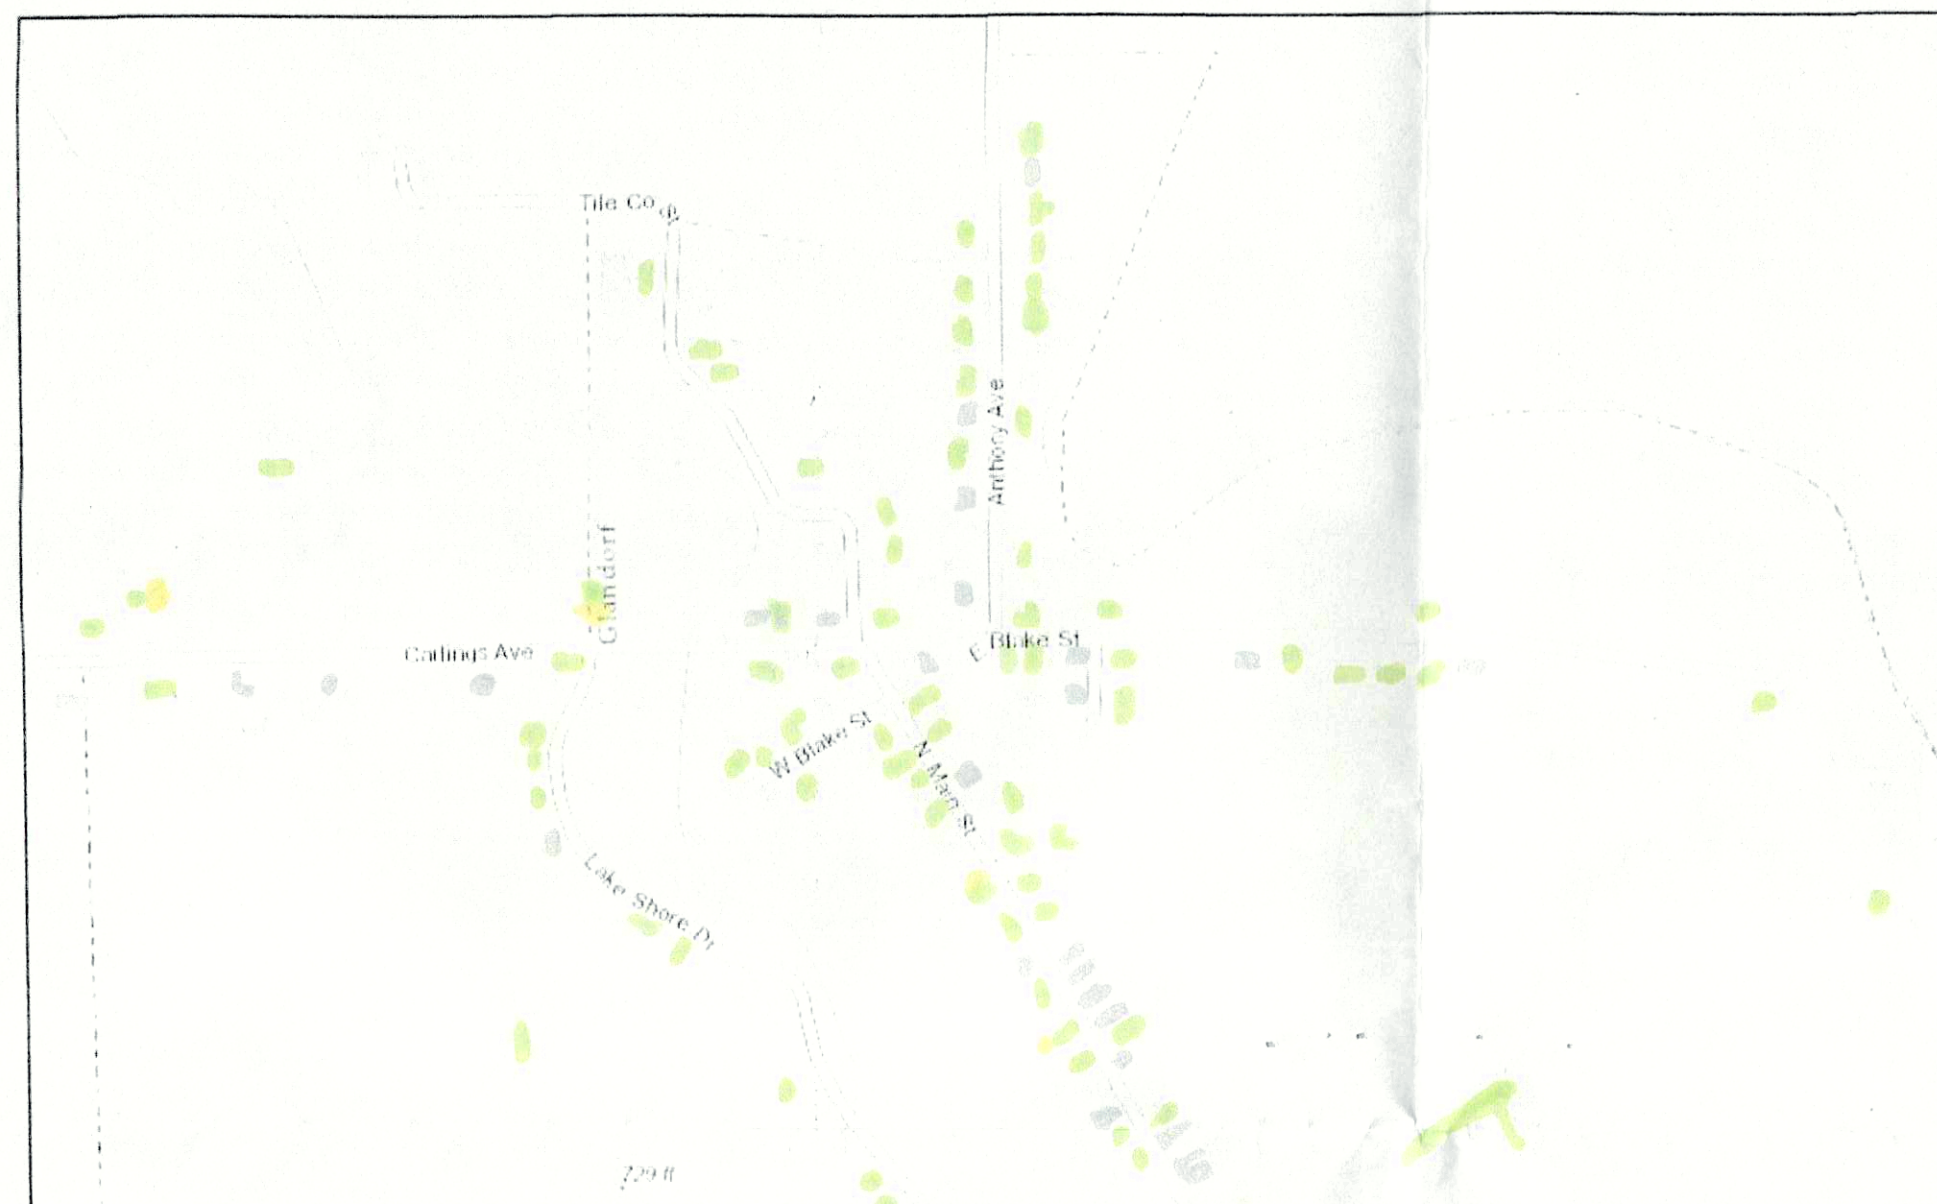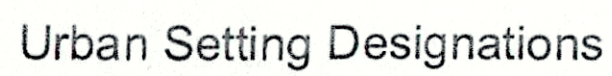

All Main Water Lines
are PVC Plastic.

All Service Lines to
Homes are Plastic.


Color Code for Lines in Homes

Lead =


Non-Lead =

No Information =

* Some homes have both  

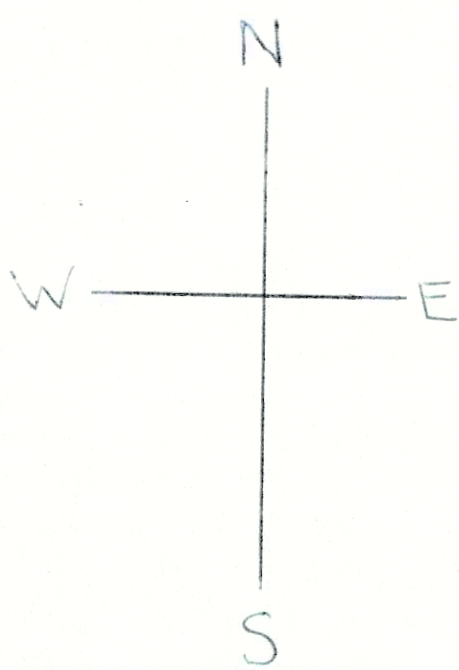

February 8, 2017

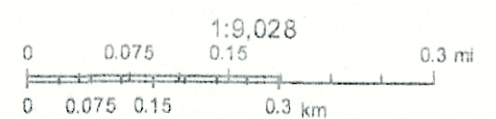

Sources: ERI, HERE, DeLone, Intermap, increment P Corp., GEBCO, USGS, FAO, NPS, NRCAN, GeoBase, IGN, Kadaster NL, Ordnance Survey,

Ohio EPA
Division of Environmental Response and Revitalization

RECEIVED
MAR 06 2017
OHIO E.P.A.
N.W.D.O.