

RE: Vanlue Village
Report
Drinking Water Program
Hancock County
PWS ID: OH3248312

PWS ID#: OH3248312

Narrative for Lead for the Village of Vanlue, Ohio

RECEIVED

MAR 06 2017

OHIO E.P.A.
N.W.D.O.

The Village of Vanlue installed their public water system in 2010. All of our water mains are PVC plastic and service lines are copper. Water mains are depicted on the map in black bold lines. We have included the form necessary to document this.

All of the Village streets are labeled in black bold lettering.

Through research of building permits and subdivisions, we have determined the approximate date of construction of all homes and buildings.

The map has the background of the different areas shaded to depict dates of construction.

Gray background shade: Areas constructed pre 1998

Yellow background shade: Areas constructed 1998 - 2014

Green background shade: Areas constructed in 2014 - present.

The gray shaded areas may contain over 8% lead in home plumbing.

The yellow shaded areas contain no lead service lines but buildings within may have plumbing materials or solder contain 8% or less lead by weight.

The green shaded areas contain no lead service lines and buildings within have plumbing materials or solder containing .25% or less lead by weight.

A copy of our Lead and Copper sample monitoring point ID's (SMP ID) is included with this map. As well as the Verification Form for Community Public Water Systems Claiming No Lead Service Lines.

RECEIVED

MAR 06 2017

OHIO E.P.A.
N.W.D.O.

**VERIFICATION FORM FOR COMMUNITY PUBLIC WATER SYSTEMS
CLAIMING NO LEAD SERVICE LINES**

The owner or operator of all community public water systems must identify and map areas of their distribution system that are known or are likely to contain lead service lines. Systems must submit a copy of the applicable map to the Ohio Department of Health and the Ohio Department of Job and Family Services. Systems must also submit a report to the director containing at least both of the following: (1) The applicable map with narrative, and (2) A list of sampling locations used to collect samples as required by Ohio Revised Code (ORC) Section 6109.121 and any rules adopted thereunder, including contact information for the owner and occupant of each sampling site.

Should a water system determine no lead service lines exist in their distribution system, they must provide information stating they reviewed, at the minimum, historical permit records and local ordinances, distribution maintenance records and information pertaining to installation dates or materials for all services lines. This information must be verified below.

I HEREBY CERTIFY THAT THE FOLLOWING METHOD(S) WERE USED TO DETERMINE NO LEAD SERVICE LINES EXIST IN THIS WATER SYSTEM'S DISTRIBUTION SYSTEM, AS REQUIRED BY ORC 6109.121(F):

LEAD SERVICE LINE VERIFICATION

This PWS states they have no lead service lines and has reviewed the following information (select one or more of the following):


- ☐ Historical permit records and/or local ordinances
- ☐ Distribution maintenance records (i.e. meter replacement, waterline break repairs)
- ☐ Information pertaining to installation dates for all service lines (i.e. after 1986 when lead services lines were banned)
- ☒ Service line material of all service lines is known (i.e. all service lines are known to be PVC)

Rebecca J. Lloyd 3/2/17
Signature of Responsible Person Date
Rebecca J. Lloyd, President BPA
Printed Name and Title of Responsible Person

PWS NAME: Vanue Village
PWS ID: OH 3248312
COUNTY: Hancock

For Ohio EPA use only:

Date Verification Rec'd: _____

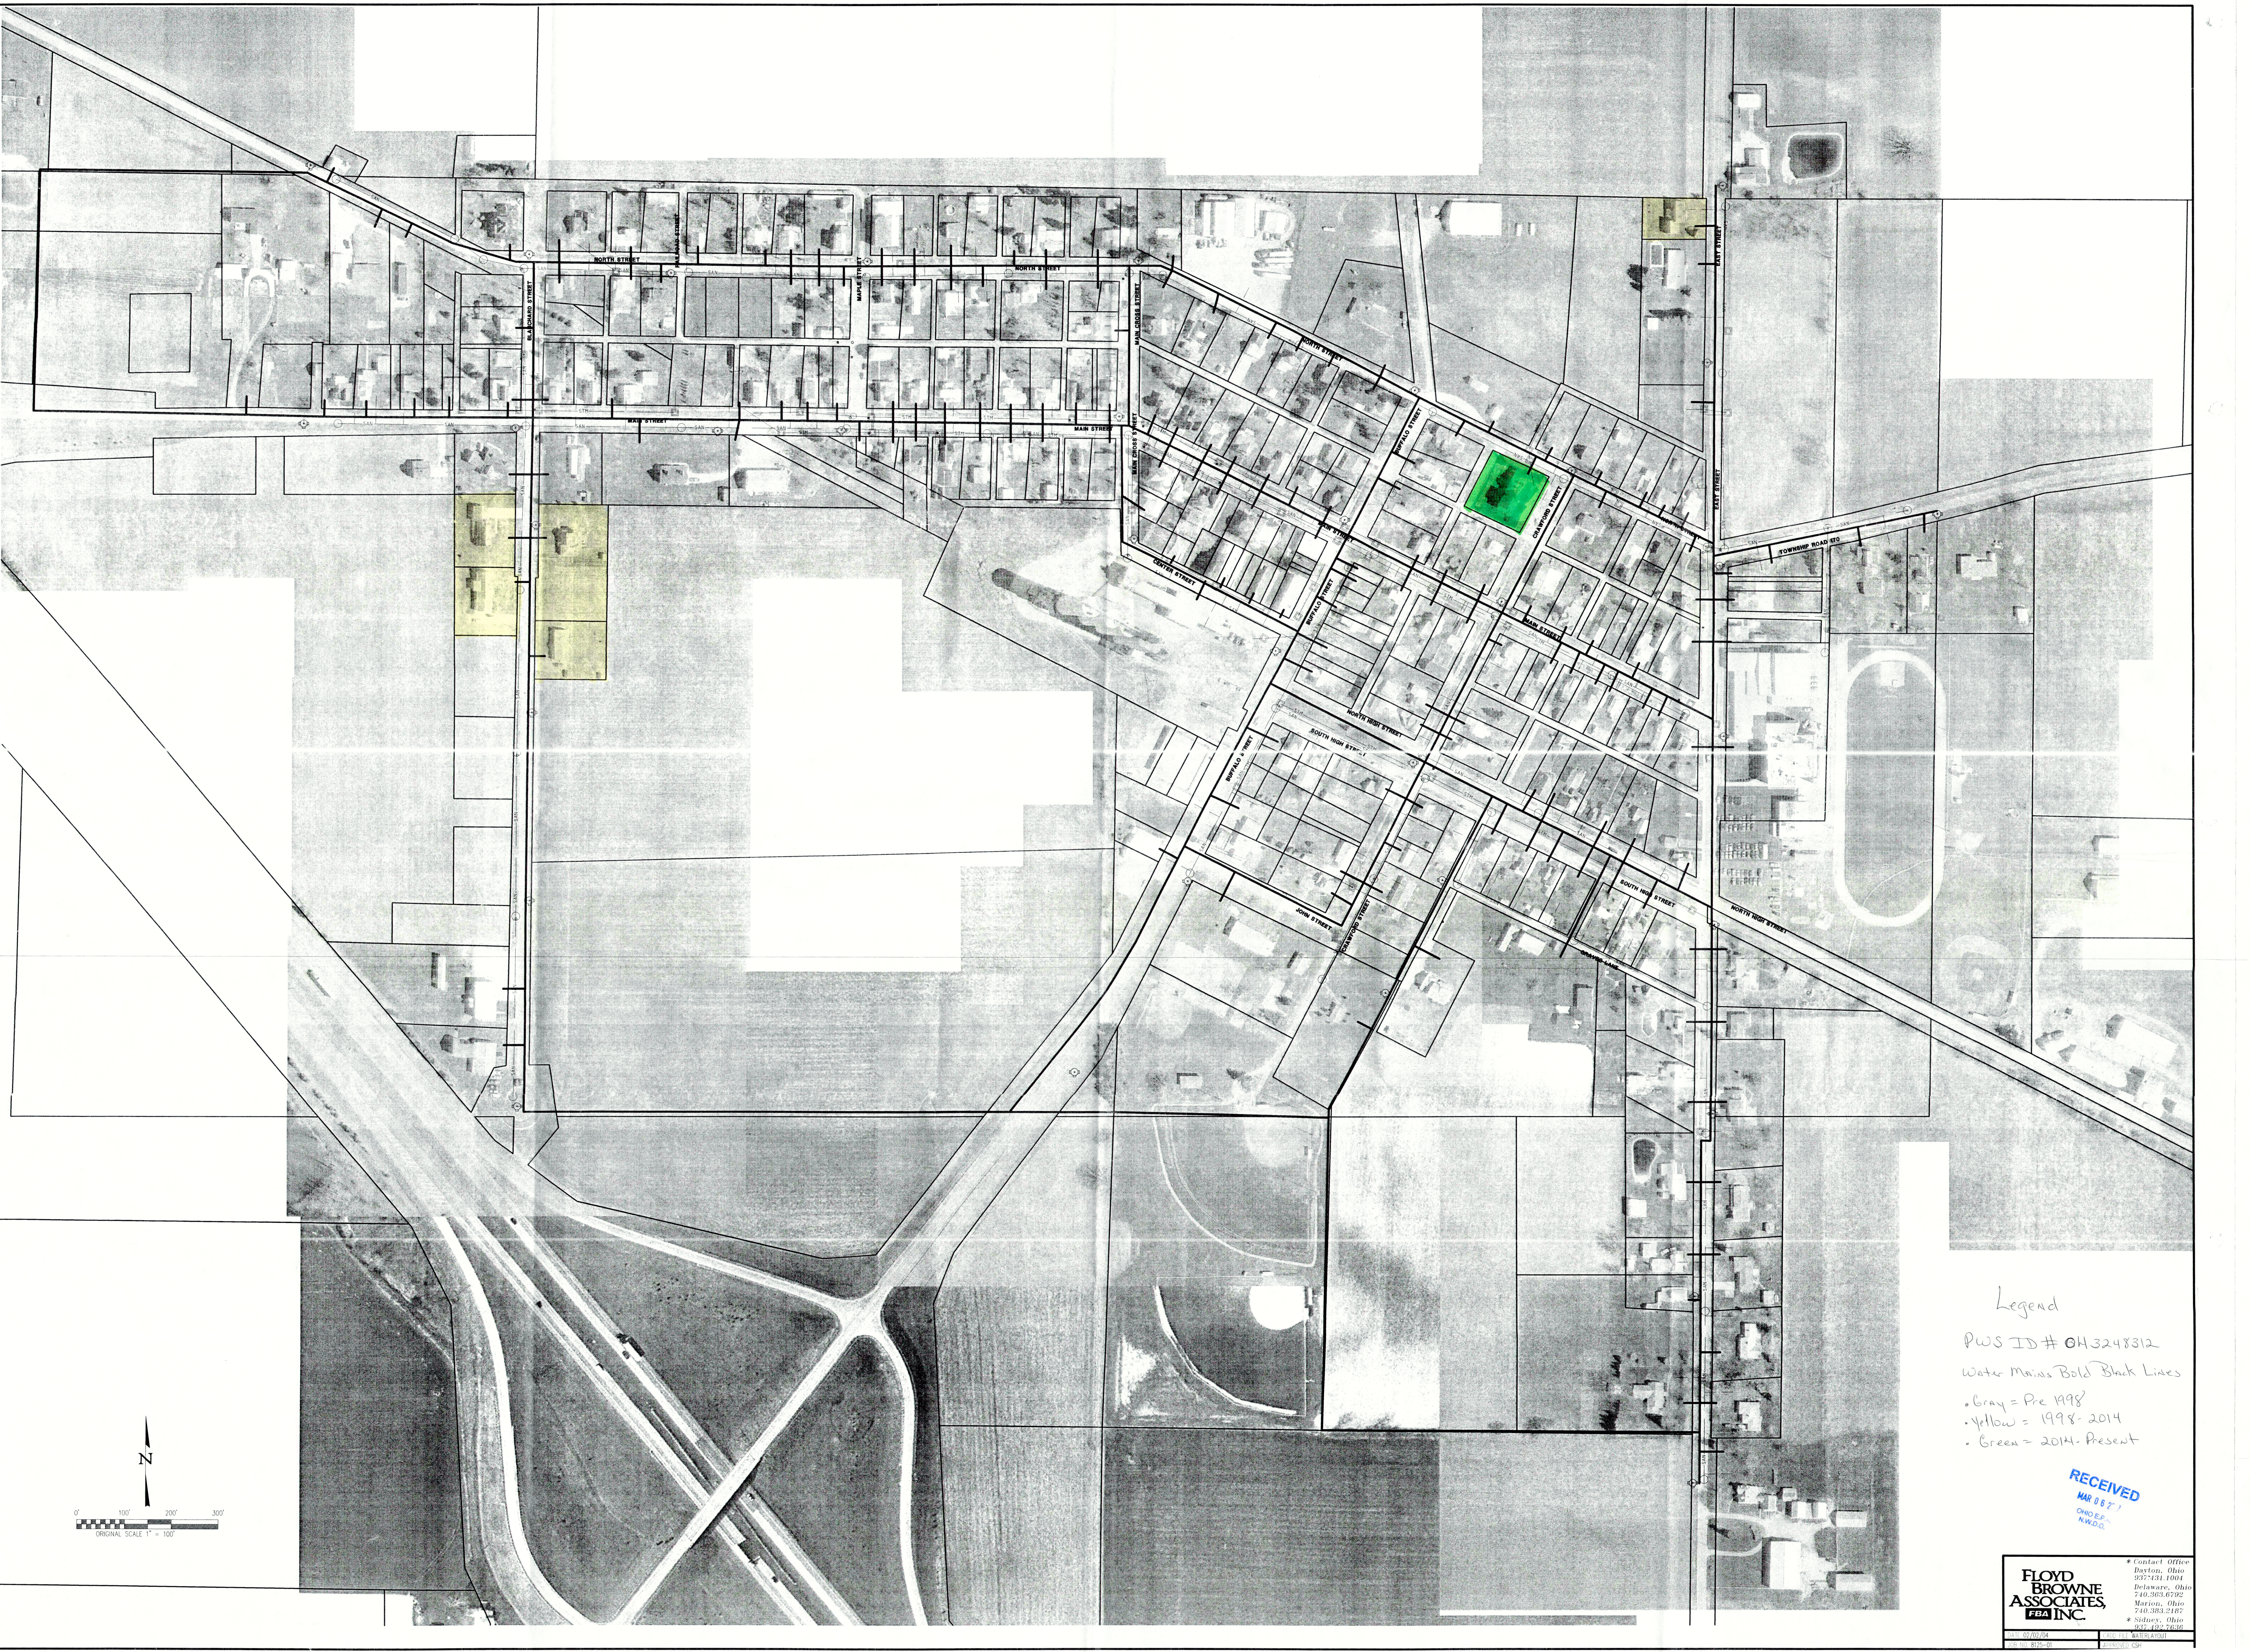

Legend

- PWS ID # OH3248312
- Water Mains Bold Black Lines
- Gray = Pre 1998
 - Yellow = 1998-2014
 - Green = 2014- Present

RECEIVED
MAR 06 2017
OHIO E.P.
N.W.D.O.

FLOYD BROWNE ASSOCIATES, INC.

* Contact Office
Dayton, Ohio
937-2311 1004
Delaware, Ohio
740-303-6792
Marion, Ohio
740-393-2187
* Sidney, Ohio

DATE: 07/02/04
BY: J. WATSLAY
FOR: 8025-00
PROJECT: CSP