

2017 MAR -7 AM 9:52

**Village of Pomeroy**  
**Public Works Department**

March 6, 2017

Ohio EPA Southeast District Office  
2195 Front Street  
Logan, Ohio 43138-8637

RE: Lead Mapping Report for Pomeroy, OH

cc: DDAGW, Eric Hart; Ohio Department of Health; Ohio Department of Job and Family Services

To whom it may concern,

The Village of Pomeroy has completed the required detailed map. This map does indicate areas that lead services are likely supplying residences and businesses. The Village of Pomeroy has made it a policy that when lead is found to remove it from the main to the meter pit. We also do notify the customer of our findings. Though there are a few areas that do not have lead due to newer construction, the majority of structures in Pomeroy were constructed pre-1983. With that being, said the possibility of lead soldered joints in copper plumbing is highly likely. I have also attached our sample monitoring point locations also. If you have any further questions or concerns feel free to contact me at the information given below.

Sincerely,

Joe Woodall

Village of Pomeroy Administrator  
660 E. Main St.  
Pomeroy, OH 45769  
Phone: 740-508-0927 email: joseph.woodall@rocketmail.com

# Water Infrastructure

## The Village of Pomeroy, Meigs County, Ohio

0 0.5 1 Miles

Parcels and Corp Line Courtesy of the Meigs County Tax Map Office  
Points and Water Line Collected and Generated by Buckeye Hills  
Map Created by Jason Pyles, September 2011




  
**Buckeye Hills - Hocking Valley**  
Regional Development District

Lead Sm Ps

2017 MAR -7 AM 9:52


5:11:11

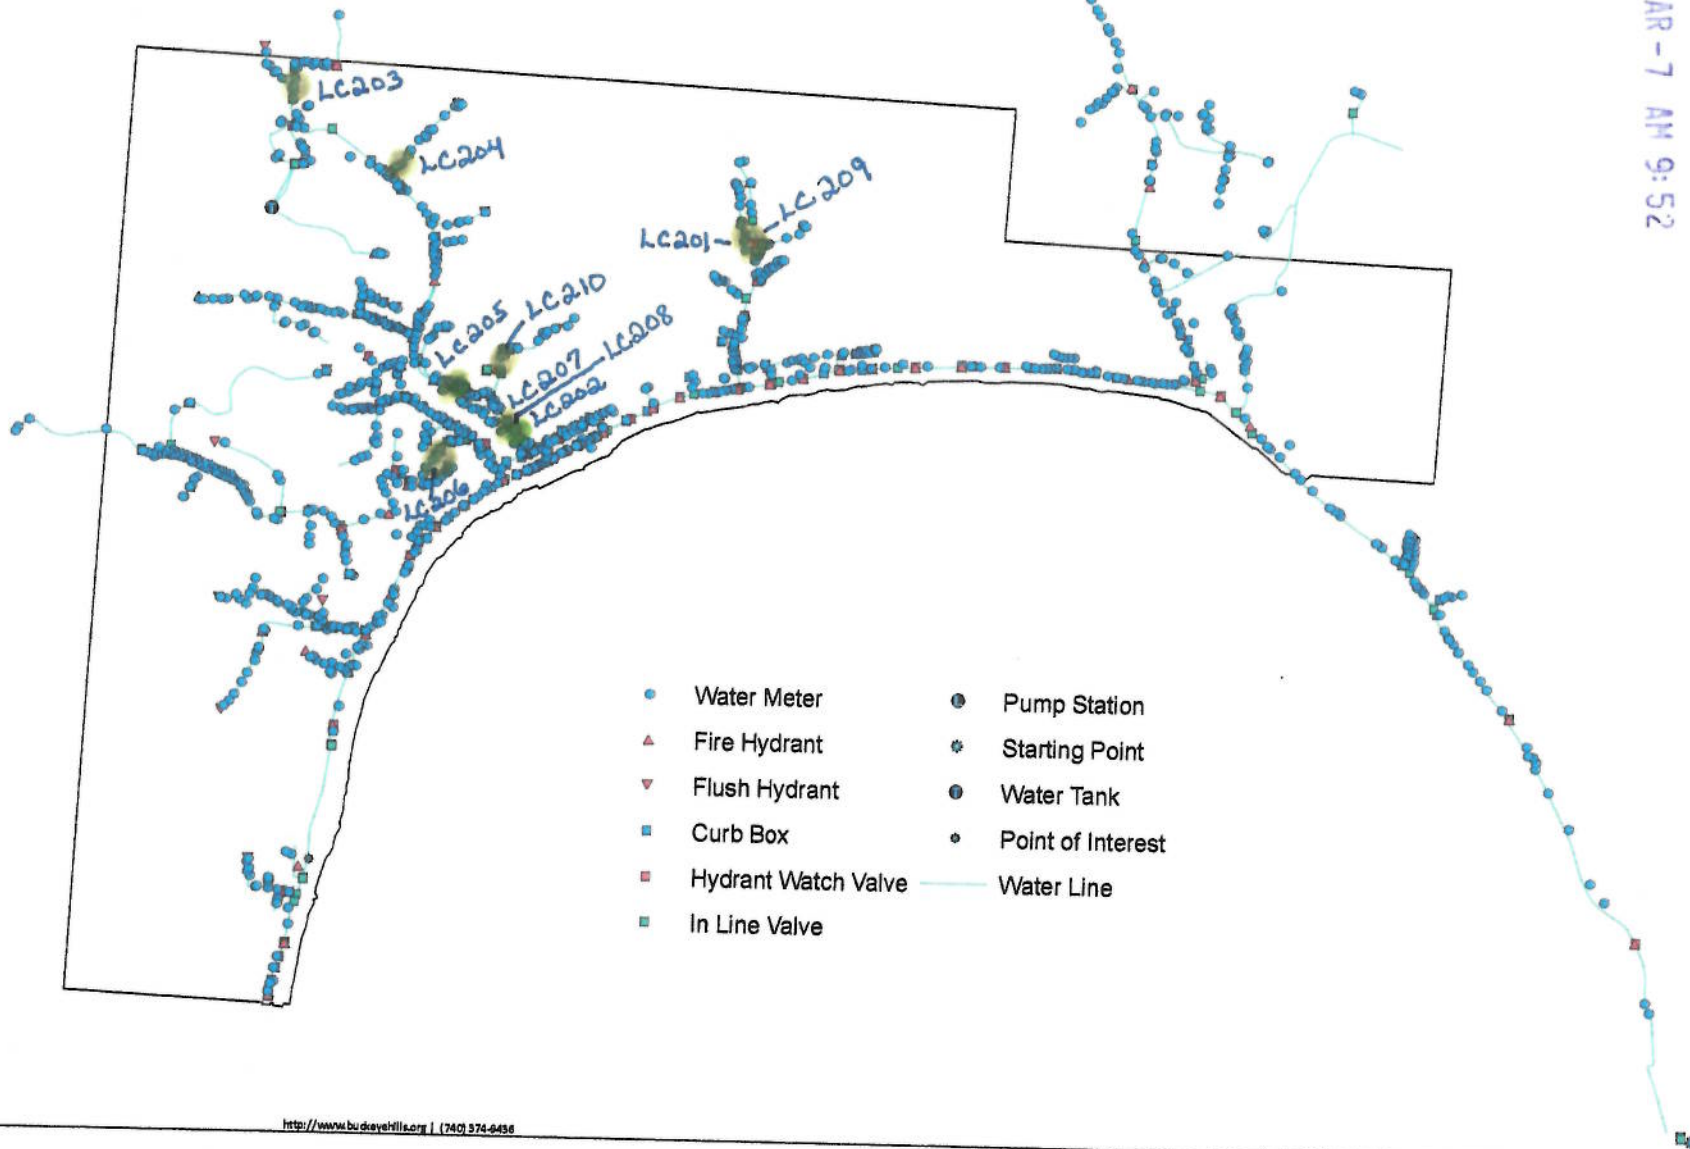



0 0.5 1 Miles

Parcels and Corp Line Courtesy of the Meigs County Tax Map Office  
Points and Water Line Collected and Generated by Buckeye Hills  
Map Created by Jason Pyles, September 2011

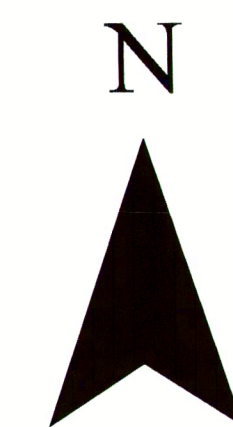

  
**Buckeye Hills - Locking Valley**  
Regional Development District

