

OH 52 01/11

RECEIVED

MAR 03 2017

OHIO EPA NEDO

Spencer Board of Public Affairs
109 North Main Street
P.O. Box 336
Spencer Ohio, 44275
330-648-2907

Date: January 18, 2017

Dear OEPA,

This letter is reference to the OHB-512. We do not have any lead service lines. We determined this by the installation of new water meters in 2010 and we found no lead services.


Thank you,
Jim Ramsey
Superintendent of Spencer Village Water and Sewer Department

Entity: Spencer Village
Doc Type: Report
Doc Subtype: _____
Program: DDAGW
County: medina
Secondary ID: OH 52 01/11
eTJC in color

Lead & Copper
 Site Map

No Tice 1 sites
 all 2+3 sites
 all service
 Copper Out one.

line art

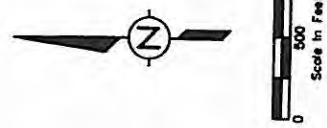

WATER DISTRIBUTION MAP


BACTERIA SAMPLING SITES

VILLAGE OF SPENCER, OHIO

LEGEND

	2" Water Main
	4" Water Main
	6" Water Main
	8" Water Main
	Corporation Limit
	Well
	Structure

Green - galv.
 Yellow - Copper

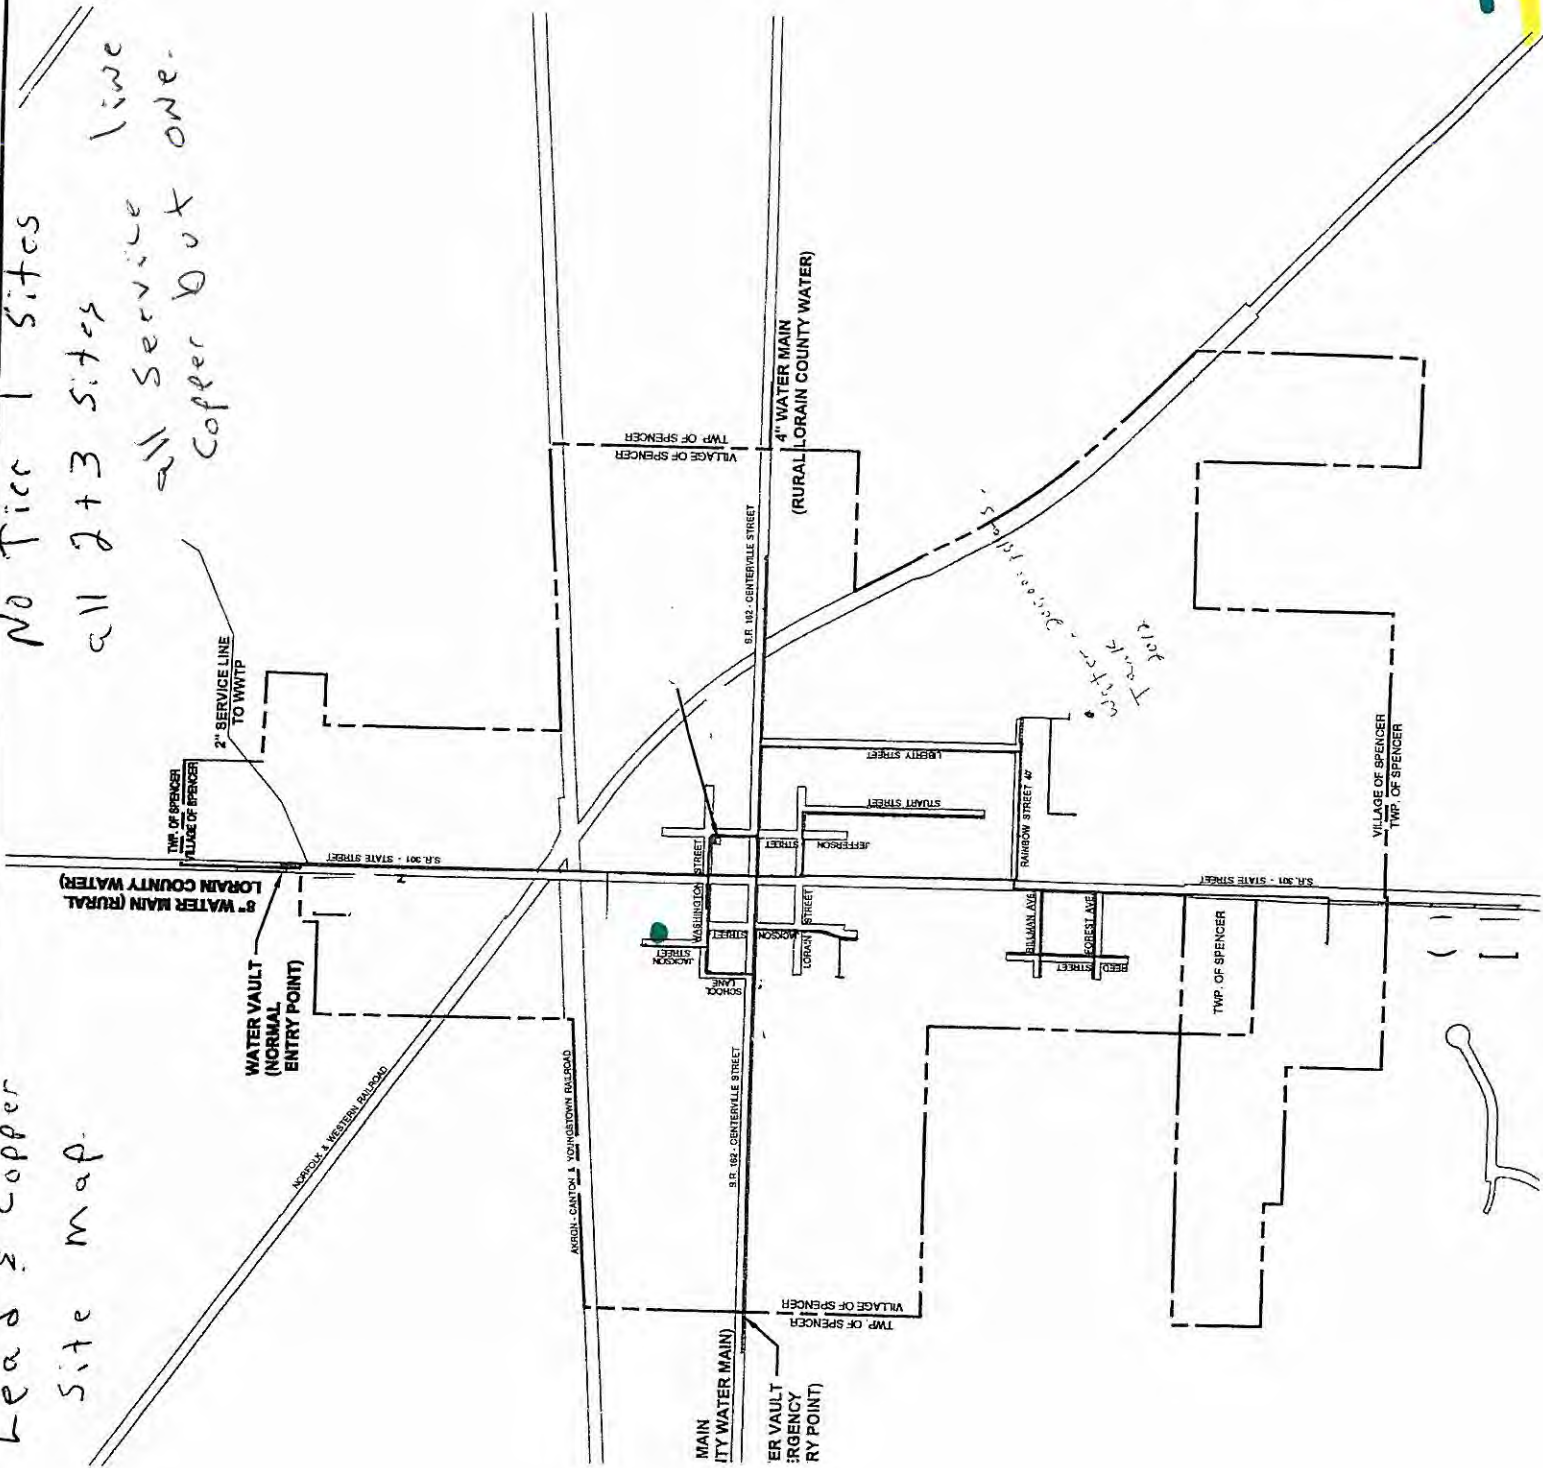

Water - Spencer Twp