



- X = No Mobile Homes
- = Non Lead (Service Supply lines street side)
- = No Information (Privately owned Mobile Homes)
- = Sample Locations (B-12, C-10, E-9, J-19 J-39)
- = Lead

RECEIVED
FEB 23 2017
Central District Office
Ohio EPA

GUY T. & MARILYN P.
DEED VOLUME 3466, P.

WATERLINE NOTES

MATERIALS: GENERAL PURPOSE PVC PRESSURE RATED PIPE
ASTM D3034, AND SPIGOT WITH ELASTOMERIC
RING ASTM D3139.
WATER SERVICES: VERY HIGH MOLECULAR WEIGHT
POLYETHYLENE (HDPE) WATER SERVICE
TUBING (575) ASTM D2737 SPR 6.

LEAD MAPPING PWS: OH 2502912

Pleasant Acres Mobile Home Park
6106 London Groveport Road
Grove City, Ohio 43123

RECEIVED

FEB 23 2017

Central District Office
Ohio EPA

CD-991-W\$	PAID	11/14/95
Amount	\$156.00	Date
Check #	4456	Date 11/8/95



PREPARED FOR:

GALE SCOTT, JR
P.O. BOX 4205
NEWARK, OHIO 43058
(614) 345-9207

PWS:
2502912

PREPARED BY:

DPH SURVEYING, INC.


P.O. BOX 429
13875 ZION ROAD
THORNVILLE, OHIO 43076
(614) 246-4491



SEAL

PWS⁶
2502912

Dennis P. Hagan
DENNIS P HAGAN, PE
REG. NO. 51338

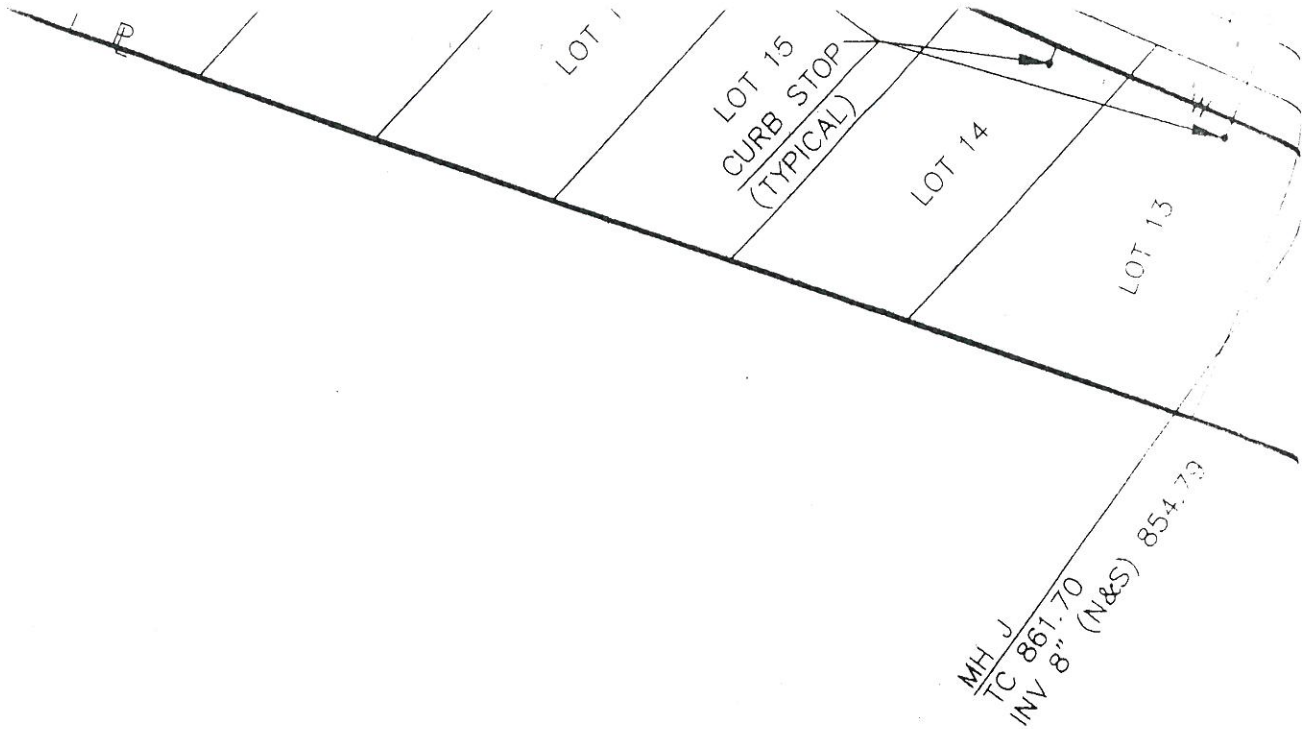

WATERLINE NOTES

MATERIALS: GENERAL PURPOSE PVC PRESSURE RATED PIPE
ASTM D2241; CLASS 200 (SDR 21).
● JOINTS; BELL AND SPIGOT WITH ELASTOMERIC
RING ASTM D3139.


● WATER SERVICES – VERY HIGH MOLECULAR WEIGHT
POLYETHYLENE PE 3408 CL 200. WATER SERVICE
TUBING (CTS) ASTM D2737 SDR 9.

PWS. 2502912

PWS ID OH2502912

This diagram is for information only!!

It represents Pleasant Acres' in ground water and supply lines servicing the mobile home lots. All in Black. Everything at and above the connection and leading into the home belongs to the individual home owner. All in White.

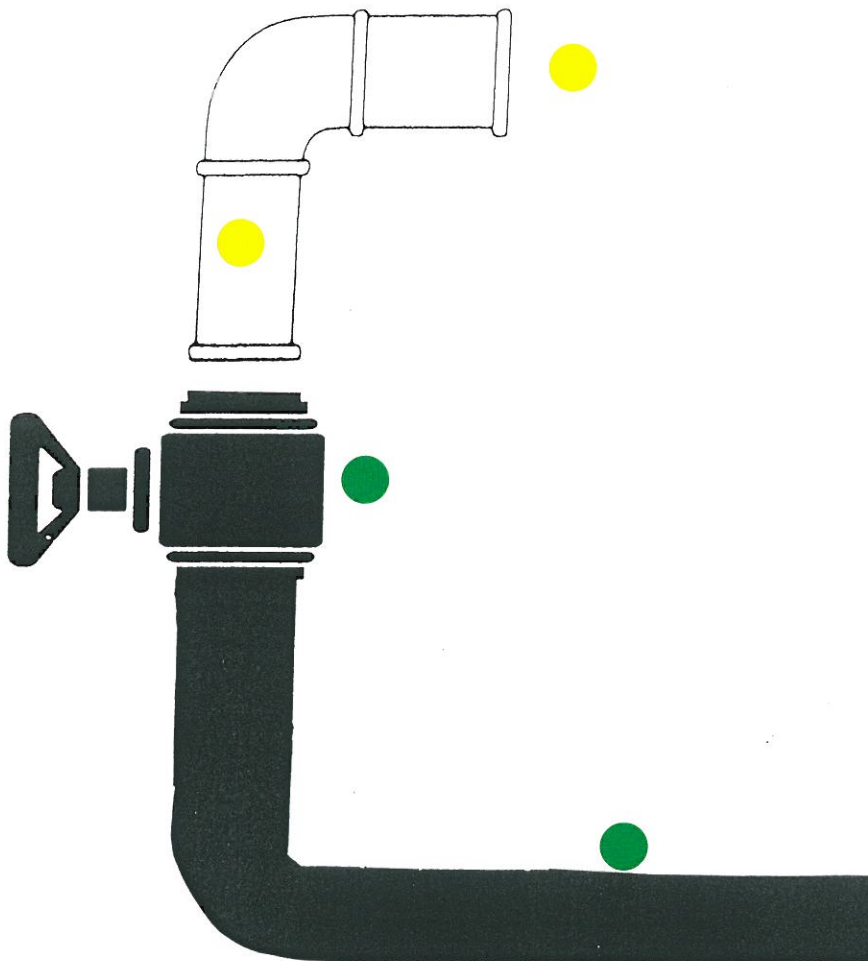

Butler Construction
P. O. Box 4054
Newark, Ohio 43058

February 16, 2017

Regarding: Pleasant Acres Trailer Park in Grove City, Ohio

To Whom It May Concern:


I am a contractor and have been for about 30 years. Before I was a licensed plumber by trade. The reason I mentioned that is because I am familiar with plumbing materials.

Around 2005-2006, we started doing work for G. Scottco. Some of that work was repairing water line breaks. We have repaired numerous water lines at Pleasant Acres.

During this time, we have repaired broken water lines throughout that park, and worked in the A, B, C, D, and E sections and on H and J Streets. We have made changes inside the parks well building when requested by EPA, and made other necessary repairs in the building.

Pleasant Acres does not have any lead lines, fixtures or solder, they have plastic.

Sincerely,

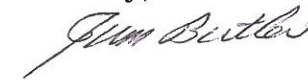


Jim Butler

PWS
2502912

Scottco Investment Company
P.O. Box 4205
Newark, Ohio 43058

CERTIFIED MAIL™

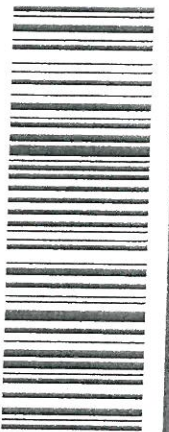


7007 2560 0002 6515 8020

Ohio Department of Job & Family
Services – Office of Family Assistance
Child Care Licensing & Monitoring
P.O. 183204 P.O. Box 183204
Columbus, Ohio 43218-3204

Scotco Investment Company
P.O. Box 4205
Newark, Ohio 43058

CERTIFIED MAIL™

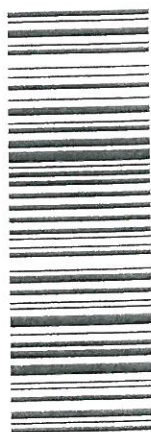

7007 2560 0002 6515 8013

Ohio Department of Health
ATT: Lead Program, 6th Floor
246 North High Street
Columbus, Ohio 43215