

United Local Elementary School
8143 State Route 9, Hanoverton OH 44423
PWS ID NUMBER 1544712

<u>Locations</u>	<u>Code</u>
Water Fountains	Blue
Lead and Copper Test Locations	Yellow
Disinfection Byproducts	Red
Chlorine CL2 Test Locations	Pink
Total Coliform Test Locations	Orange
Nitrate Test Locations	Green
Well Location	Purple

Entity: UNITED LOCAL ELEMENTARY
Doc Type: REPORT
Doc Subtype: _____
Program: DRINKING WATER
County: COLUMBIANA
Secondary ID: OH 1544712

RECEIVED



MAR 06 2017

OHIO EPA REGION 5

VOAG

23 22
STADIUM

United Elementary School
PWS ID NO. 1544712
West Playground

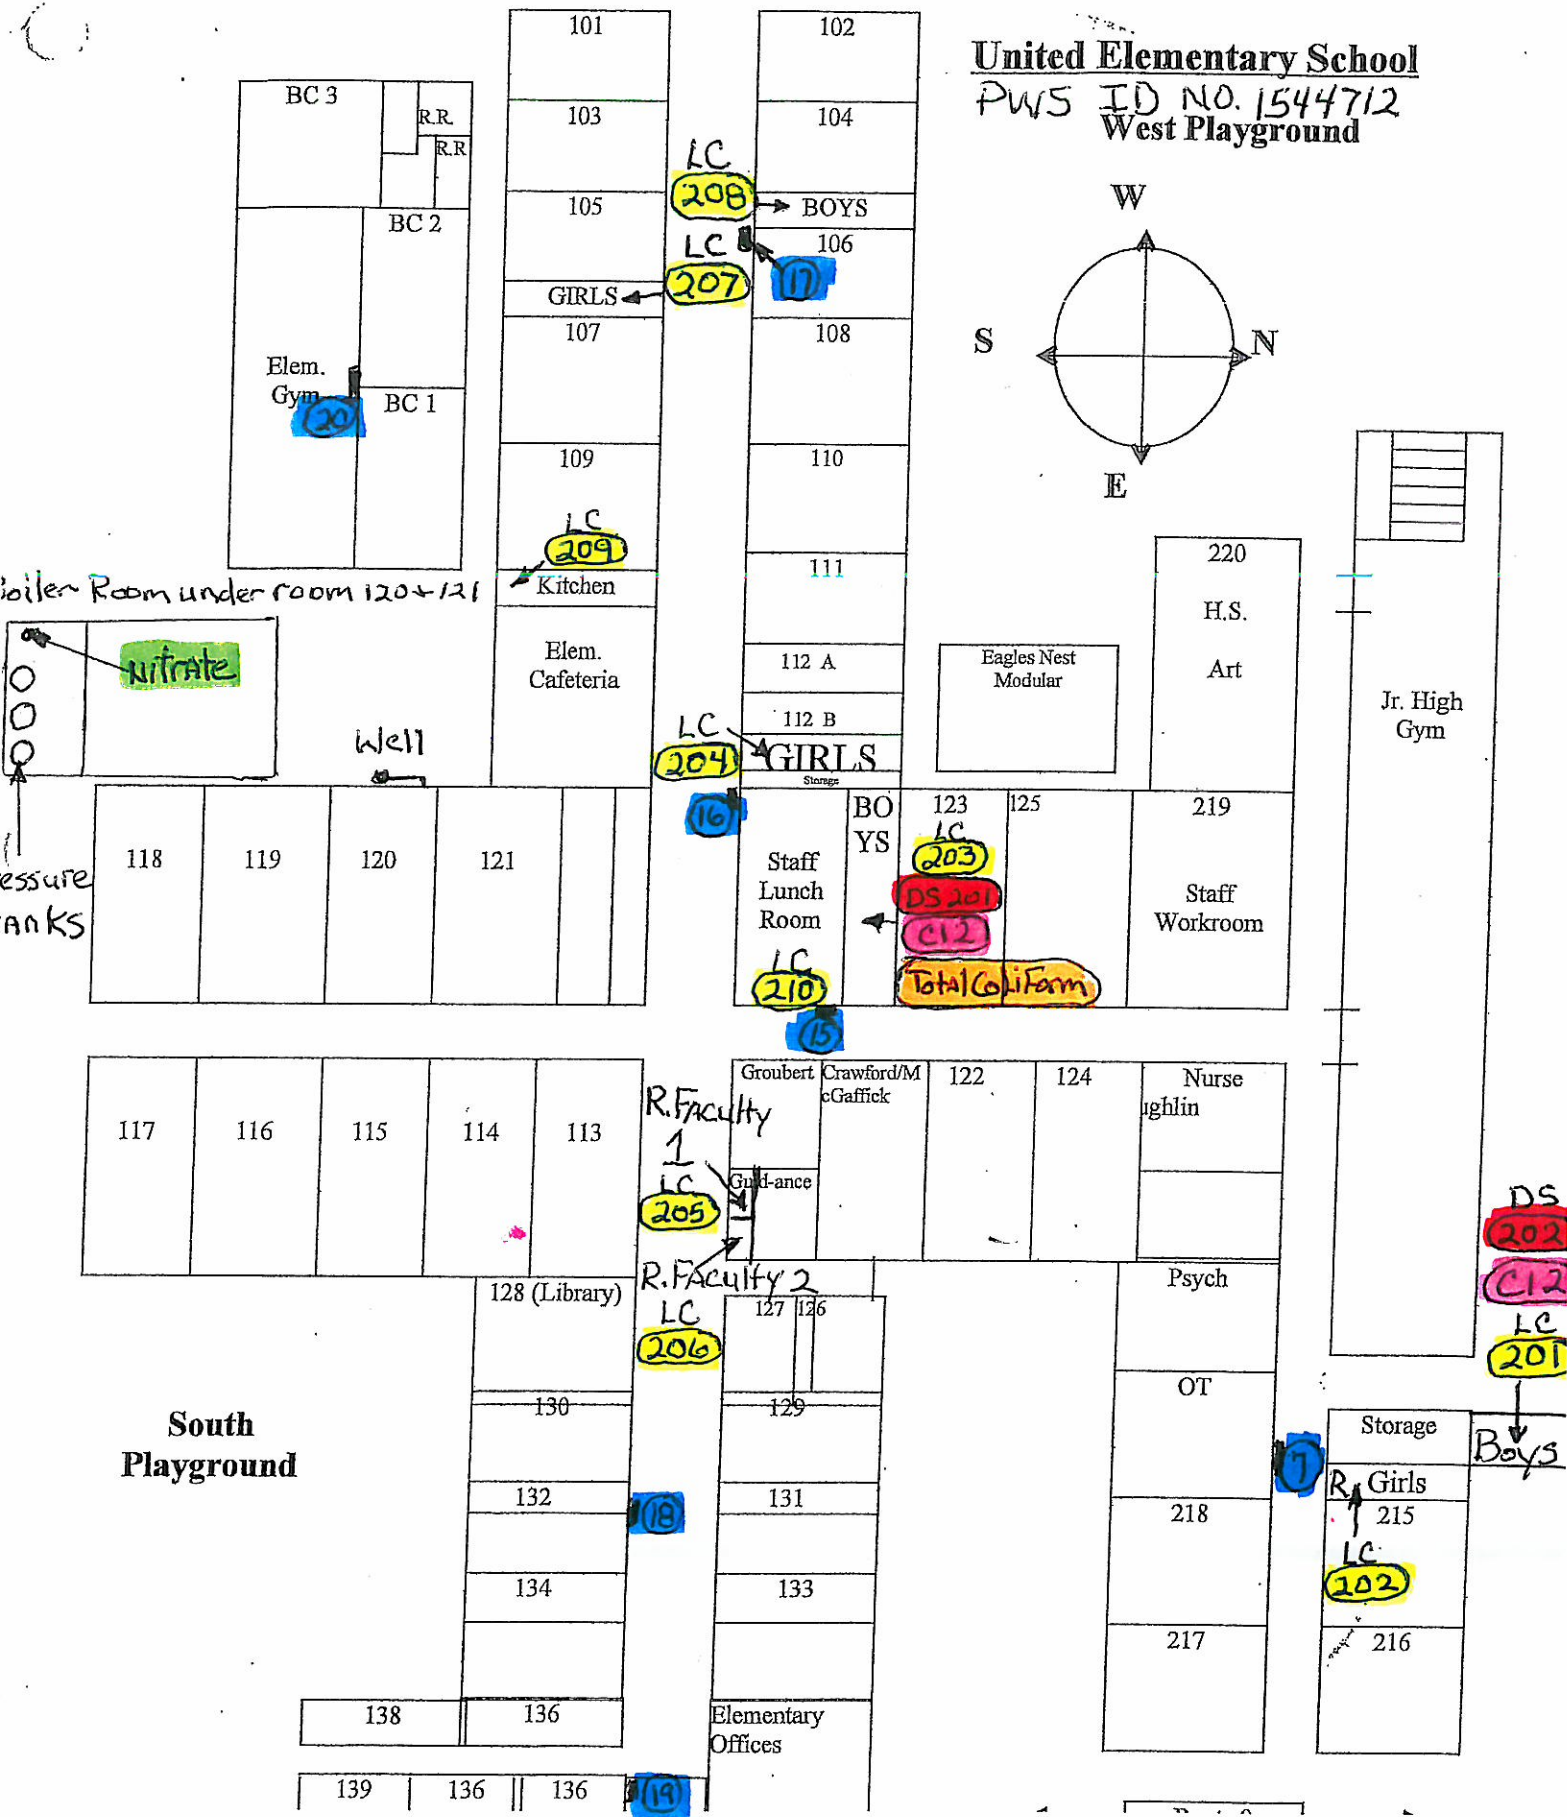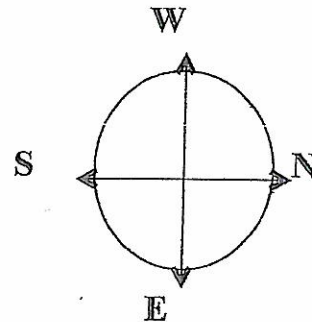

VERIFICATION FORM FOR COMMUNITY PUBLIC WATER SYSTEMS CLAIMING NO LEAD SERVICE LINES

The owner or operator of all community public water systems must identify and map areas of their distribution system that are known or are likely to contain lead service lines. Systems must submit a copy of the applicable map to the Ohio Department of Health and the Ohio Department of Job and Family Services. Systems must also submit a report to the director containing at least both of the following: (1) The applicable map with narrative, and (2) A list of sampling locations used to collect samples as required by Ohio Revised Code (ORC) Section 6109.121 and any rules adopted thereunder, including contact information for the owner and occupant of each sampling site.

Should a water system determine no lead service lines exist in their distribution system, they must provide information stating they reviewed, at the minimum, historical permit records and local ordinances, distribution maintenance records and information pertaining to installation dates or materials for all services lines. This information must be verified below.

I HEREBY CERTIFY THAT THE FOLLOWING METHOD(S) WERE USED TO DETERMINE NO LEAD SERVICE LINES EXIST IN THIS WATER SYSTEM'S DISTRIBUTION SYSTEM, AS REQUIRED BY ORC 6109.121(F):

LEAD SERVICE LINE VERIFICATION
<p>This PWS states they have no lead service lines and has reviewed the following information (select one or more of the following):</p> <ul style="list-style-type: none"> <input type="checkbox"/> Historical permit records and/or local ordinances <input type="checkbox"/> Distribution maintenance records (i.e. meter replacement, waterline break repairs) <input type="checkbox"/> Information pertaining to installation dates for all service lines (i.e. after 1986 when lead services lines were banned) <input checked="" type="checkbox"/> Service line material of all service lines is known (i.e. all service lines are known to be PVC)

	PWS NAME: <i>United Local Elementary School</i> PWS ID: <i>OH 1544712</i> COUNTY: <i>Columbiana</i>
Signature of Responsible Person	
Date <i>Tom Clemens</i>	
<i>Tom Clemens Building Supervisor</i>	
Printed Name and Title of Responsible Person	

Lead Mapping Verification Form Revised 2/14/17



8143 State Route 9 ♦ Hanoverton, Ohio 44423
Phone: (330) 223-1521 ♦ (330) 223-1555
Fax: (330) 223-2363

Direct Numbers:
Elementary School - (330) 223-8001
High School - (330) 223-7102

The following is the map and test locations of United Local School District. The High School and Elementary School are a K-12 campus and are housed in one building. Both the High School and Elementary School have separate well water supply and separate PWS ID Numbers. We test our chlorine levels in in different locations daily. We test the coliform quarterly. All water fountains were tested for lead and copper on February 11, 2016. The test came back ok. The building lead and copper was tested on June 20, 2016. The test came back ok. The Elementary School disinfection by products are tested four times a year. The High School disinfection by products are tested once a year. The nitrate is tested once a year if it is a raw sample. The building entrance supply lines are plastic pvc piping. Below you will find service line verification information:

Because it is practically impossible to determine the lead content of an installed fixture, fitting or pipe, it should be assumed that the manufacture or installation date is the primary indicator of the lead content. Therefore, the characteristics, of building and piping solder or fixtures would be buildings built prior to 1998 or that use plumbing materials or solder manufactured before 1998 may have materials with greater than 8% lead and are at a higher risk of contributing lead to the drinking water than materials manufactured after 1998. In addition, buildings built and plumbing materials manufactured after 2014 were required to have less than 0.25% lead by weight and have the lowest risk for contributing lead to the drinking water. It should be noted however that, although prohibited, some use of leaded solder or leaded components may have occurred after the prohibitions became effective.

If you have any questions, please contact Tom Clemens, Building and Grounds Supervisor at 330-223-2820, cell 234-564-5858, or email me at Tom.Clemens@United.k12.oh.us. United's physical address is 8143 State Route 9, Hanoverton, OH 44423. Or you may also contact our water license holder, Don Harrison at 330-424-8473.

Sincerely,

Tom Clemens, Building and Grounds Supervisor

United Local School District

RECEIVED
MAR 06 2017
OHIO EPA 800