


Allegheny Wesleyan College
 OH 1555012
 2161 Woodside Rd.
 Salem Ohio 44460



possible lead in door, soder and plumbing
 plastic water lines
 40'

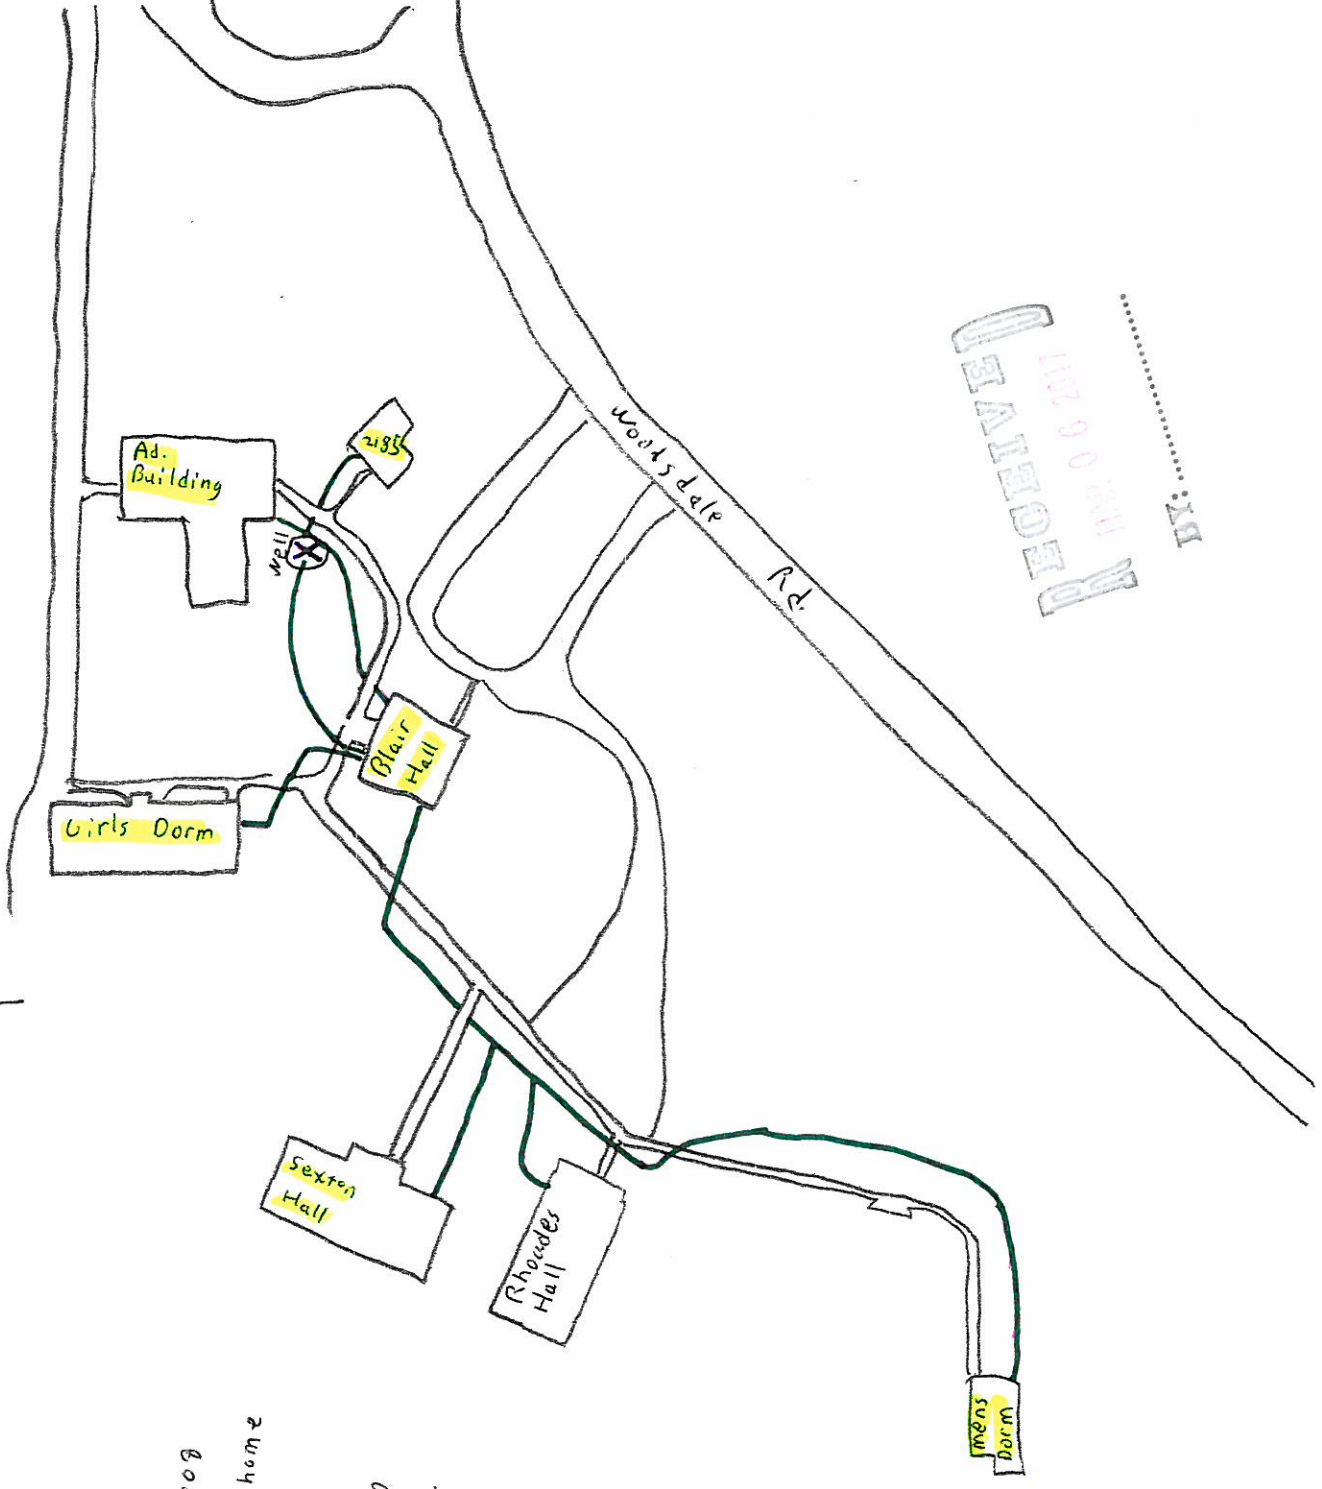

Rhoades Hall plumbing installed in 2008
 Sexton Hall Built in 1977-1998 may have some lead plumbing or soder
 All other buildings built before 1960 and may have lead fixtures
 Blair Hall was replumed in 1978

RECEIVED
 APR 06 2011
 BY: