

3-2-2017

LEAD and Copper Mapping
Ohio Drill + Tool Company
23255 Georgetown Rd
Homeworth Ohio
Columbiana County
OH 1532412

RECEIVED
MAR 03 2017
OHIO EPA NEDO

- (X) 1st Building built in 1950
- (X) Water supply line from well is plastic.
- (X) The water lines in the buildings are Sweated Copper
- (X) The additional addition were all built prior to 1980
- (X) The Small Reverse Osmosis units are for drinking purposes.
- (X) Operator of Record — Tim Hetrick

Entity: Ohio Drill and Tool
 Doc Type: Report
 Doc Subtype: _____
 Program: DDAW
 County: Columbiana
 Secondary ID: OH 15 32412
 EDC in color

OHIO DRILL & TOOL CO. EXIT PLAN



WELL

ASSEMBLY AREA

PARKING LOT


Woman & Men Restroom

Women & Men Restroom

BRAVO

Slop sink

Georgetown Road

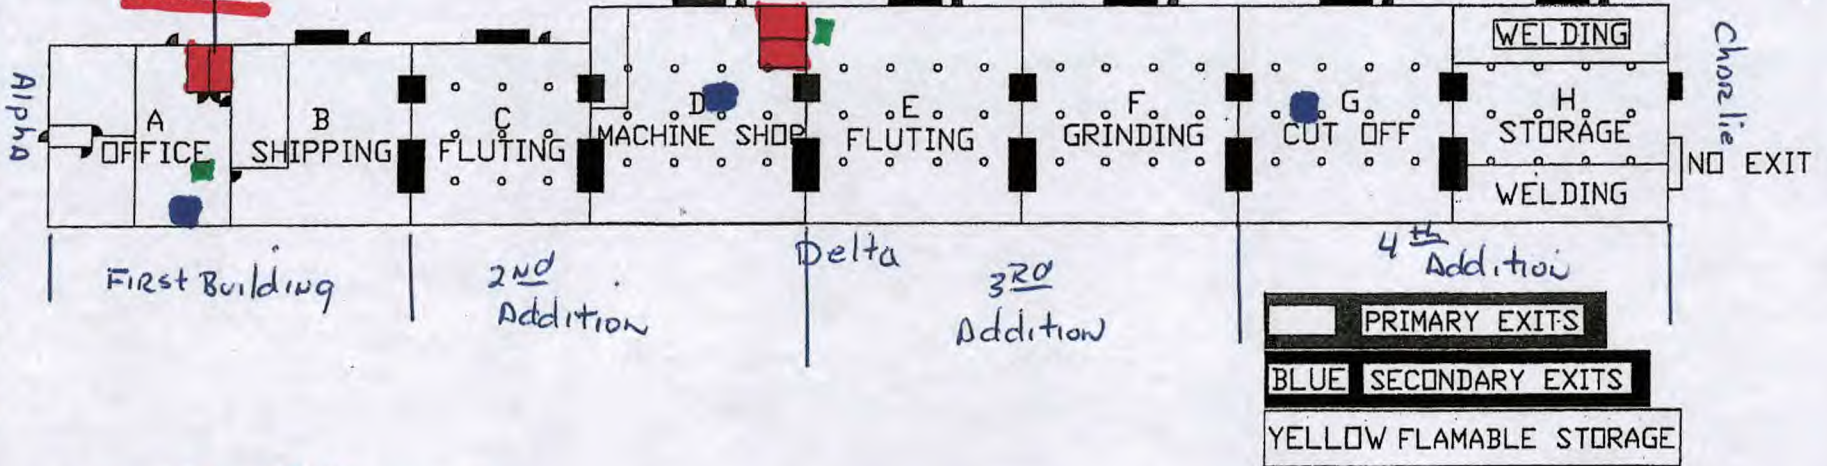

- Restrooms
- Sinks
- Small R.O. units

	PRIMARY EXITS
	SECONDARY EXITS
	FLAMABLE STORAGE