

OH/500811

# City Of EAST LIVERPOOL



## BOARD OF PUBLIC UTILITIES

DIVISION OF WATER  
TELEPHONE 386-4377

110 WEST SIXTH STREET  
P. O. BOX 20

DIVISION OF WASTEWATER  
TELEPHONE 386-5525

### OHIO, U.S.A.

43920

## Lead and Copper mapping for 2017

As stated on the map, we only have 3 units either built or rehabilitated after the year of 2014, they are numbered and listed on the lower right hand side of the map.

These houses are required to have less than 0.25% of lead by weight and have the lowest risk for contributing lead to the drinking water. It should be noted that although prohibited some use of leaded solder or leaded components may have occurred after the prohibitions became effective.


East Liverpool Water Department  
Superintendent  
Robert Wright

Entity: East Liverpool City  
Doc Type: Report  
Doc Subtype: \_\_\_\_\_  
Program: DDAGW  
County: Columbiana  
Secondary ID: OH/500811  
EDOC inc@N

RECEIVED

MAR 02 2017

OHIO EPA NEDO

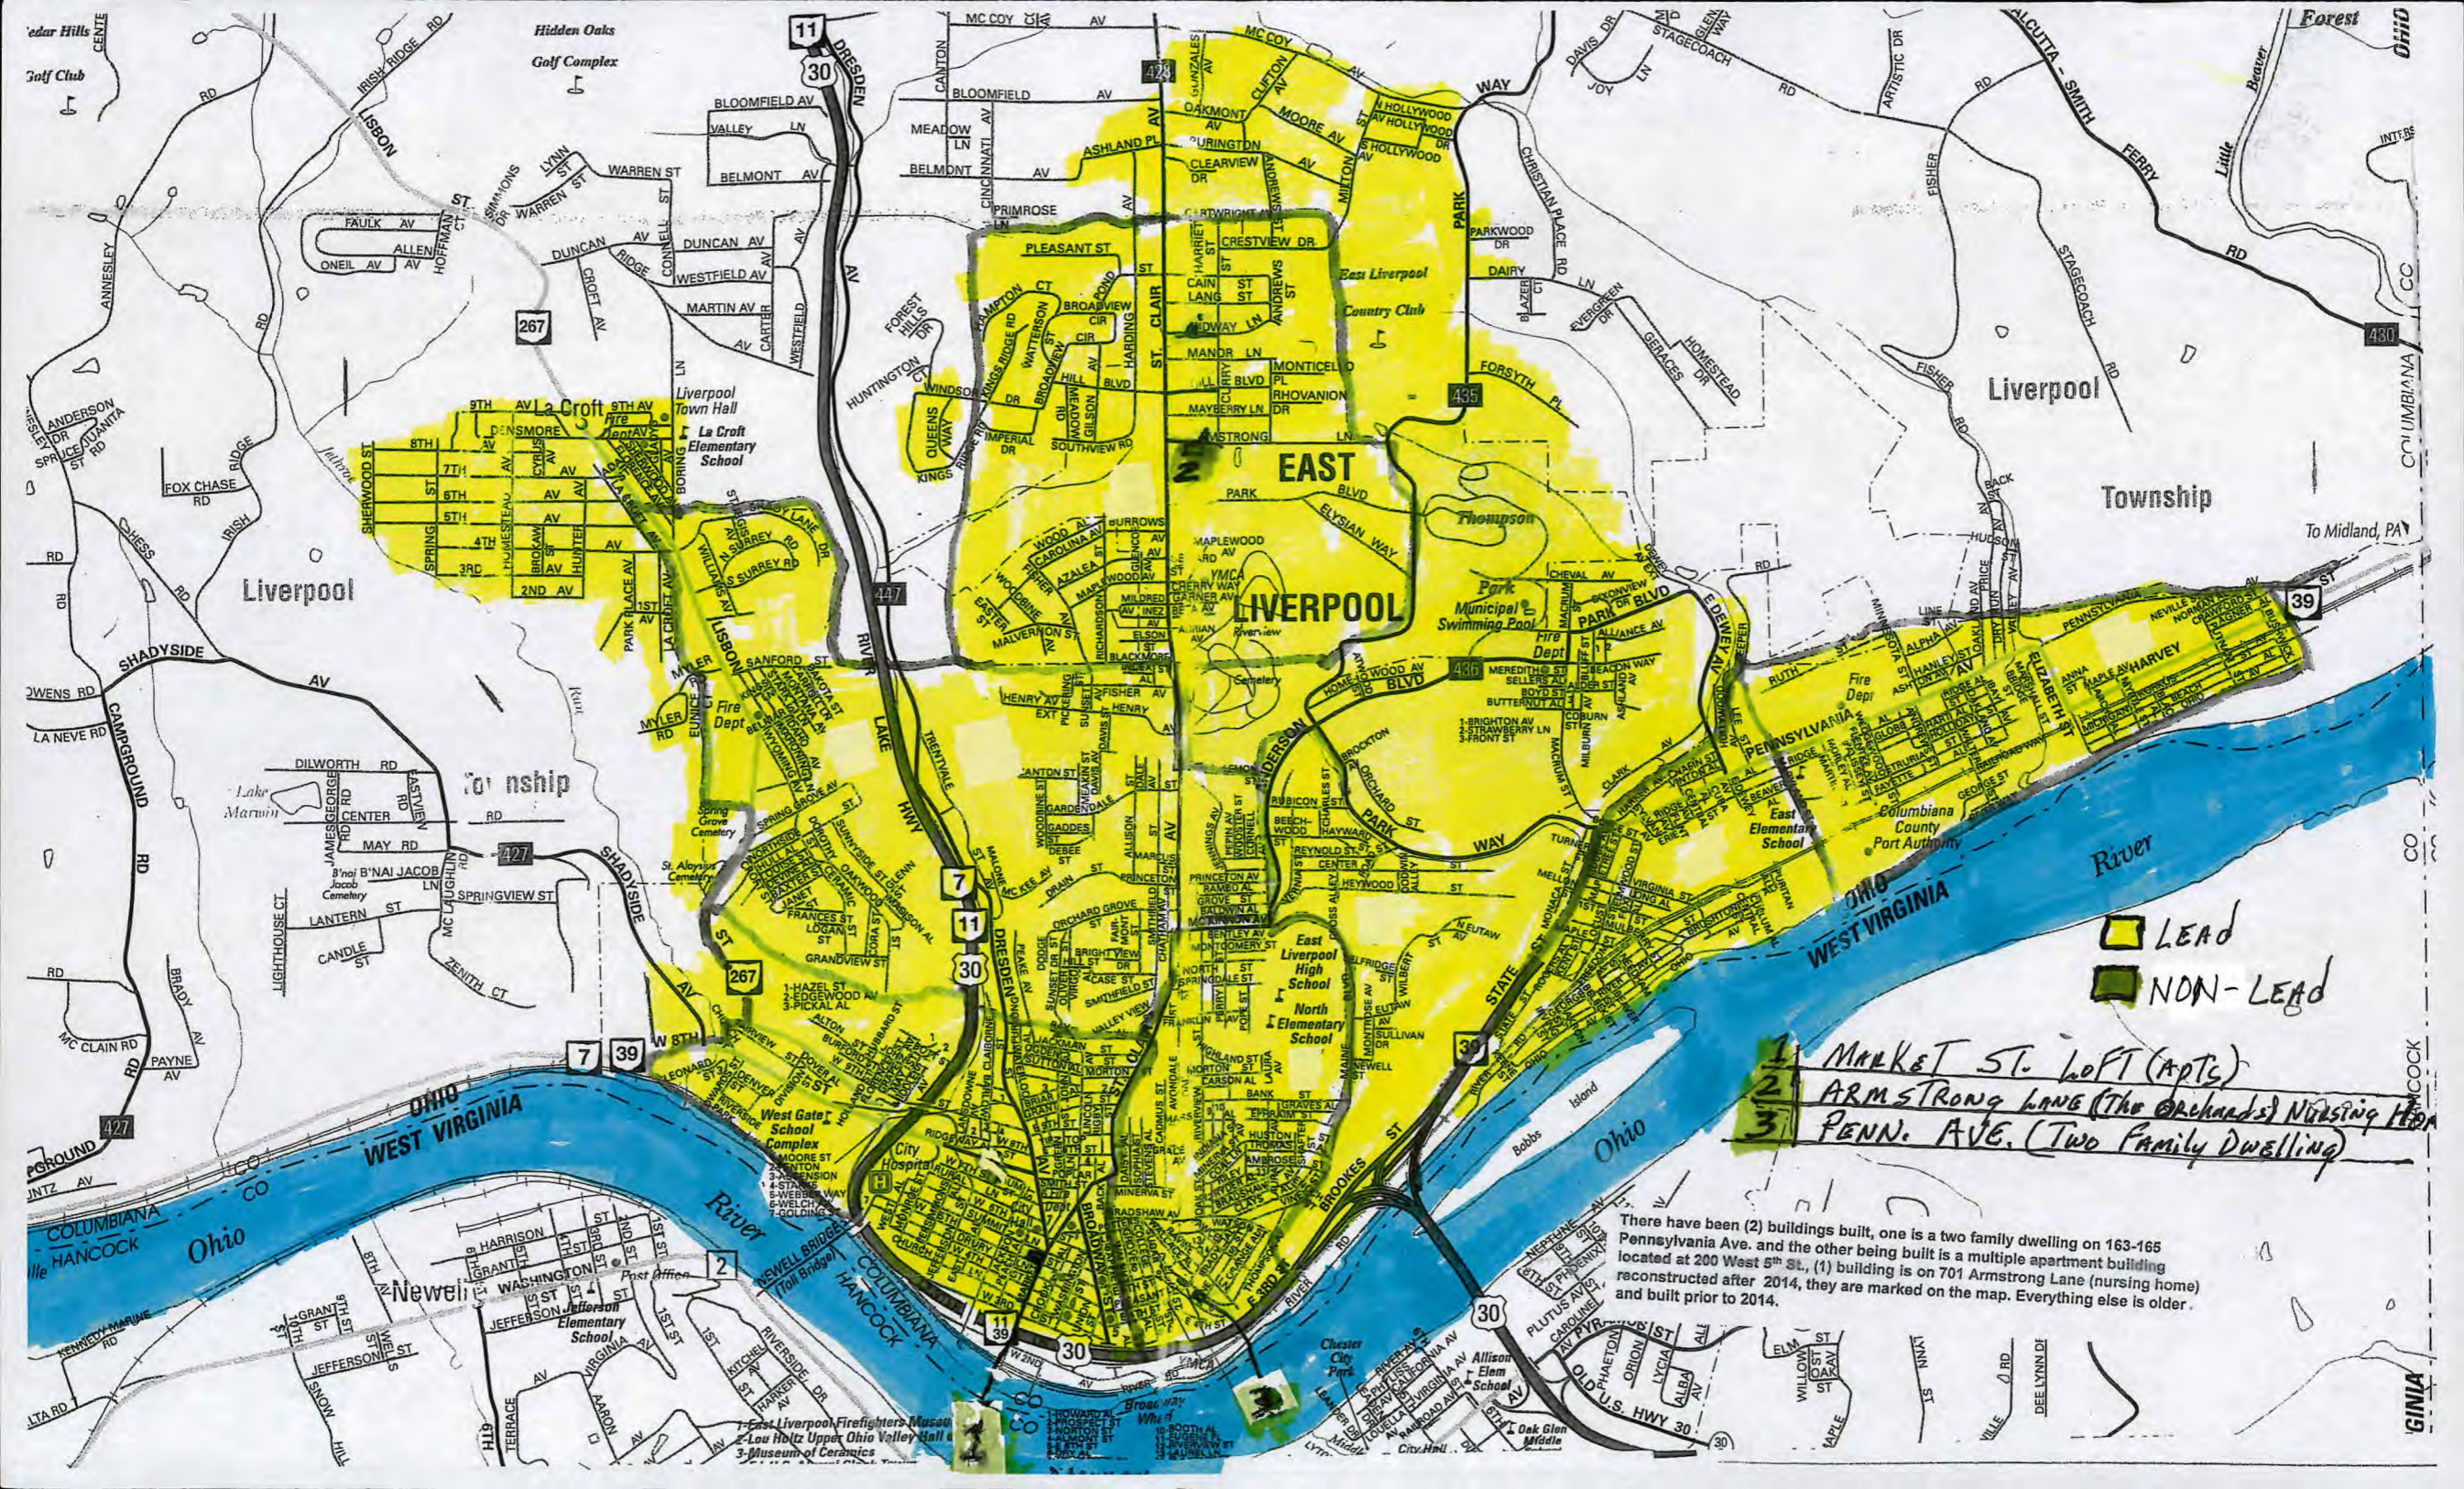

LEAD  
 NON-LEAD

- 1 MARKET ST. LOFT (APTS)
- 2 ARMSTRONG LANE (The Orchard's Nursing Home)
- 3 PENN. AVE. (Two Family Dwelling)

There have been (2) buildings built, one is a two family dwelling on 163-165 Pennsylvania Ave. and the other being built is a multiple apartment building located at 200 West 5th St., (1) building is on 701 Armstrong Lane (nursing home) reconstructed after 2014, they are marked on the map. Everything else is older and built prior to 2014.