

City of London

Subject: lead service line mapping project

Date February 22, 2017



London Water Department

141 W. High st

London ohio 43140


Martin Colwell

London Water department superintendent


Phone # 1-740-852-9656

Buildings in Ohio built prior to 1998 or that use plumbing material or solder manufactured before 1998 may have materials with greater than 8% lead and are at a higher risk of contributing lead to the drinking water than materials manufactured after 1998. In addition, buildings built and plumbing materials manufactured after 2014 were required to have less than 0.25% lead by weight and have the lowest risk for contributing lead to the drinking water. It should be noted however that, although prohibited, some use of leaded solder or leaded components may have occurred after the prohibitions became effective.

Example of Housing Addition
Water Service Line
Built 1980's

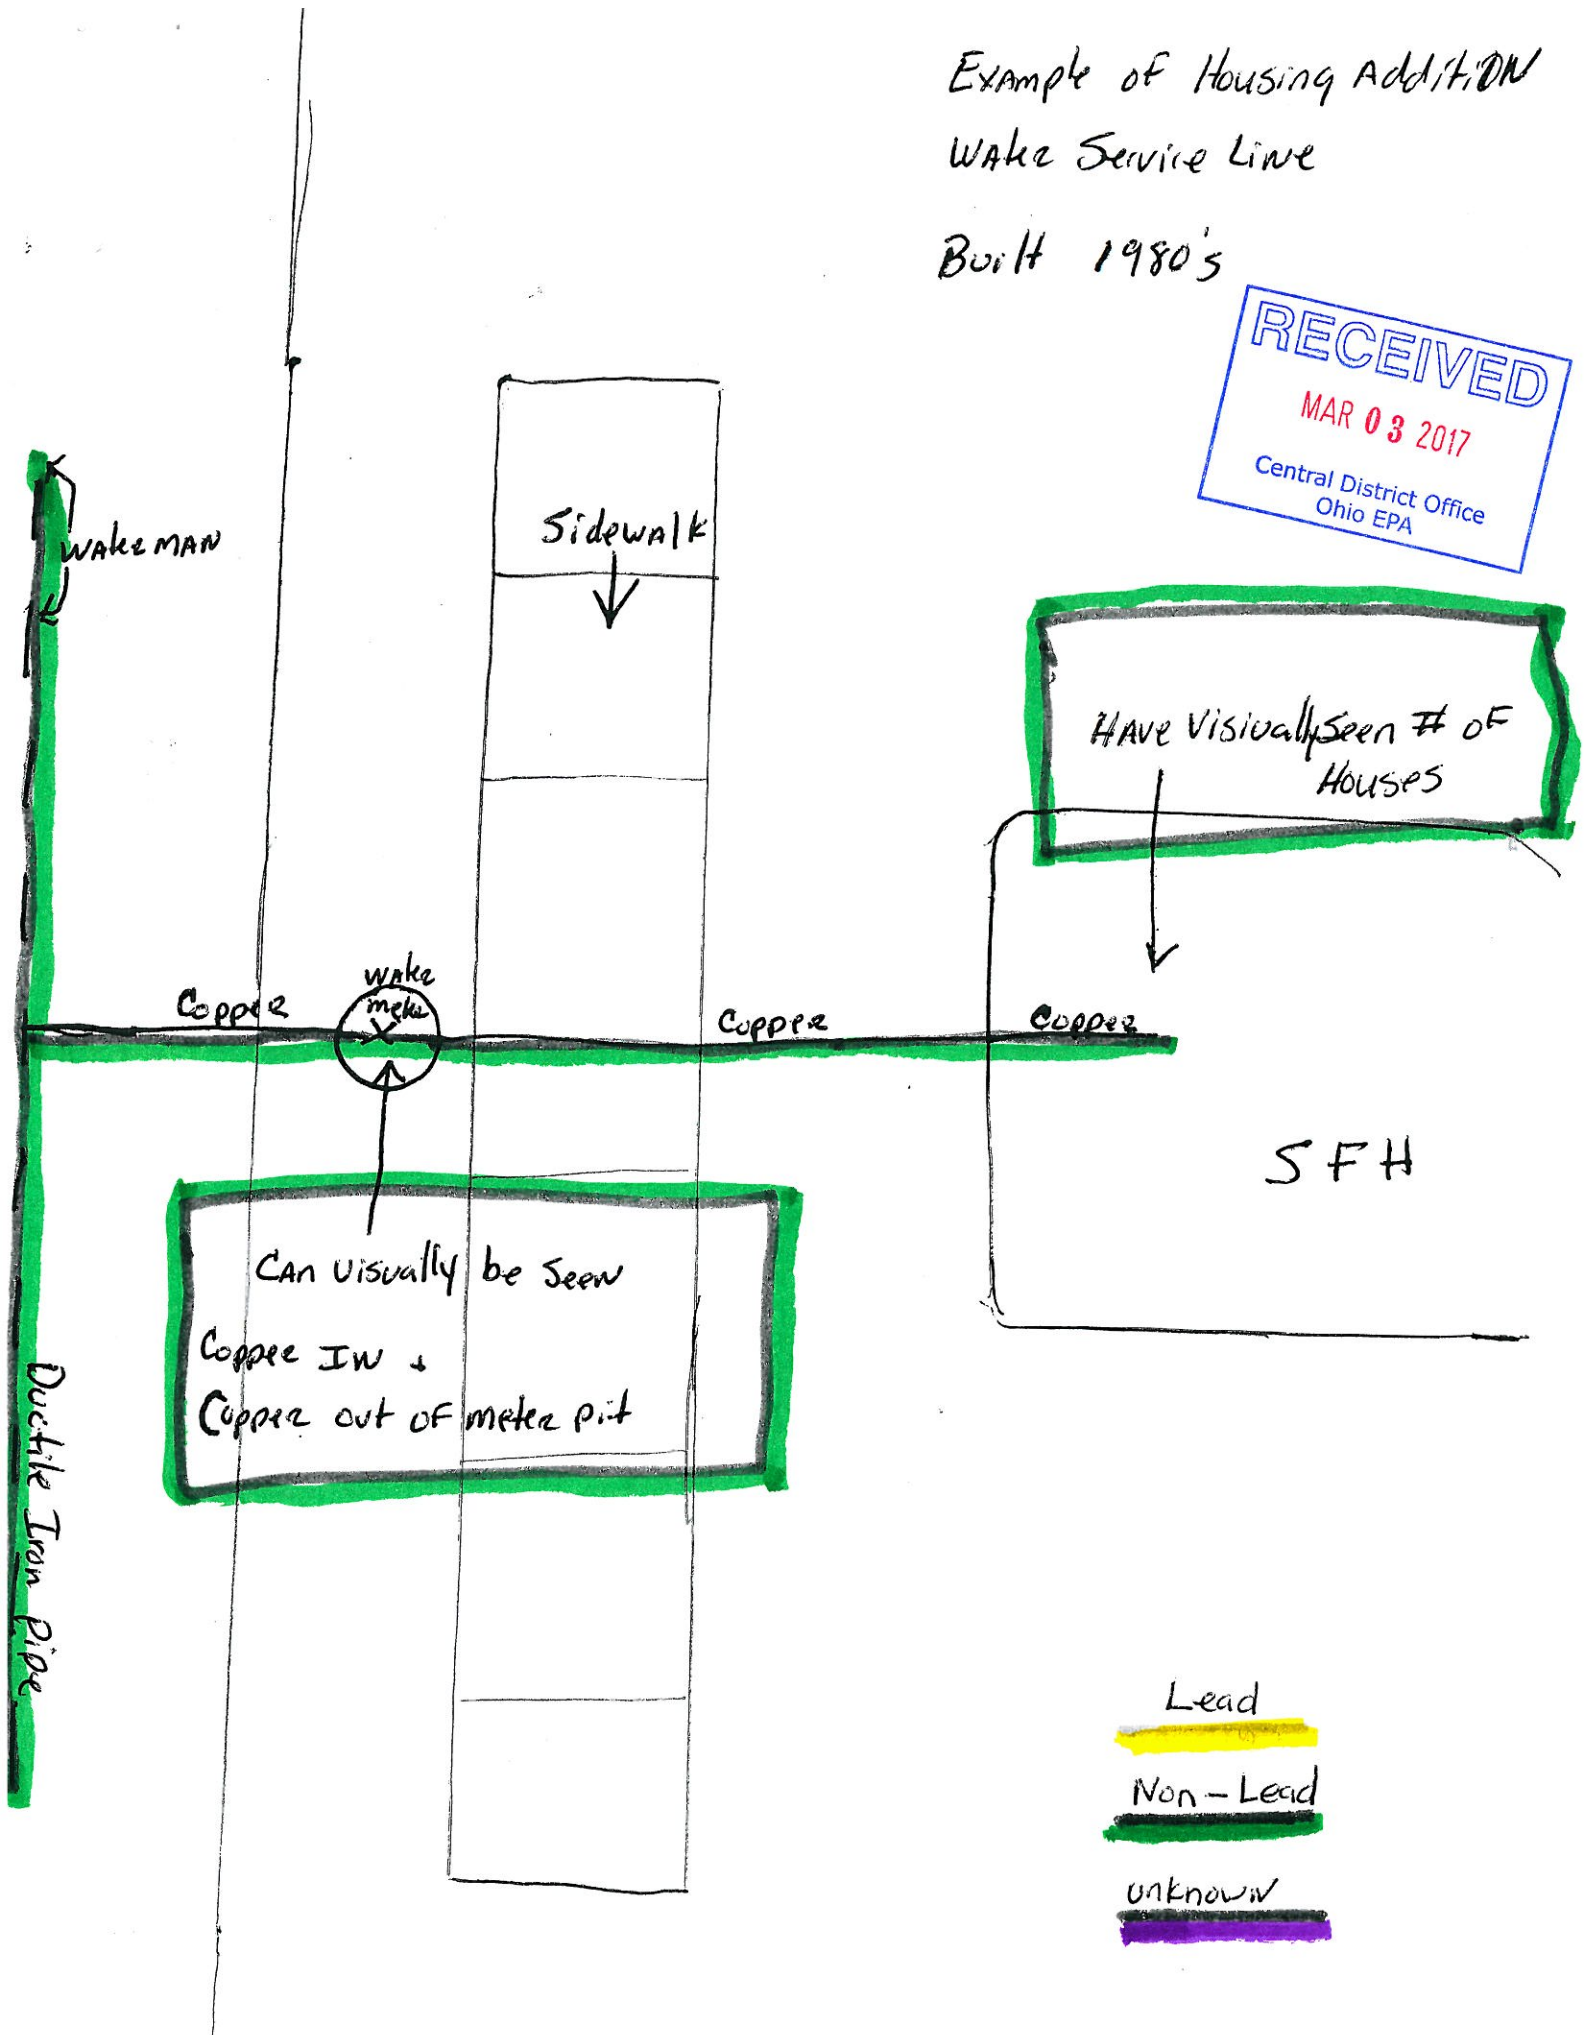

City of London, Ohio
Water System
Grid 10

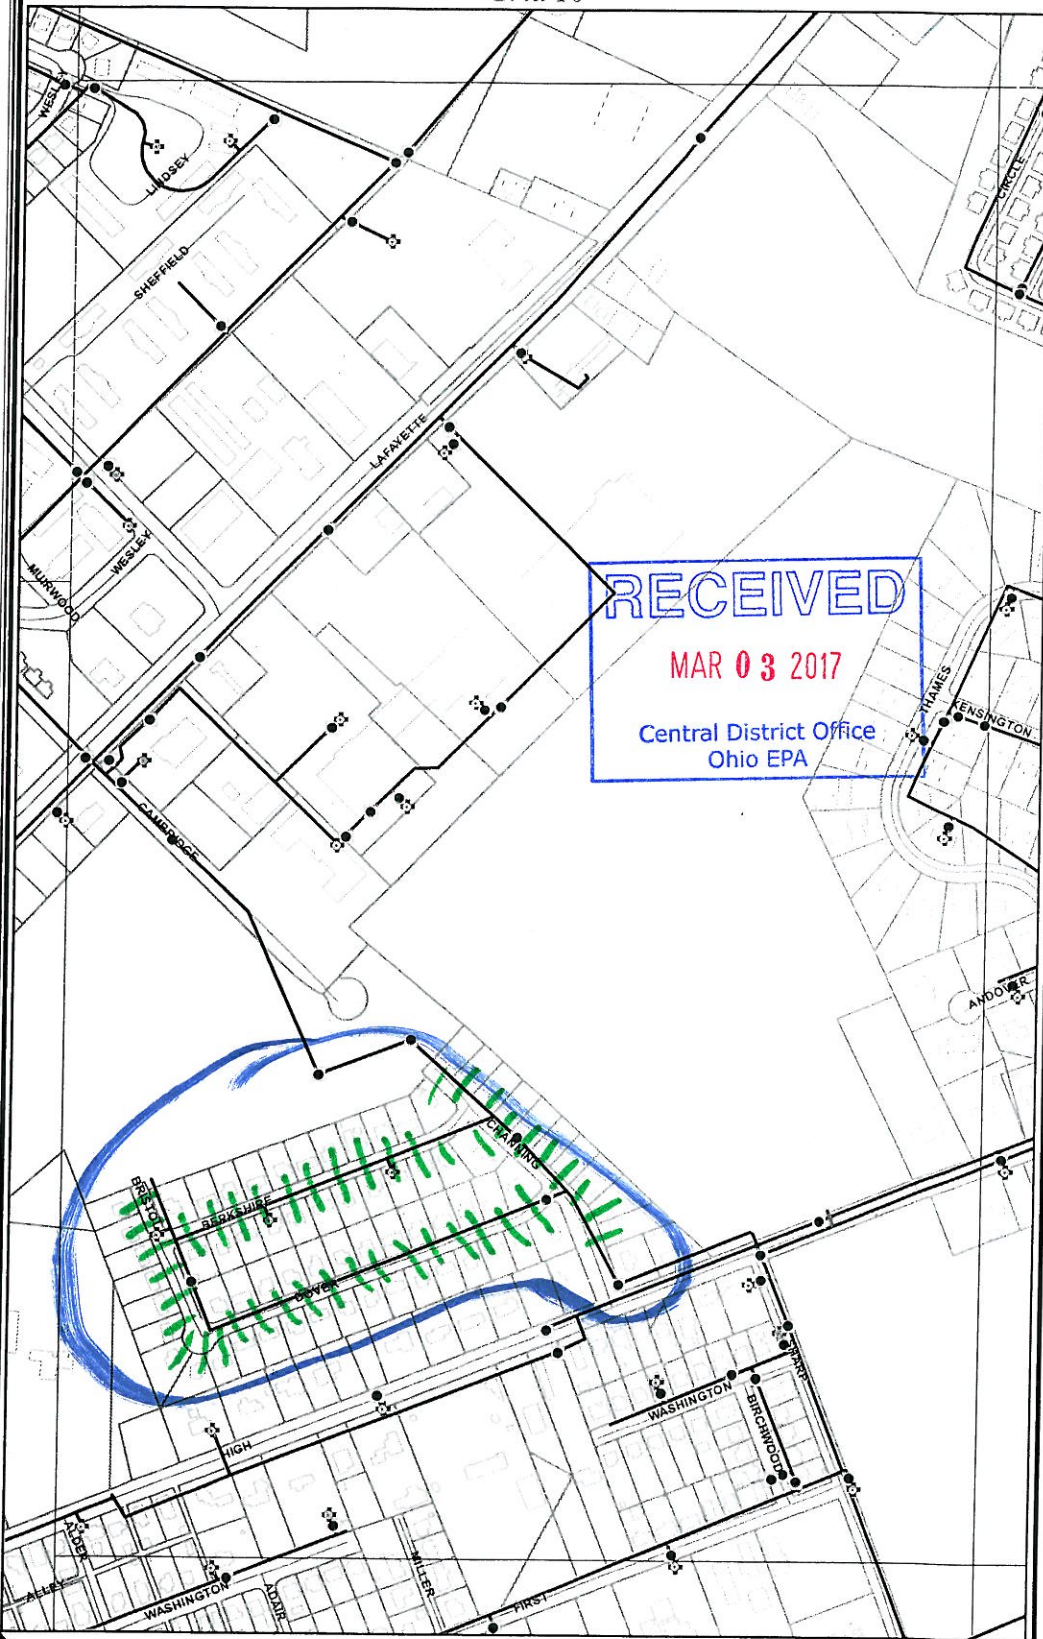

Legend

- Hydrant
- Valve
- Plug
- WTP
- Water Lines
- Corporation Boundary
- Street Centerline
- Stream
- Trails
- Railroad

Lead

Non lead

Unknown



Scale
1:500

Water System
Grid 10
November 15, 2007



RECEIVED

MAR 03 2017

City of London, Ohio

Water System

Grid 11

Central District Office
Ohio EPA

Legend

- Hydrant
- Valve
- Plug
- WTP Water Plant
- Water Lines
- Corporation Boundary
- Street Centerline
- Stream
- Trails
- Railroad

Lead

Non Lead

Un Known



Scale
1:500

Water System

Grid 11

November 15, 2007

