


Second Floor


Entity: North Nimishillen Elem
Doc Type: REPORT
Doc Subtype: _____
Program: DDMSW
County: STARK
Secondary ID: 047639412

North Nimishillen School
Louisville, Ohio 44641
(OH 7639412)

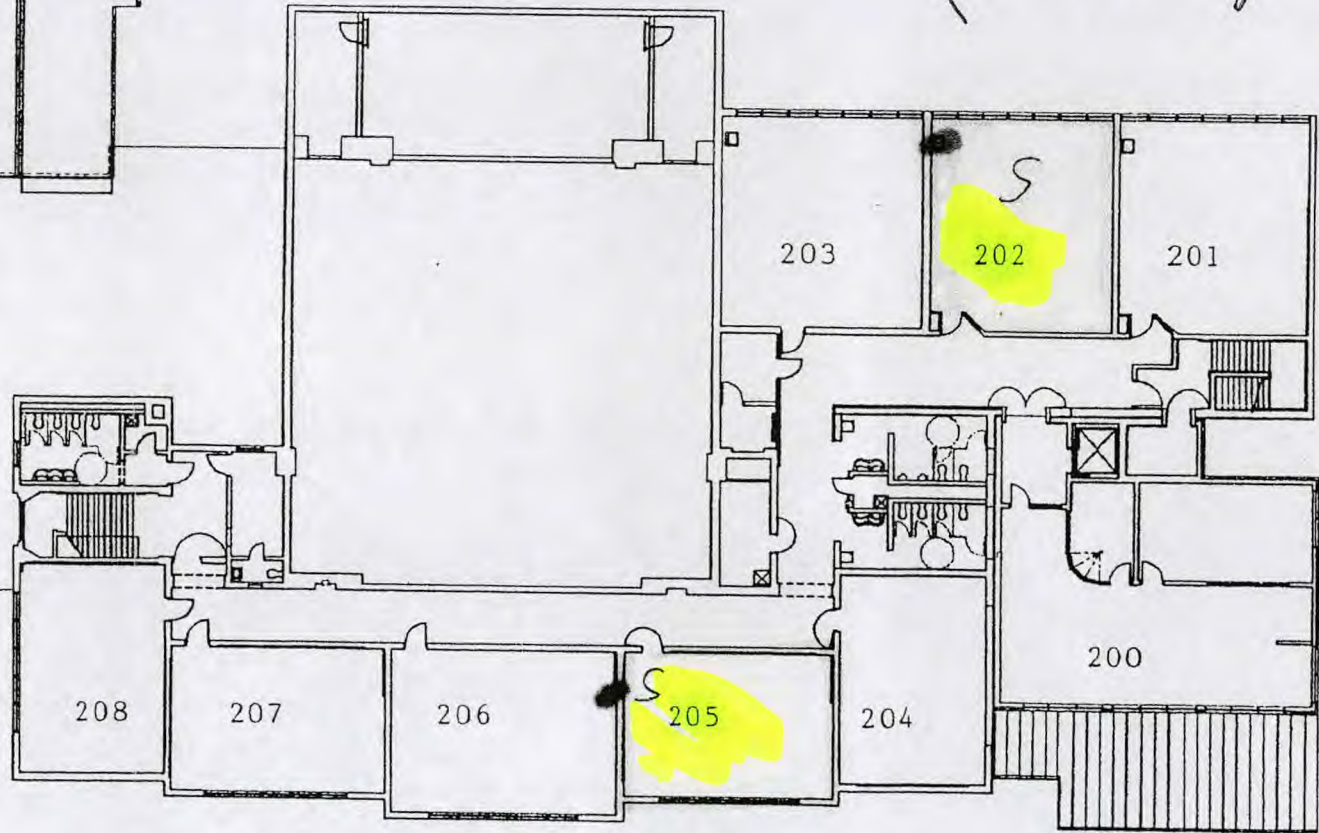

RECEIVED
MAR 07 2017

BY:

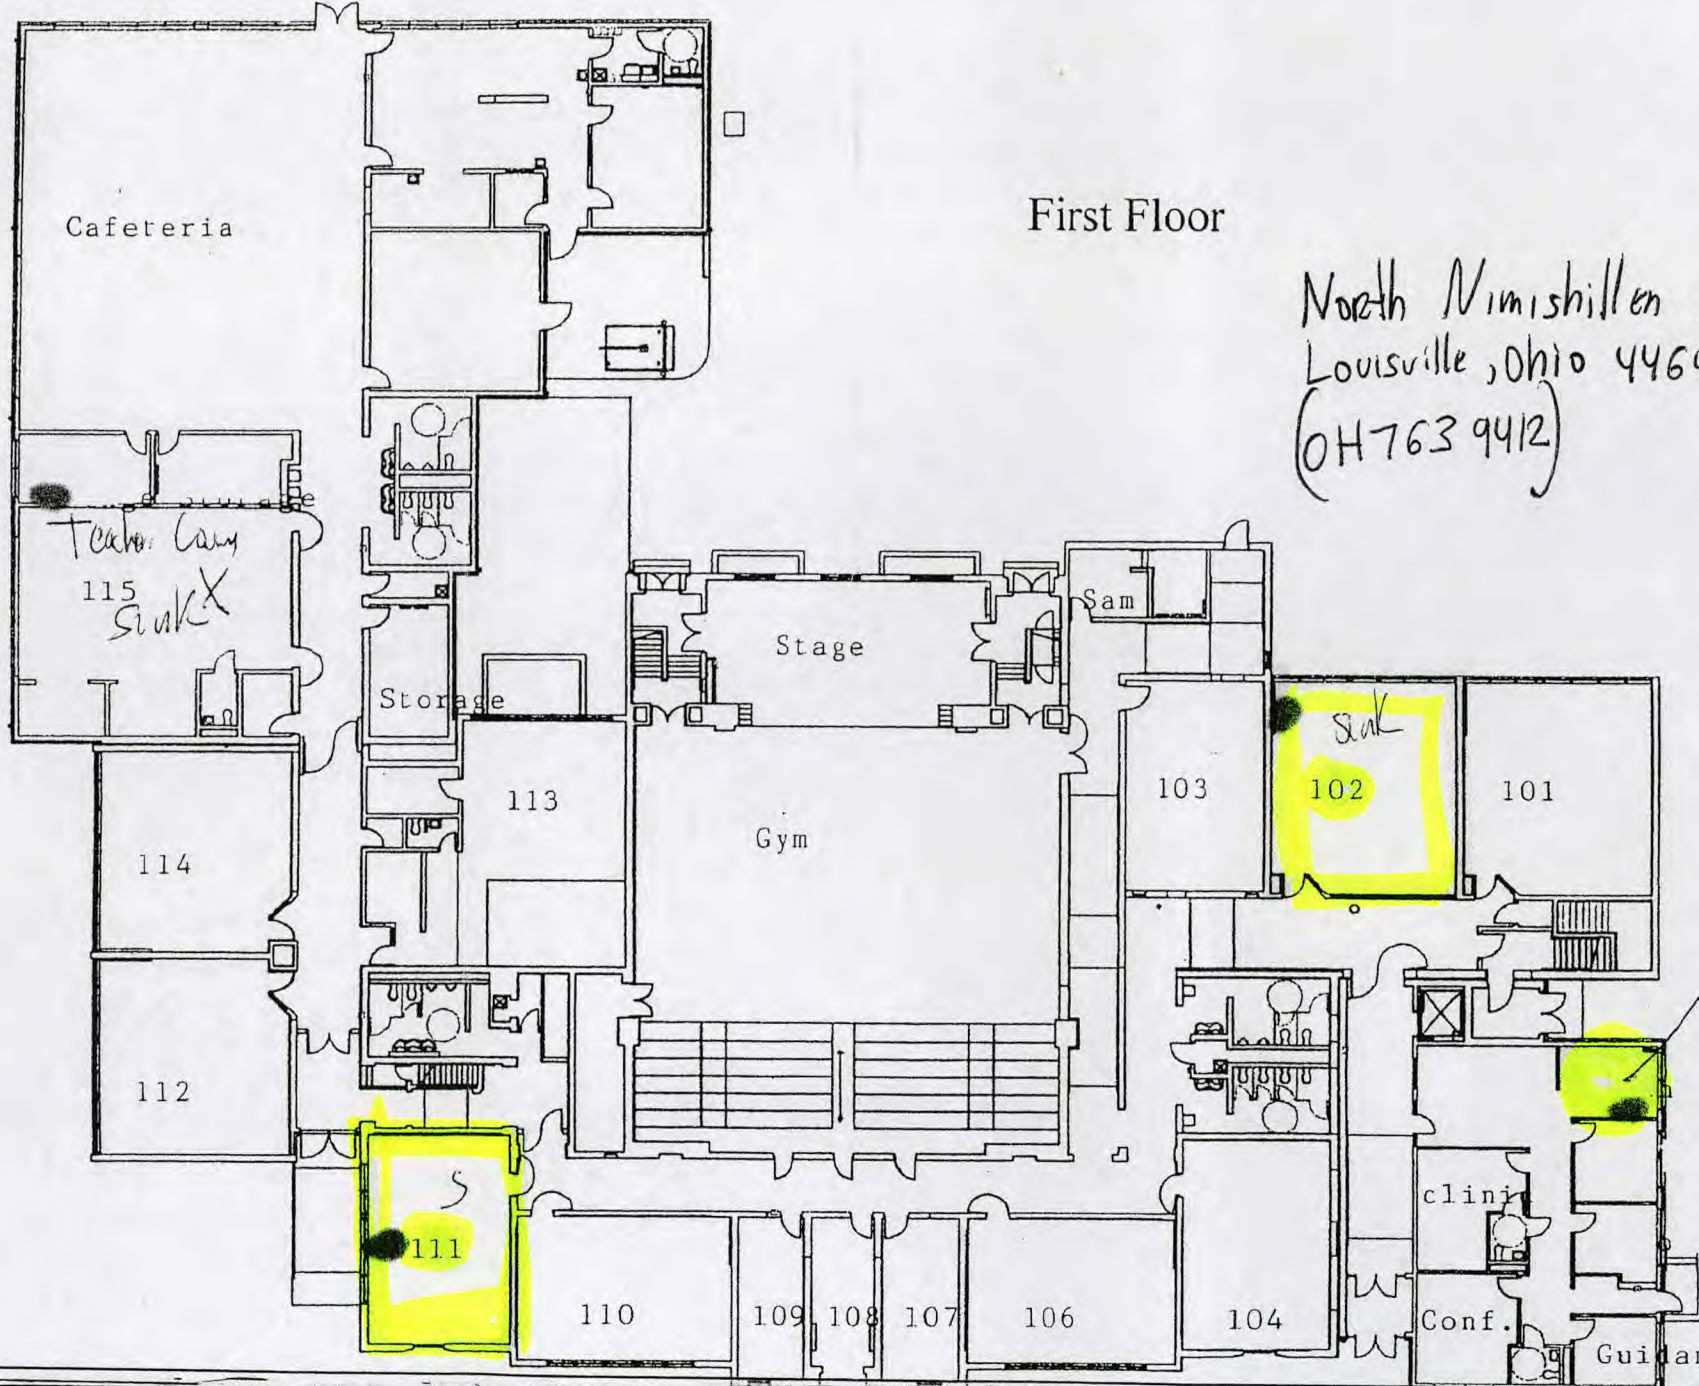

First Floor

North Nimishillen school
Louisville, Ohio 44641
(OH 763 9412)

Cafeteria

Teacher's Lounge
115
Sink

Storage

Stage

Sam

Sink

114

113

Gym

103

102

101

112

111

Main office sink

clini

110

109

108

107

106

104

Conf.

Guidance