

Custom Poly Bag, Inc
9465 Edison Street N.E.
Alliance, Ohio 44601
1-330-935-2408 – Phone
1-330-935-2400 – Fax
rheppe@custompolybag.com



Fax

To: _____ From: Ron Heppe
Fax: _____ Pages: 2
Phone: _____ Date: 3-3-17
Re: Lead Mapping CC: _____

Urgent For Review Please Comment Please Reply Please Recycle

Sampling Locations Tier 1


- Drinking Fountain W+H Bay
- Drinking Fountain PCMC Bay
- Drinking Fountain Printing Bay
- Drinking Fountain Converting
- UniSex Rest Room

RECEIVED
MAR 07 2017
OHIO EPA NEDO

Entity: Custom Poly Bag
Doc Type: REPORT
Doc Subtype: _____
Program: _____
County: STARK
Secondary ID: 047674312

Ronald Heppe

RECEIVED
 MAR 07 2017
 OHIO EPA NEDO

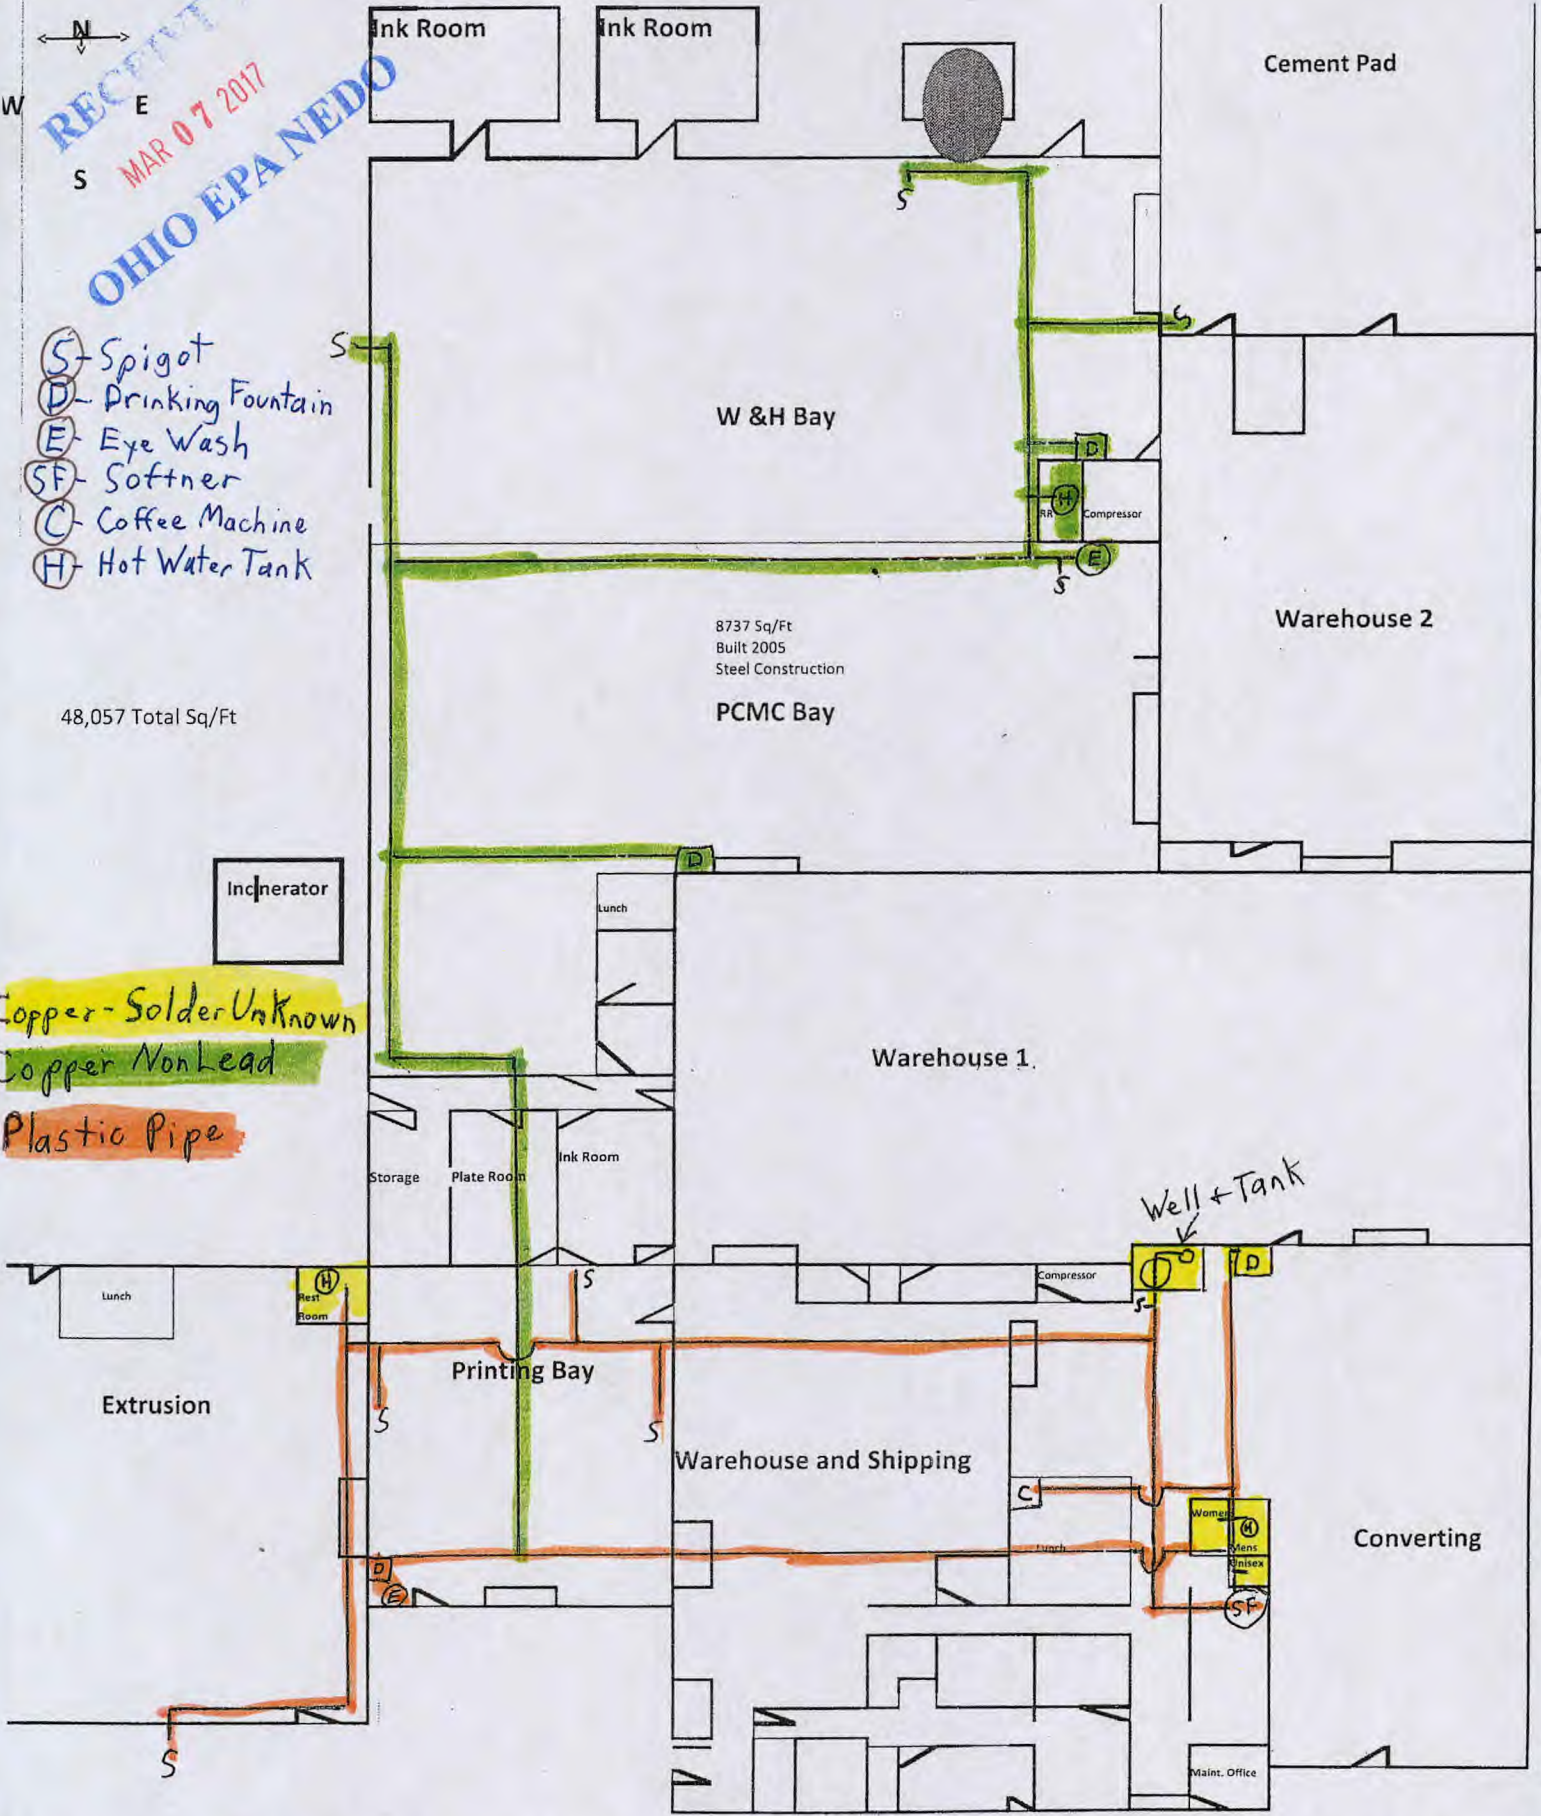

Custom Poly Bag Inc. 9465 Edison St. NE. Alliance OH. 330-935-2408
 OH 7674312