

Chem-Tech[®] Consultants, Inc.

Environmental Engineering & Safety Compliance



March 4, 2017

Ohio EPA
Northeast District Office
2110 East Aurora Road
Twinsburg, Ohio 44087

RE: *Lead Mapping*

Enclosed is the lead map and sample site list for Magni-Power Company in Wayne County. If you have any questions or concerns, please don't hesitate to call.

Sincerely,

Chem-Tech Consultants, Inc.

Nathaniel D. Hoam
EHS Compliance Officer


Entity: Magni-Power
Doc Type: Report
Doc Subtype: _____
Program: DDAGW
County: Wayne
Secondary ID: 26854B12

RECEIVED

MAR 07 2017

OHIO EPA NEDO

PWS OH8541312

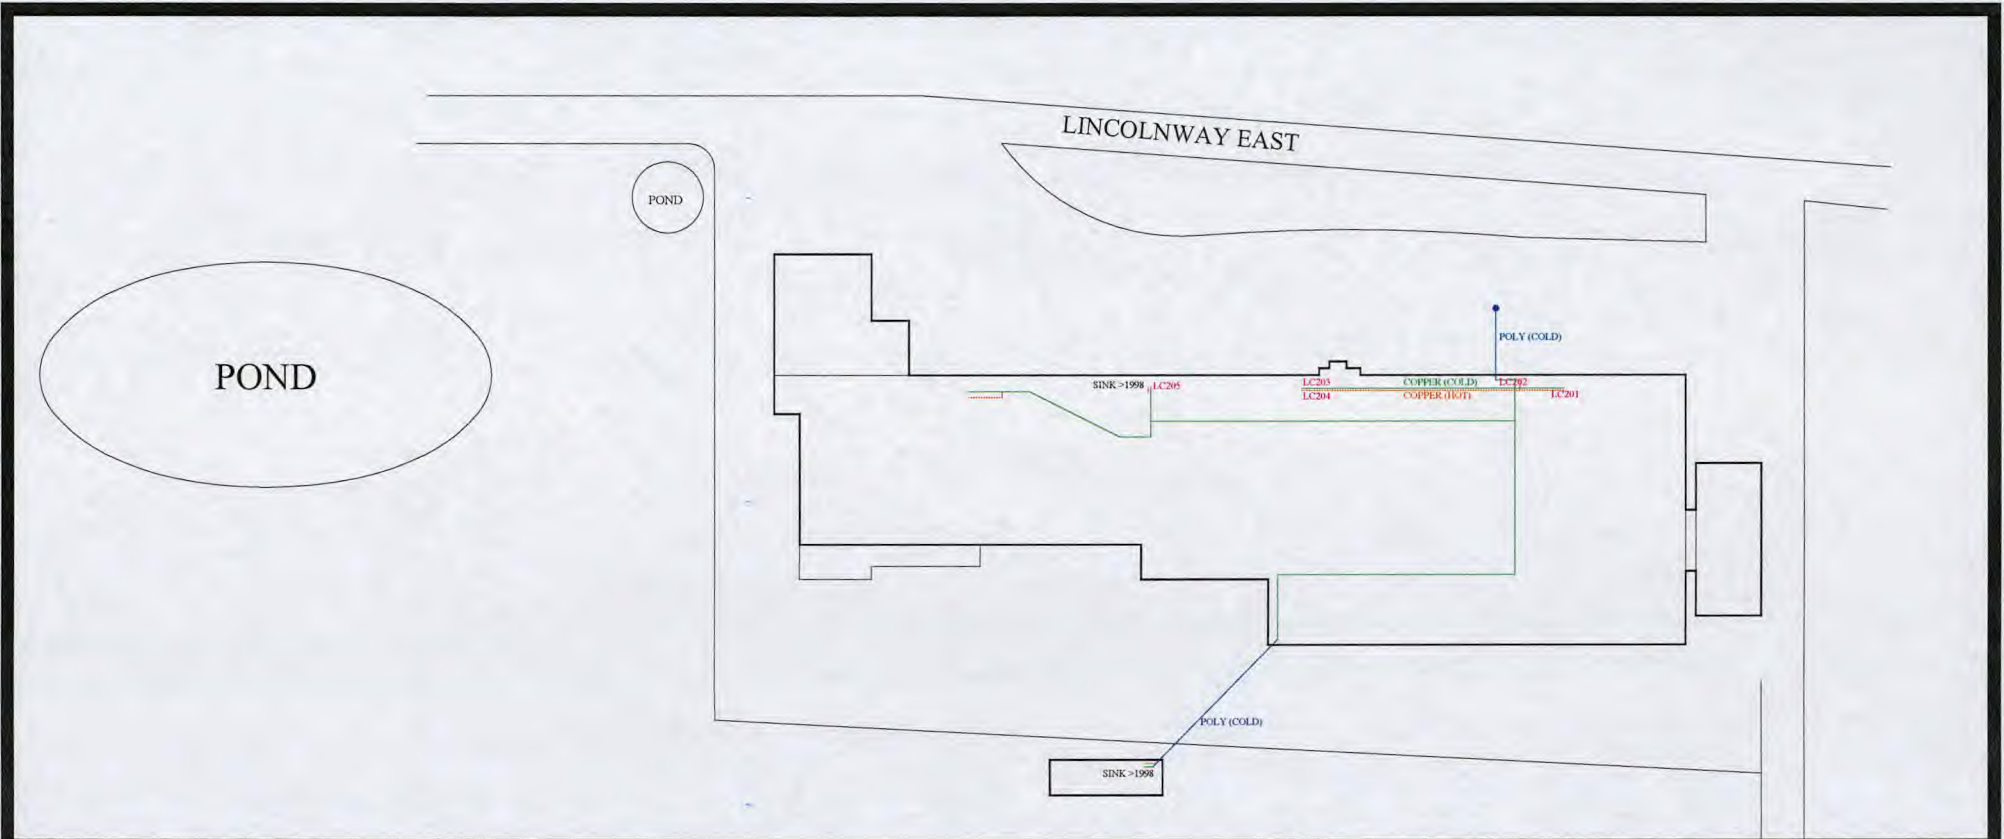

LEGEND

COPPER LINES HAVE POSSIBILITY OF LEAD SOLDER PRE 1998

- COPPER LINE POSSIBLE LEAD SOLDER
- POLY (COLD) LINE NO LEAD SOLDER
- COPPER (HOT) LINE POSSIBLE LEAD SOLDER

- LC201 - LADIES EAST RESTROOM
- LC202 - FURNACE ROOM
- LC203 - MENS RESTROOM
- LC204 - LADIES OFFICE RESTROOM
- LC205 - CONFERENCE ROOM FOUNTAIN

Buildings in Ohio built prior to 1998 or that use plumbing or solder manufactured before 1998 may have materials with greater than 8% lead and are at a higher risk of contributing lead to the drinking water than materials manufactured after 1998. In addition, buildings built and plumbing materials manufactured after 2014 were required to have less than 0.25% lead by weight and have the lowest risk for contributing lead to the drinking water. It should be noted however that, although prohibited, some use of leaded solder or leaded components may have occurred after the prohibition became effective.



LEAD MAP

Magni-Power Company
 5511 Lincoln Highway East
 Wooster, Ohio 44691

PREPARED BY:

Chem-Tech Consultants, Inc.
 Chemical & Environmental Eng.

RECEIVED
 March 4, 2017

MAR 07 2017

OHIO EPA NEDO